

08-00-099-000-005
 08-00-100-000-020
 8 B Scan# 485666


PLAT OF SURVEY
 FOR
THE HEIRS OF
ANNA HORVATH

SITUATED IN THE TOWNSHIP OF HENRIETTA,
 COUNTY OF LORAIN AND STATE OF OHIO
 AND KNOWN AS BEING PART OF ORIGINAL
 HENRIETTA TOWNSHIP LOT NOS. 94, 99 AND 100.

PARCEL NOS 8-00-099-000-005 AND
 8-00-100-000-020
 TOTAL AREA = 57.6766 AS

DISTANCES ARE GIVEN IN FEET AND DECIMAL PARTS
 THEREOF. BEARINGS ARE BASED ON AN ASSUMED
 MERIDIAN AND ARE GIVEN FOR THE PURPOSE OF
 DESCRIBING ANGLES ONLY. MONUMENTS WERE
 FOUND OR SET AT ALL POINTS INDICATED ALL
 OF WHICH I CERTIFY TO BE CORRECT BASED
 ON MY PROFESSIONAL KNOWLEDGE INFORMATION
 AND BELIEF. CERTIFIED COPIES ARE ONLY
 THOSE SIGNED IN RED INK.

RICHARD ROSEBECK
 SURVEYOR N# 7400

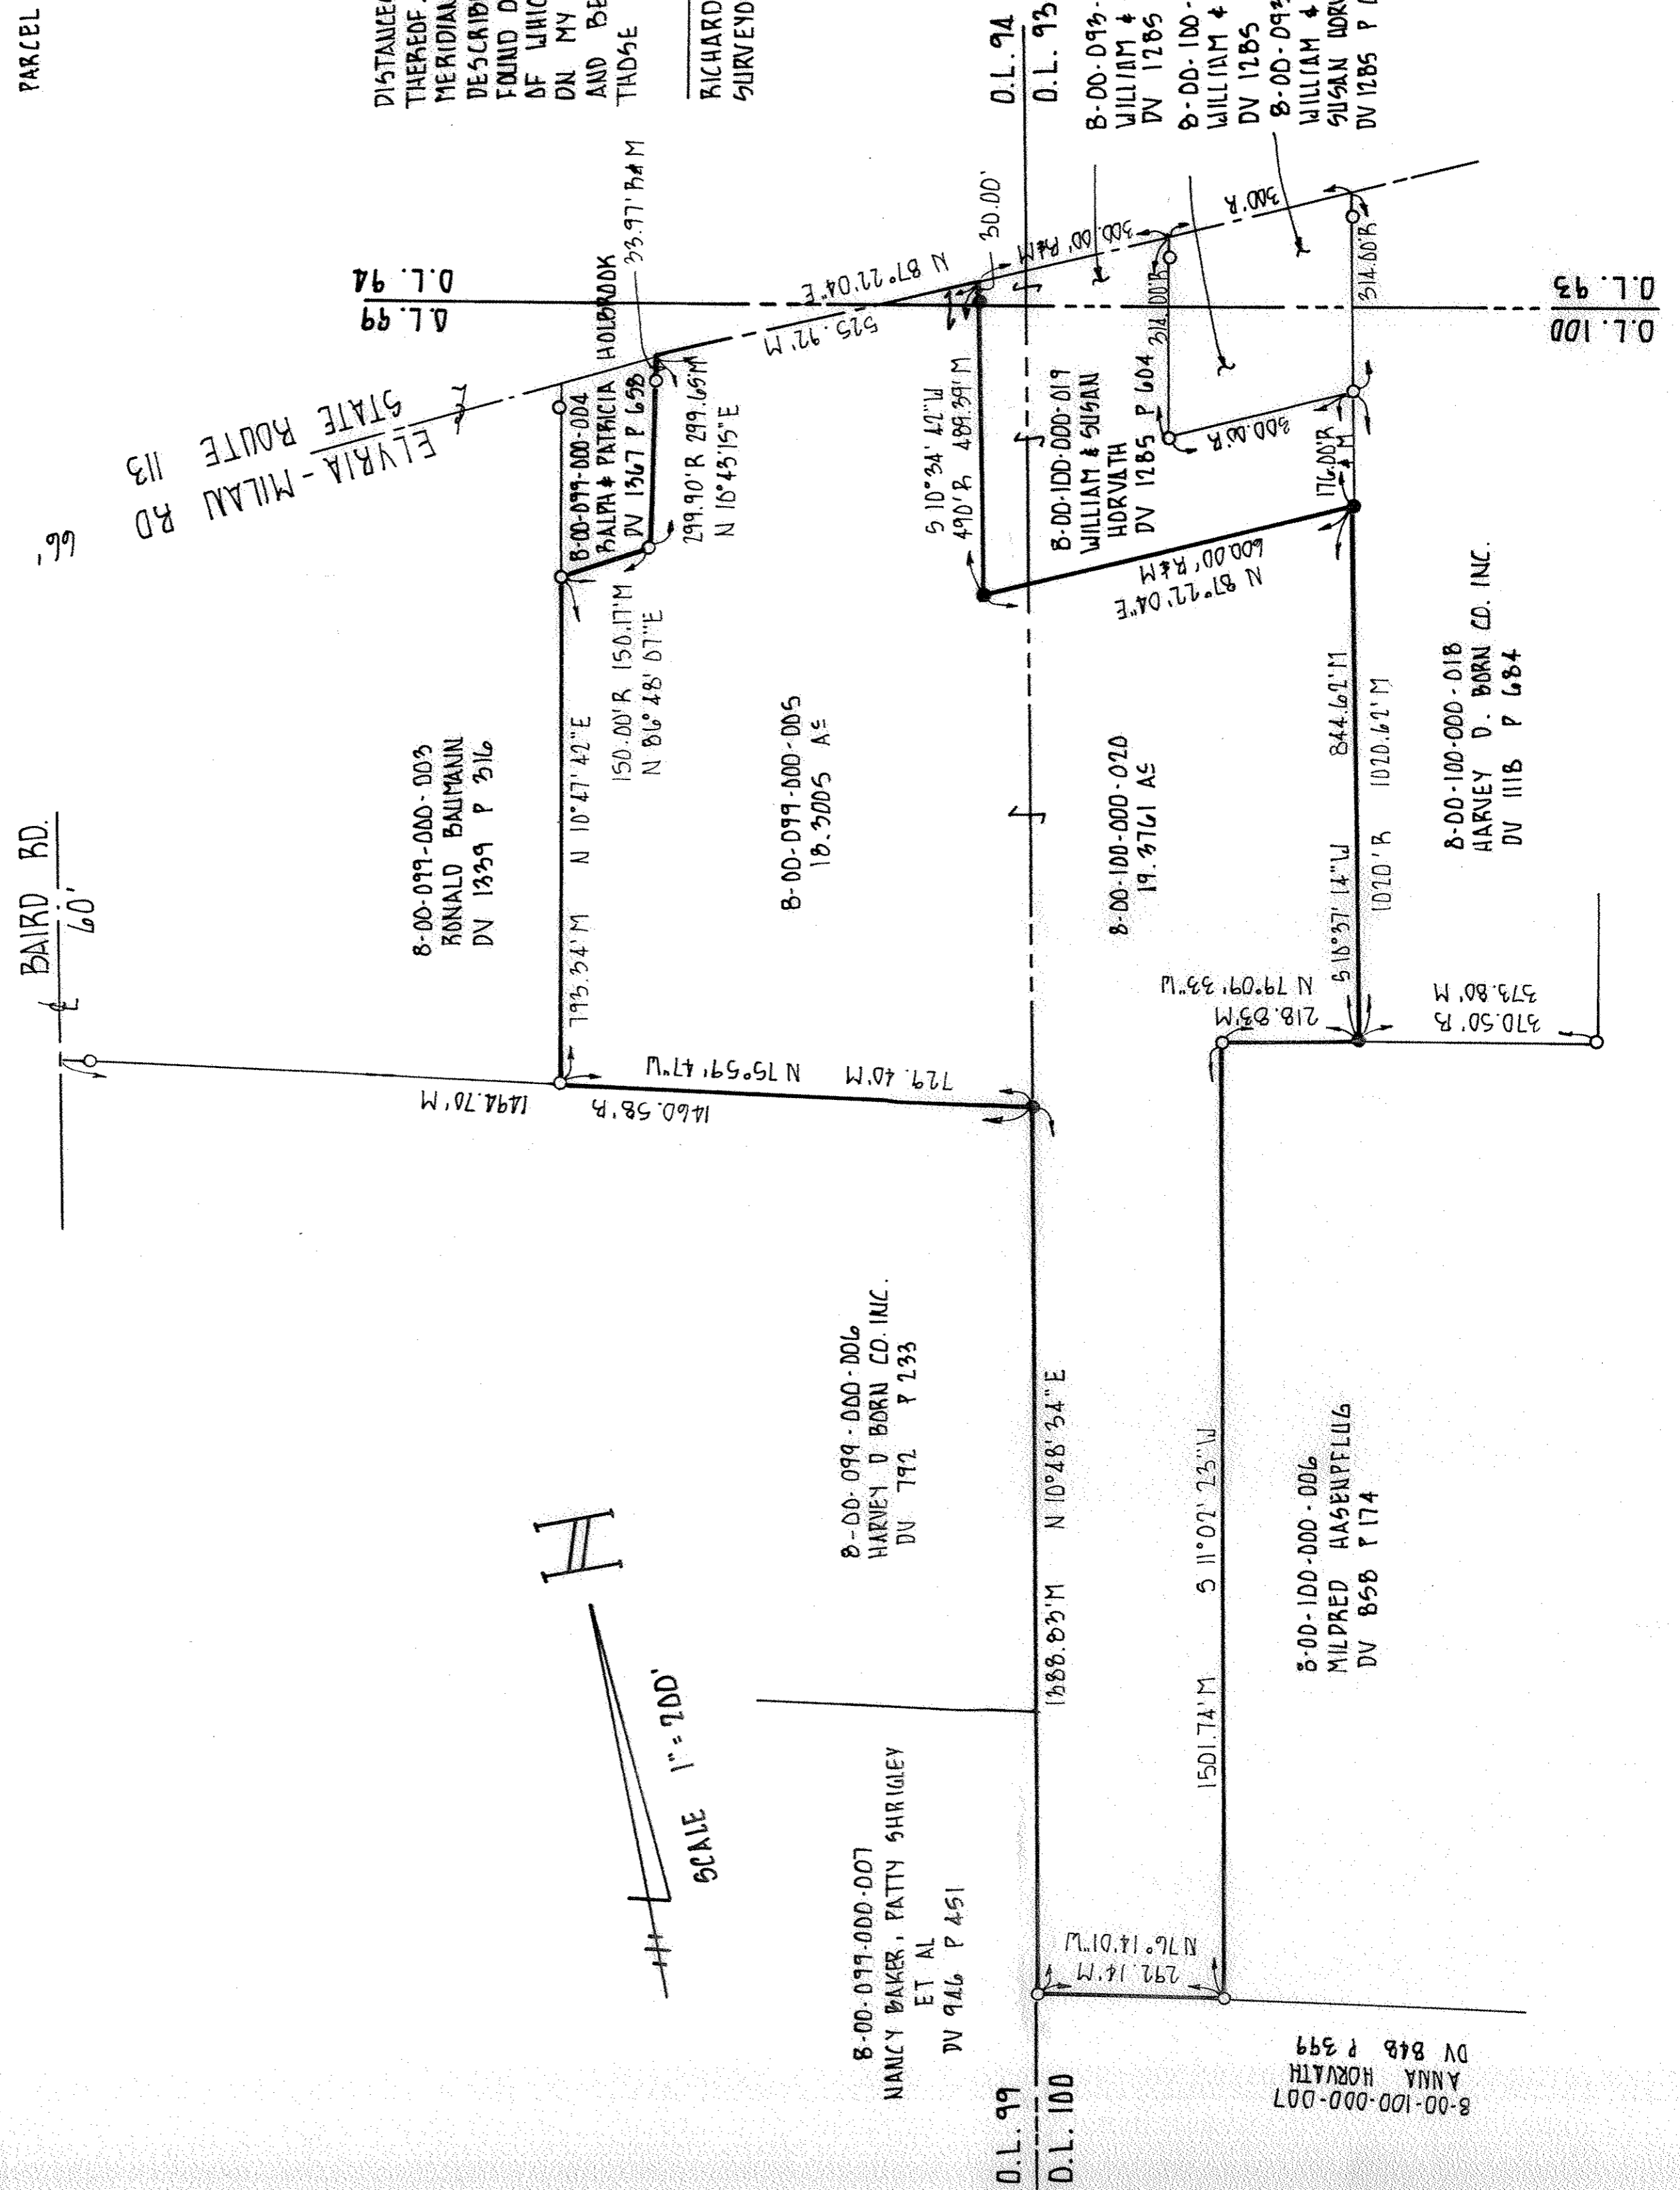

LEGEND
 O IRON PIPE FOUND
 ● IRON PIPE SET
 A RECORD DISTANCE
 M MEASURED DISTANCE