Plat of Survey
State of Ohio
County of Lorain
Township of Carlisle
Original Section No. 10
PP # 10-00-010-000-049
Title - 200601141285
in the name of
Robert O. Guadagni

16.0726 acres as surveyed

survey made at request of
Robert O. Guadagni

Field survey performed by Richard A. Fredrickson, P.S. on Oct. 10,11,13,17,18 & 20 - 2011
All rebar & nails were set on 10-26-2011

Basis of Bearing is derived from NAD 83 Ohio State Plane (north zone 3401) coordinates and were obtained from GPS observations made on the survey site

Rafter A. LTD
10980 Lagrange Road
Elyria, OH 44035
440-309-5275

Legend

- O iron pin or pipe found as noted
- ● 5/8" rebar set w/ cap stamped "Rafter A. LTD" (except as noted)
- • magnetic nail set
- [M] Monument Box w/ pin as noted
- C Calculated - through indirect measurements
- R Recorded in Document
- Fd Found
- U Used as indicated
- PPOB Principal Place of Beginning

STATE OF OHIO
RICHARD A. FREDRICKSON
S-8285
REGISTERED
PROFESSIONAL LAND SURVEYOR
03-17-2015
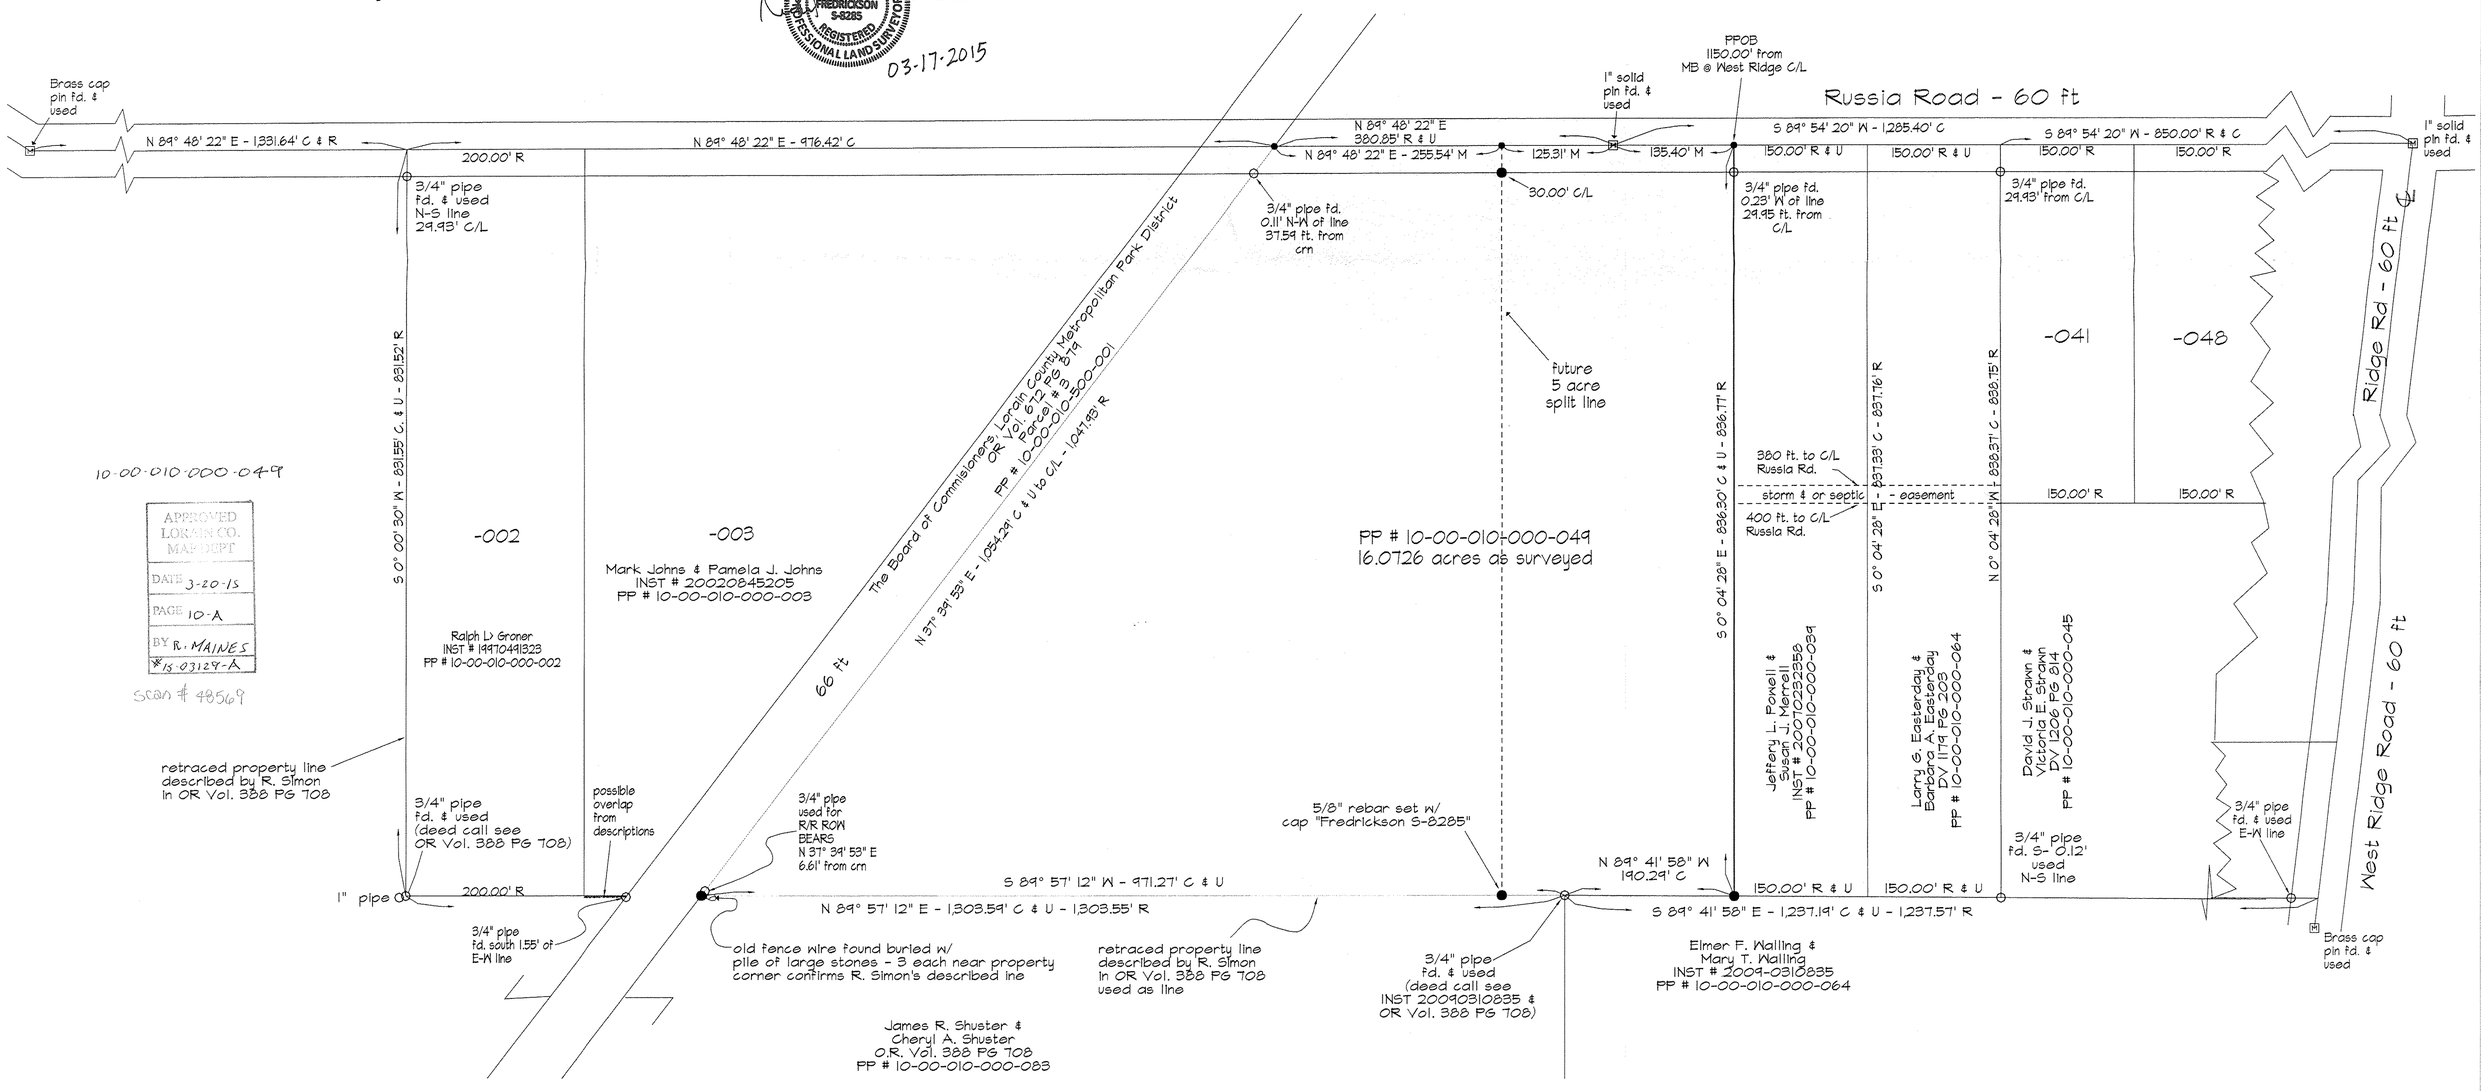
SCALE 1"=80'
0 80 160