
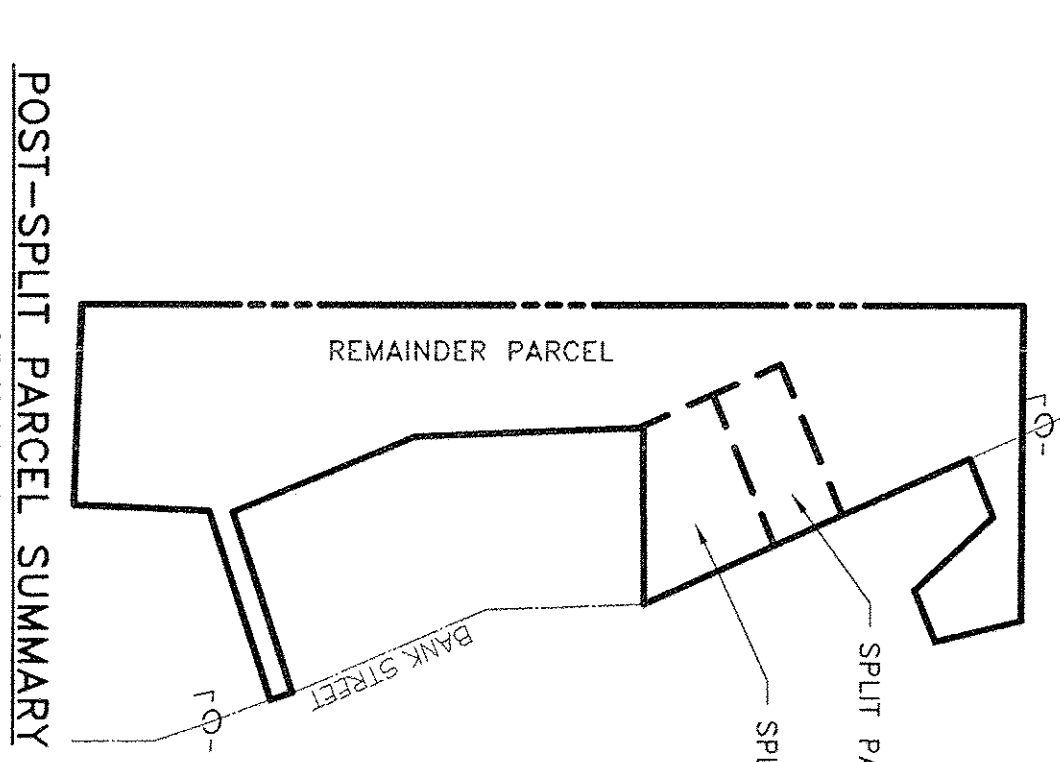
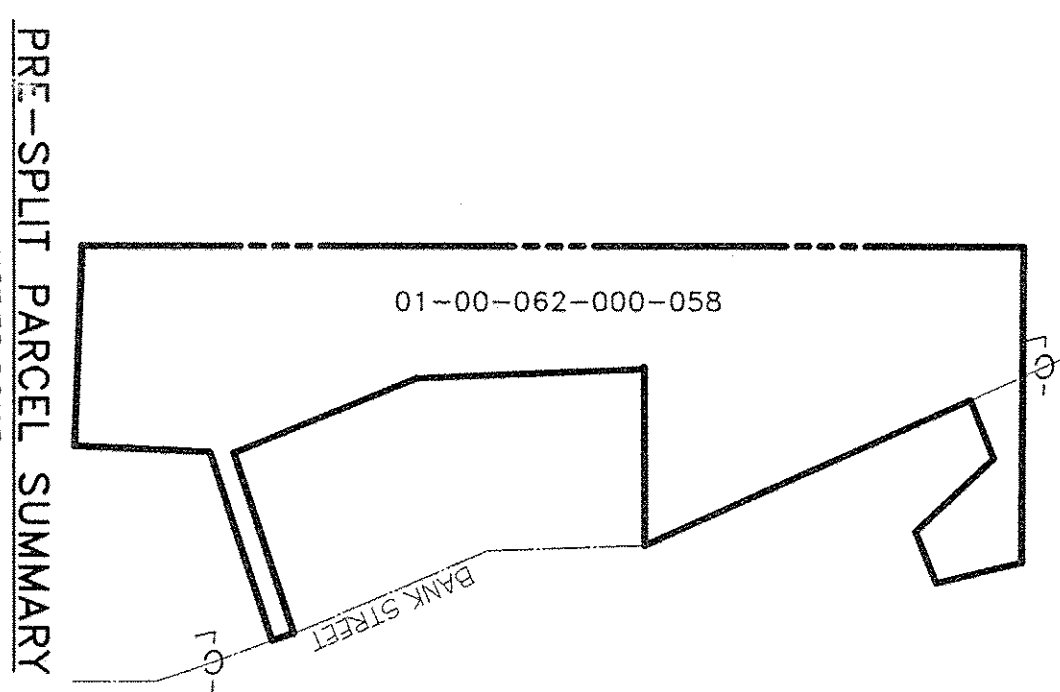


LOT-SPLIT SURVEY

FOR
RUSSELL H. & BEVERLY A. SCHMALZ
 SITUATED IN THE TOWNSHIP OF BROWNHELM, COUNTY OF LORAIN,
 STATE OF OHIO, AND KNOWN AS BEING PART OF ORIGINAL
 BROWNHELM TOWNSHIP LOT NUMBERS 51 & 62.

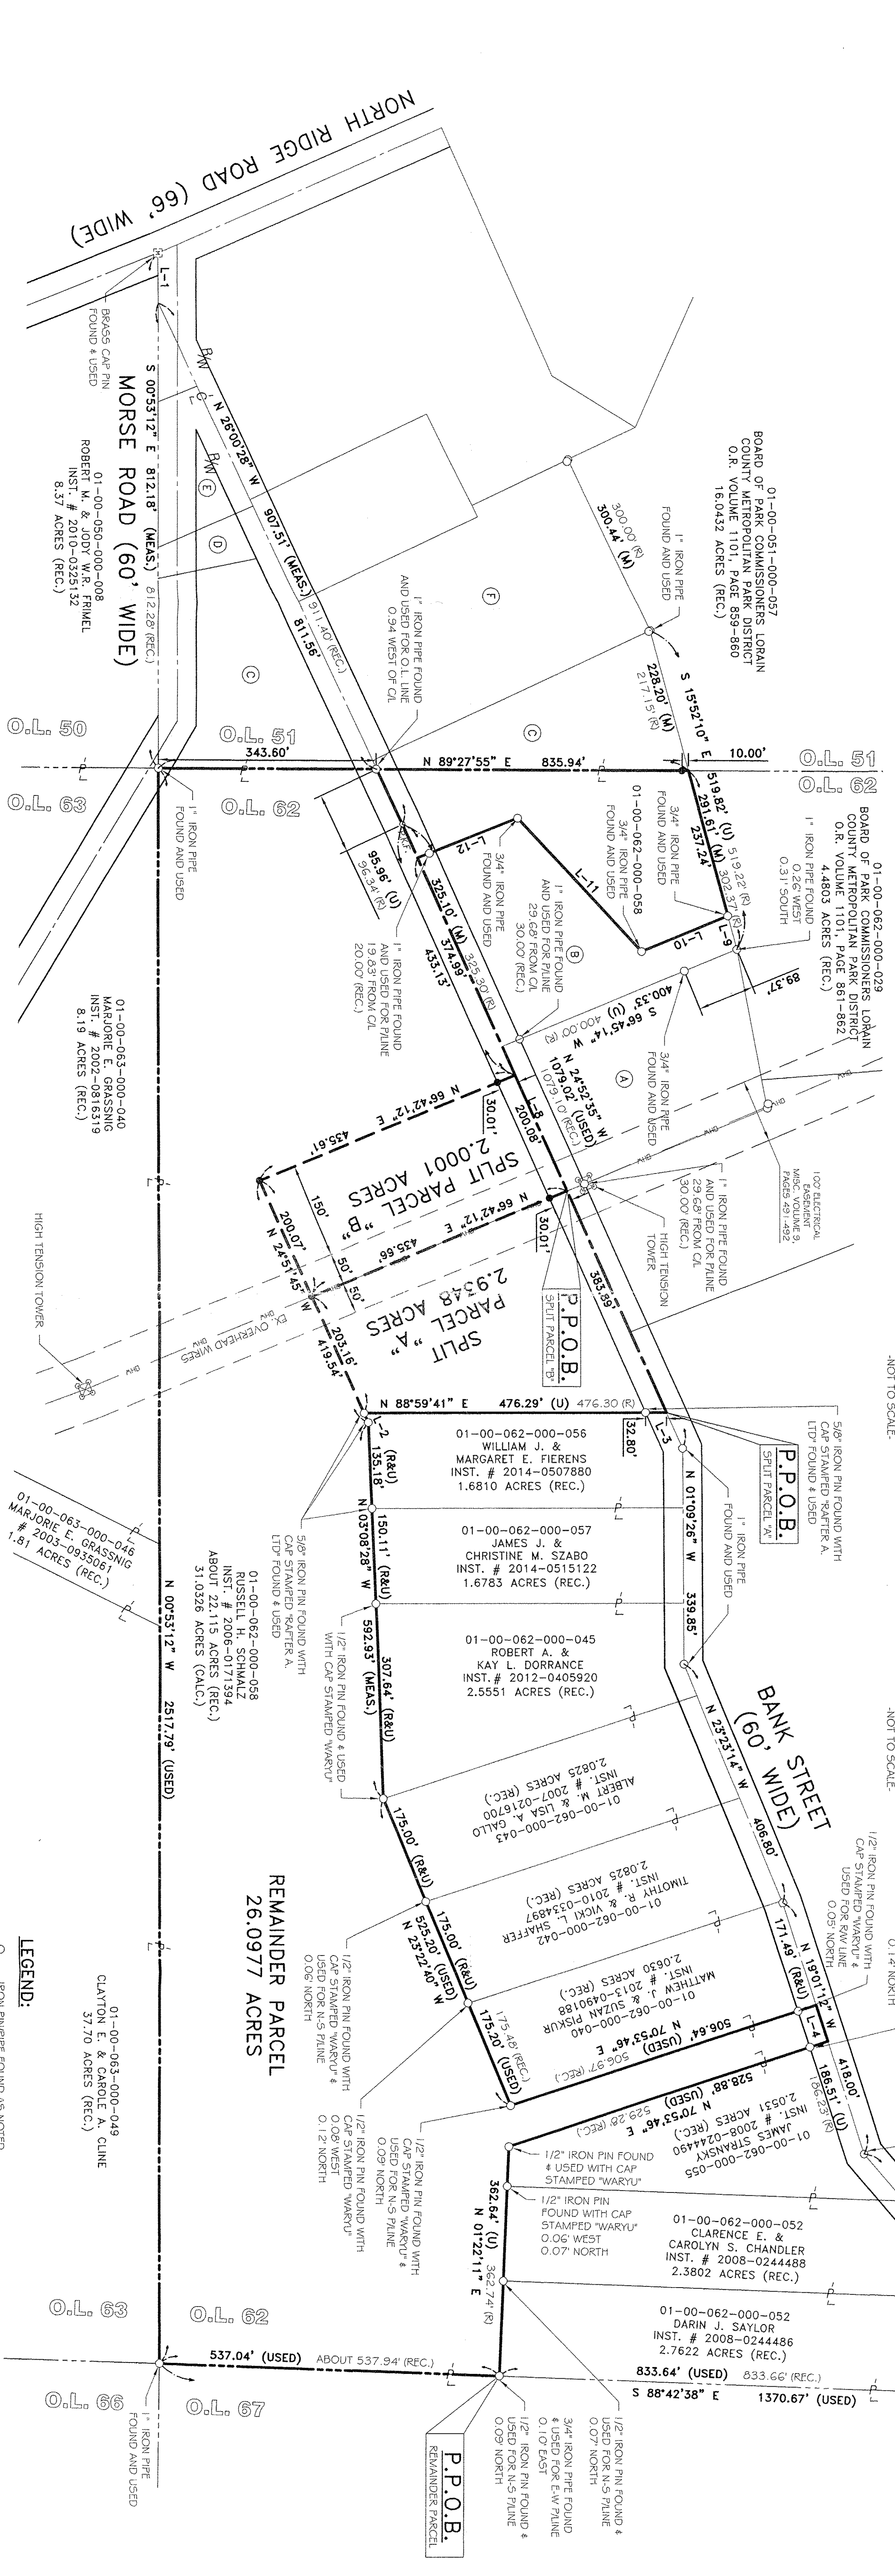

- REFERENCES USED**
- SUBJECT & ADJACENT PARCEL RECORDINGS AS LISTED HEREON
 - LORAIN COUNTY TAX MAPS
 - PLAT OF SURVEY PREPARED BY MICHAEL A. FREDRICKSON, P.S. OF RAFTER A. LTD ON NOVEMBER 11, 2011 FOR RUSSELL H. SCHMALZ
 - PLAT OF SURVEY PREPARED BY MICHAEL G. HURA, P.S. 4712 FOR MELVIN WIGGLE IN JANUARY OF 1990
 - PLAT OF SURVEY PREPARED BY NORMAN R. HURA & ASSOCIATES IN DECEMBER OF 1994 FOR LORAIN COUNTY METROPOLITAN PARK DISTRICT
 - PLAT OF SURVEY PREPARED BY CHARLES P. WARU, P.S. 5029 ON SEPTEMBER 27, 2006 FOR RUSSELL SCHMALZ
 - PLAT OF SURVEY PREPARED BY CHARLES P. WARU, P.S. 5029 ON DECEMBER 12, 2007 FOR RUSSELL SCHMALZ
 - PLAT OF SURVEY PREPARED BY CHARLES P. WARU, P.S. 5029 ON AUGUST 25, 2006 FOR RUSSELL SCHMALZ
 - PLAT OF SURVEY PREPARED BY CHARLES P. WARU, P.S. 5029 IN APRIL OF 2000 FOR GREIG HOOPES
 - PLAT OF SURVEY PREPARED BY ARNOLD F. KOEPEL, P.S. 4306 ON JAN. 1, 1967 FOR BERR REALTY CO.
 - PLAT OF SURVEY PREPARED BY JOHN R. HAMILTON, P.S. 6861 ON JUNE 7, 1967 FOR CHARLES SCHMALZ

LINE REFERENCE TABLE

LINE	BEARING	DISTANCE	REMARKS

PARCEL REFERENCE TABLE

PARCEL	OWNER	ACRES	RECORDING
A	KEITH A. & MARILYN INST. # 2005-0634471	2.123	01-00-062-000-014
B	DAVID & BEVERLY A. WALKER INST. # 2012-0400048	1.8375	01-00-062-000-033
C	RUSSELL H. & BEVERLY A. SCHMALZ, CO-TRUSTEES INST. # 2005-0108716	6.53	01-00-051-000-058
D	RUSSELL H. & BEVERLY A. SCHMALZ, CO-TRUSTEES INST. # 2005-0108716	3.20	01-00-051-000-064

LEGEND:

- IRON PIN/PIPE FOUND AS NOTED
- REDBARK SET WITH CAP STAMPED "Rafter A Ltd" (LINE PINS = GREEN; CORNER PINS = YELLOW)
- MONUMENT BOX FOUND WITH IRON PIN/PIPE FOUND AS NOTED
- PAIROAD SHIKE FOUND AS NOTED
- MAGNETIC OR P.K. NAIL FOUND AS NOTED

GRAPHIC SCALE
 0 60 120 240 (IN FEET)
 SCALE: 1" = 120'

BASIS OF BEARINGS
 BEARING OF BOUNDARY LINES IS USED TO DETERMINE BEARING OF OTHER LINES. BEARING OF ORIGINAL BOUNDARY LINES IS ASSUMED TO BE NORTH 00°31'2" WEST AS SHOWN HEREON.

THIS PLAN IS BASED UPON A FIELD SURVEY PERFORMED BY RAFTER A. LTD IN NOVEMBER & DECEMBER OF 2014.

LOT SPLIT SURVEY
 P.P.N.: 01-00-062-000-058
 SITUATED IN THE TOWNSHIP OF BROWNHELM, COUNTY OF LORAIN, STATE OF OHIO AND KNOWN AS BEING PART OF ORIGINAL BROWNHELM TOWNSHIP LOT NUMBERS 51 & 62

RAFTER A, LTD
 LAND SURVEYING & ENGINEERING
 Office: 440-458-6294
 Fax: 440-458-4403
 www.raftera.com

10880 LaGrange Road
 Elyria, Ohio 44035

DRAWN BY: BDA
 CHECKED BY: RAE

JOB No.: 11-1-14
 SHEET 1 of 1

03358
 APPROVED
 LORAIN CO.
 MAP DEPT
 DATE 3-27-15
 PAGE 1-00-062-000-058
 BY J.Hatfield
 #15-03358