07-00-029-000-199
-200
-201

#15-03351 Scan #48599

~~Waiting on new map with names of roads~~
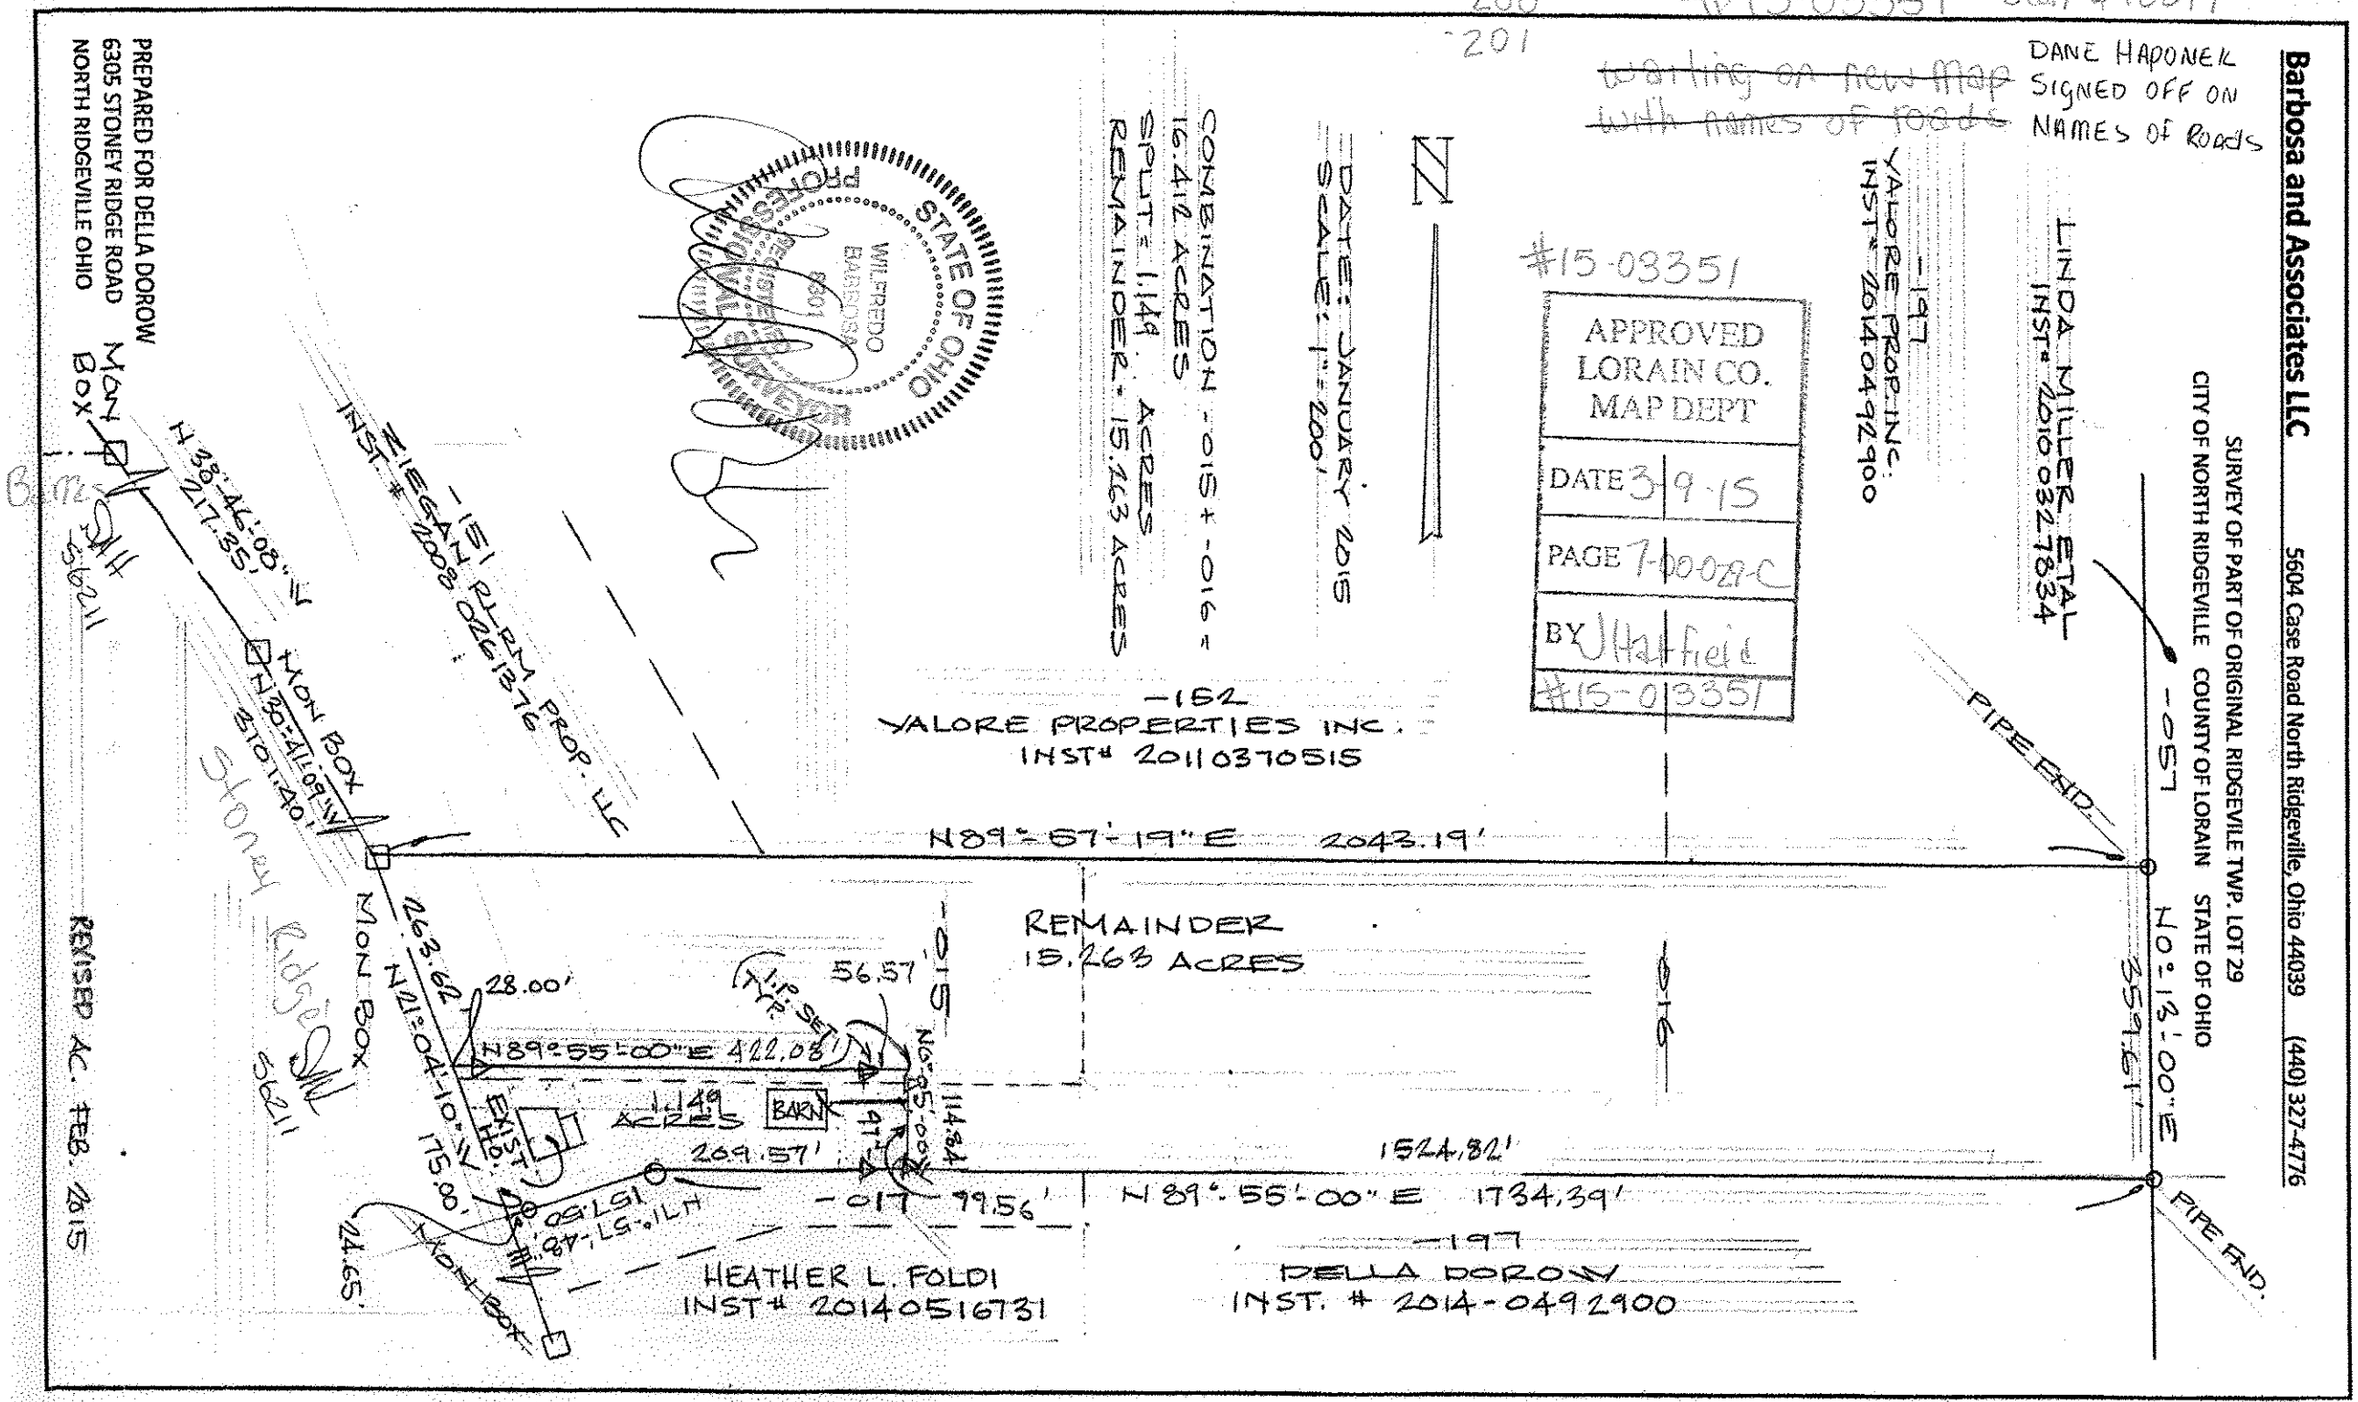
DANE HAPONEK SIGNED OFF ON NAMES OF ROADS