

BARBOSA AND ASSOCIATES LLC

5604 Case Road North Ridgeville, Ohio 44039 (440) 327-4776



DATE: JANUARY 2, 2016
SCALE: 1" = 60'

SURVEY

OF


PARCEL 04-00-010-115-003

CITY OF AVON COUNTY OF LORAIN STATE OF OHIO

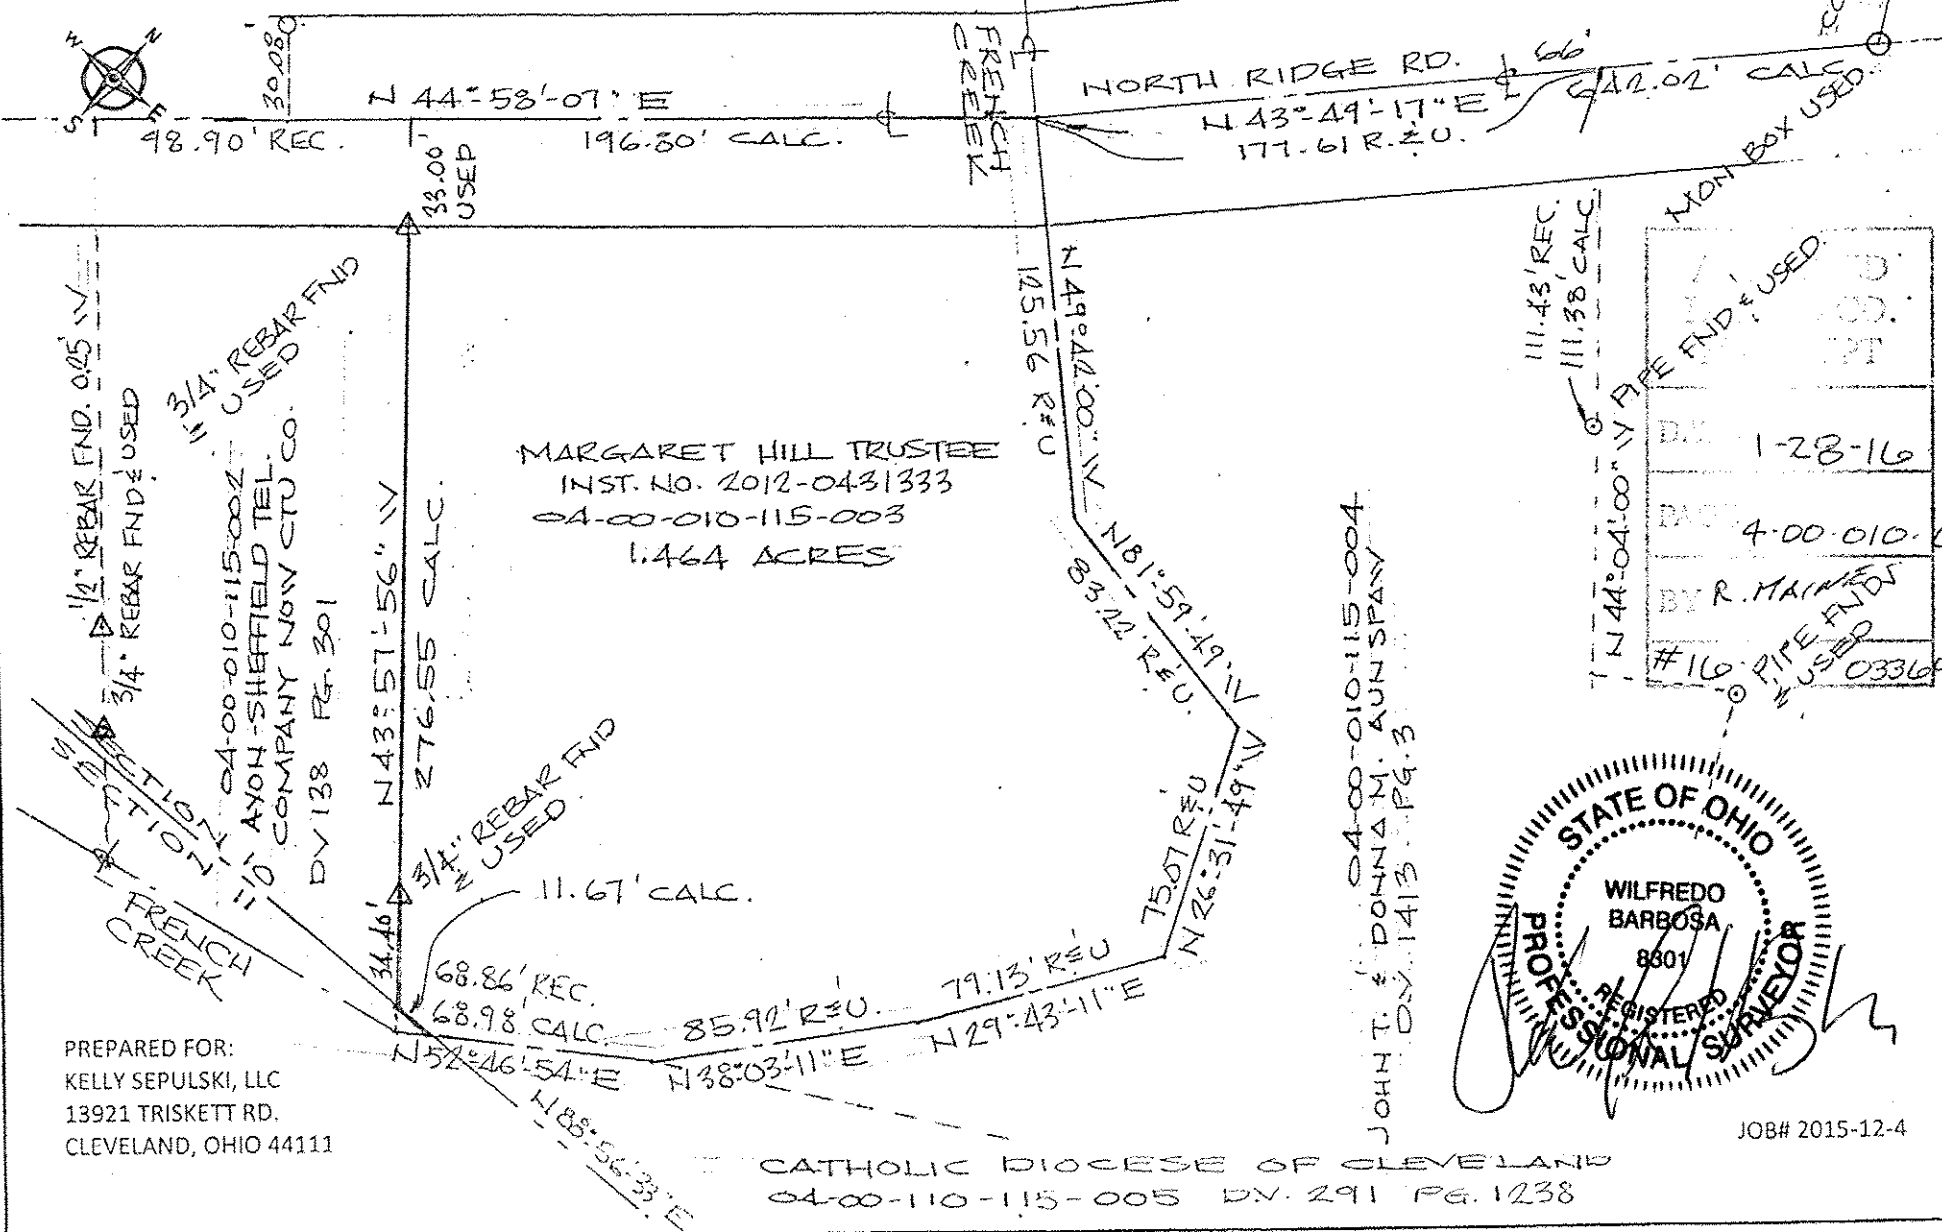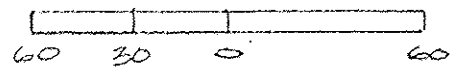


MARGARET HILL TRUSTEE
INST. NO. 2012-0431333
04-00-010-115-003
1.464 ACRES

1/2" REBAR FND. 0.25' W
3/4" REBAR FND. USED
3/4" REBAR FND. USED
04-00-010-115-002
AYON-SHEFFIELD TEL.
COMPANY NOW CTU CO.
DV 138 PG. 301

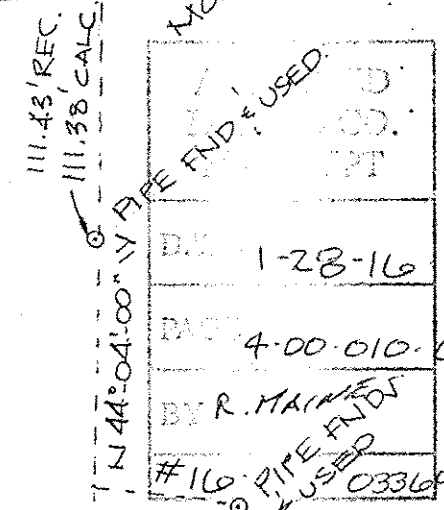

PREPARED FOR:
KELLY SEPULSKI, LLC
13921 TRISKETT RD.
CLEVELAND, OHIO 44111

04-00-010-115-004
JOHN T. & DONNA M. AUNSPAN
D.V. 1413 PG. 3

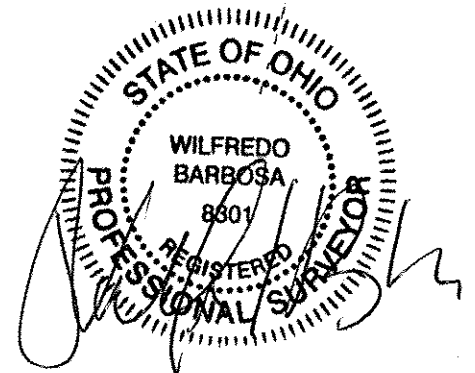

JOB# 2015-12-4

CATHOLIC DIOCESE OF CLEVELAND
04-00-110-115-005 DV. 291 PG. 1238