

07-00-023-102-071

BARBOSA AND ASSOCIATES LLC

5604 Case Road North Ridgeville, Ohio 44039

(440) 327-4776

CONSOLIDATION

OF

PARCELS 07-00-023-102-058, 059, 060


CITY OF NORTH RIDGEVILLE COUNTY OF LORAIN STATE OF OHIO



CHESTNUT RIDGE ROAD 60'

N 44° 42' 55" E

435.00'

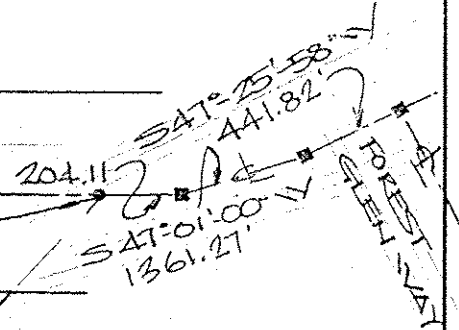

07-00-023-102-062
DENNIS & CAROLYN OBLAK
INST # 2009-0316055

95.56'
N 45° 06' 25" W 103.50'

H 37° 08' 53" W 121.00'


07-00-023-102-060
INST # 2015-0557395 PCL 3
DALE H. & DENISE A HICKLE
0.62 AC.

07-00-023-102-059
INST # 2015-0557395 PCL 2
DALE H. & DENISE A. HICKLE
0.56 AC.

07-00-023-102-058
INST # 2015-0557395 PCL 1
DALE H. & DENISE A. HICKLE
0.64 AC.

07-00-023-102-035
JACK F. & MELISSA L. KINZIE
INST. # 1997-0469888

TOTAL ACREAGE
1.8252 AC.

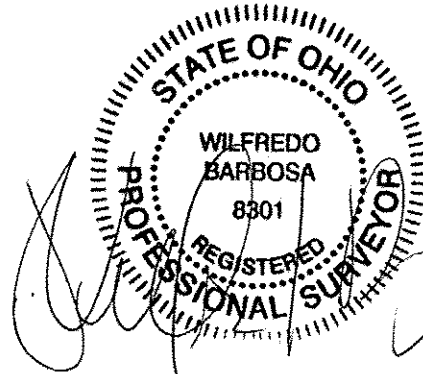

03526

| |
|-----------------------------------|
| APPROVED LORAIN CO MAY DEPT |
| DATE 6-9-16 |
| PAGE 7-00-023 |
| BY JHOTFIELD |
| #16-03524 |

LEGEND:

- = MAG SPIKE OR NAIL SET
- ▲ = REBAR FOUND
- = MONUMENT BOX

DATE: FEB. 9, 2016

SCALE: 1" = 60'

PREPARED FOR:
DALE HICKLE
5945 FIELDSTONE CIRCLE
NORTH RIDGEVILLE, OH 44039

07-00-023-102-064
DENNIS & CAROLYN OBLAK
INST. # 2009-0316054