19-02-001-000-007

200 0 200 400 600

GRAPHIC SCALE – FEET

DIMENSIONS SHOWN ON THIS PLAT ARE EXPRESSED IN FEET AND DECIMAL PARTS THEREOF, ALL BEARINGS ARE TO AN ASSUMED MERIDIAN AND ARE USED TO INDICATE ANGLES ONLY. PERMANENT MONUMENTS WERE FOUND OR SET AT ALL POINTS INDICATED HEREON, ALL OF WHICH I CERTIFY TO BE CORRECT.

THOMAS A. SIMON S-7775

THOMAS A. SIMON
REG. PROFESSIONAL SURVEYOR
NO. S-7775

ASSESSED
LOCATION NO.
MAP
DATE 3-16-16
PAGE 19-A
BY R. MAINES
#16-03399-X

N

BASIS OF BEARINGS IS THE CENTERLINE OF JONES ROAD (NORTH 88°16'59" WEST). IRON PINS SET ARE 5/8" DIAMETER, 30" LONG WITH PLASTIC CAPS "T. SIMON, S-7775".

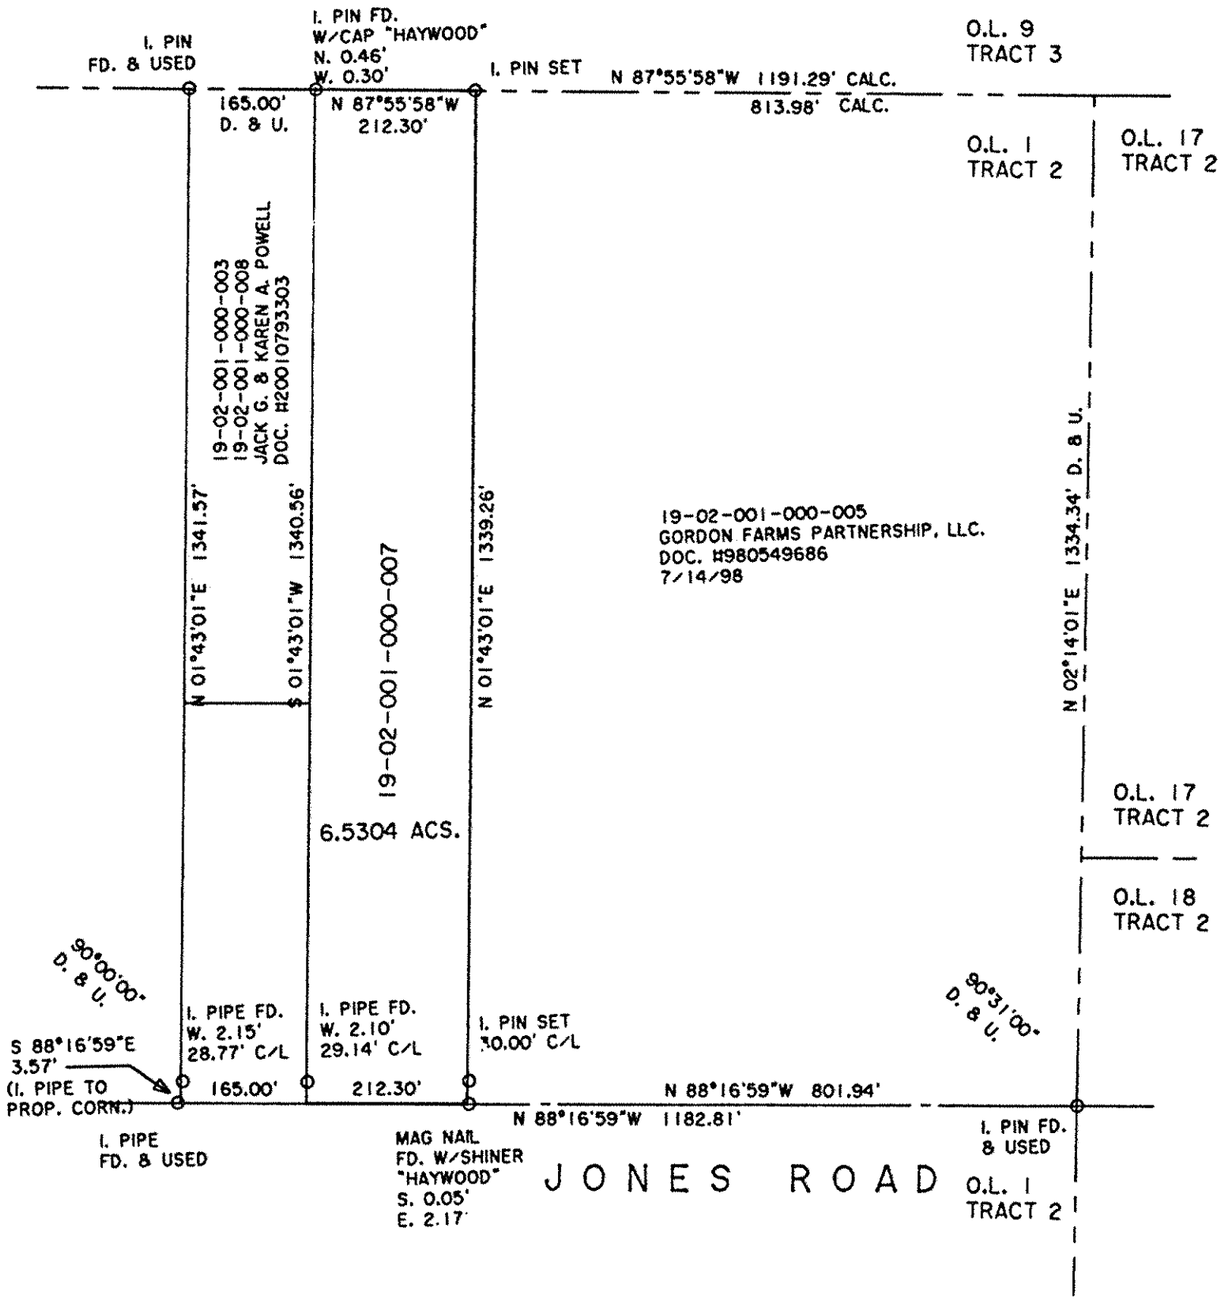

PLAT OF BOUNDARY SURVEY

BEING KNOWN AS PART OF
ORIGINAL PENFIELD TOWNSHIP
LOT NO. 1, TRACT 2

COUNTY OF LORAIN STATE OF OHIO
NOVEMBER, 2015 SCALE: 1" = 200'

THOMAS SIMON & ASSOCIATES, INC.
PROFESSIONAL LAND SURVEYORS

150 SOUTH OLIVE STREET
ELYRIA, OHIO 44035

(440) 327-2925
FAX 327-2964

JOB NO. 2015-059