

07-00-016-112-044

BARBOSA AND ASSOCIATES LLC

5604 Case Road North Ridgeville, Ohio 44039

(440) 327-4776

SURVEY

OF PARCEL 7-00-016-112-044 KNOWN AS PARCEL #2 RECORDED IN INSTRUMENT #2013-0462488 LORAIN COUNTY RECORDER

CITY OF NORTH RIDGEVILLE COUNTY OF LORAIN STATE OF OHIO

DATE	5-17-16
PAR	7-00-016-B
BY	R. MAINE S
#	16-0345-1-D


07-00-016-112-052
RINI REALTY COMPANY
INST # 2013-0475310

07-00-016-112-044
JAMES A. & SANDRA C. ARMARO
INST # 2013-0462488 PCL # 1
4.04 AC. DEED 3.693 AC. ACUAL

WIL LOU ACRES SUBDIVISION 3
PLAT VOL. 25 PG. 63

15.21 CALC.
15.49 REC.
15.43 088.

07-00-016-112-045
PROVIDENCE SURVEY LLC
INST. # 2013-0454442

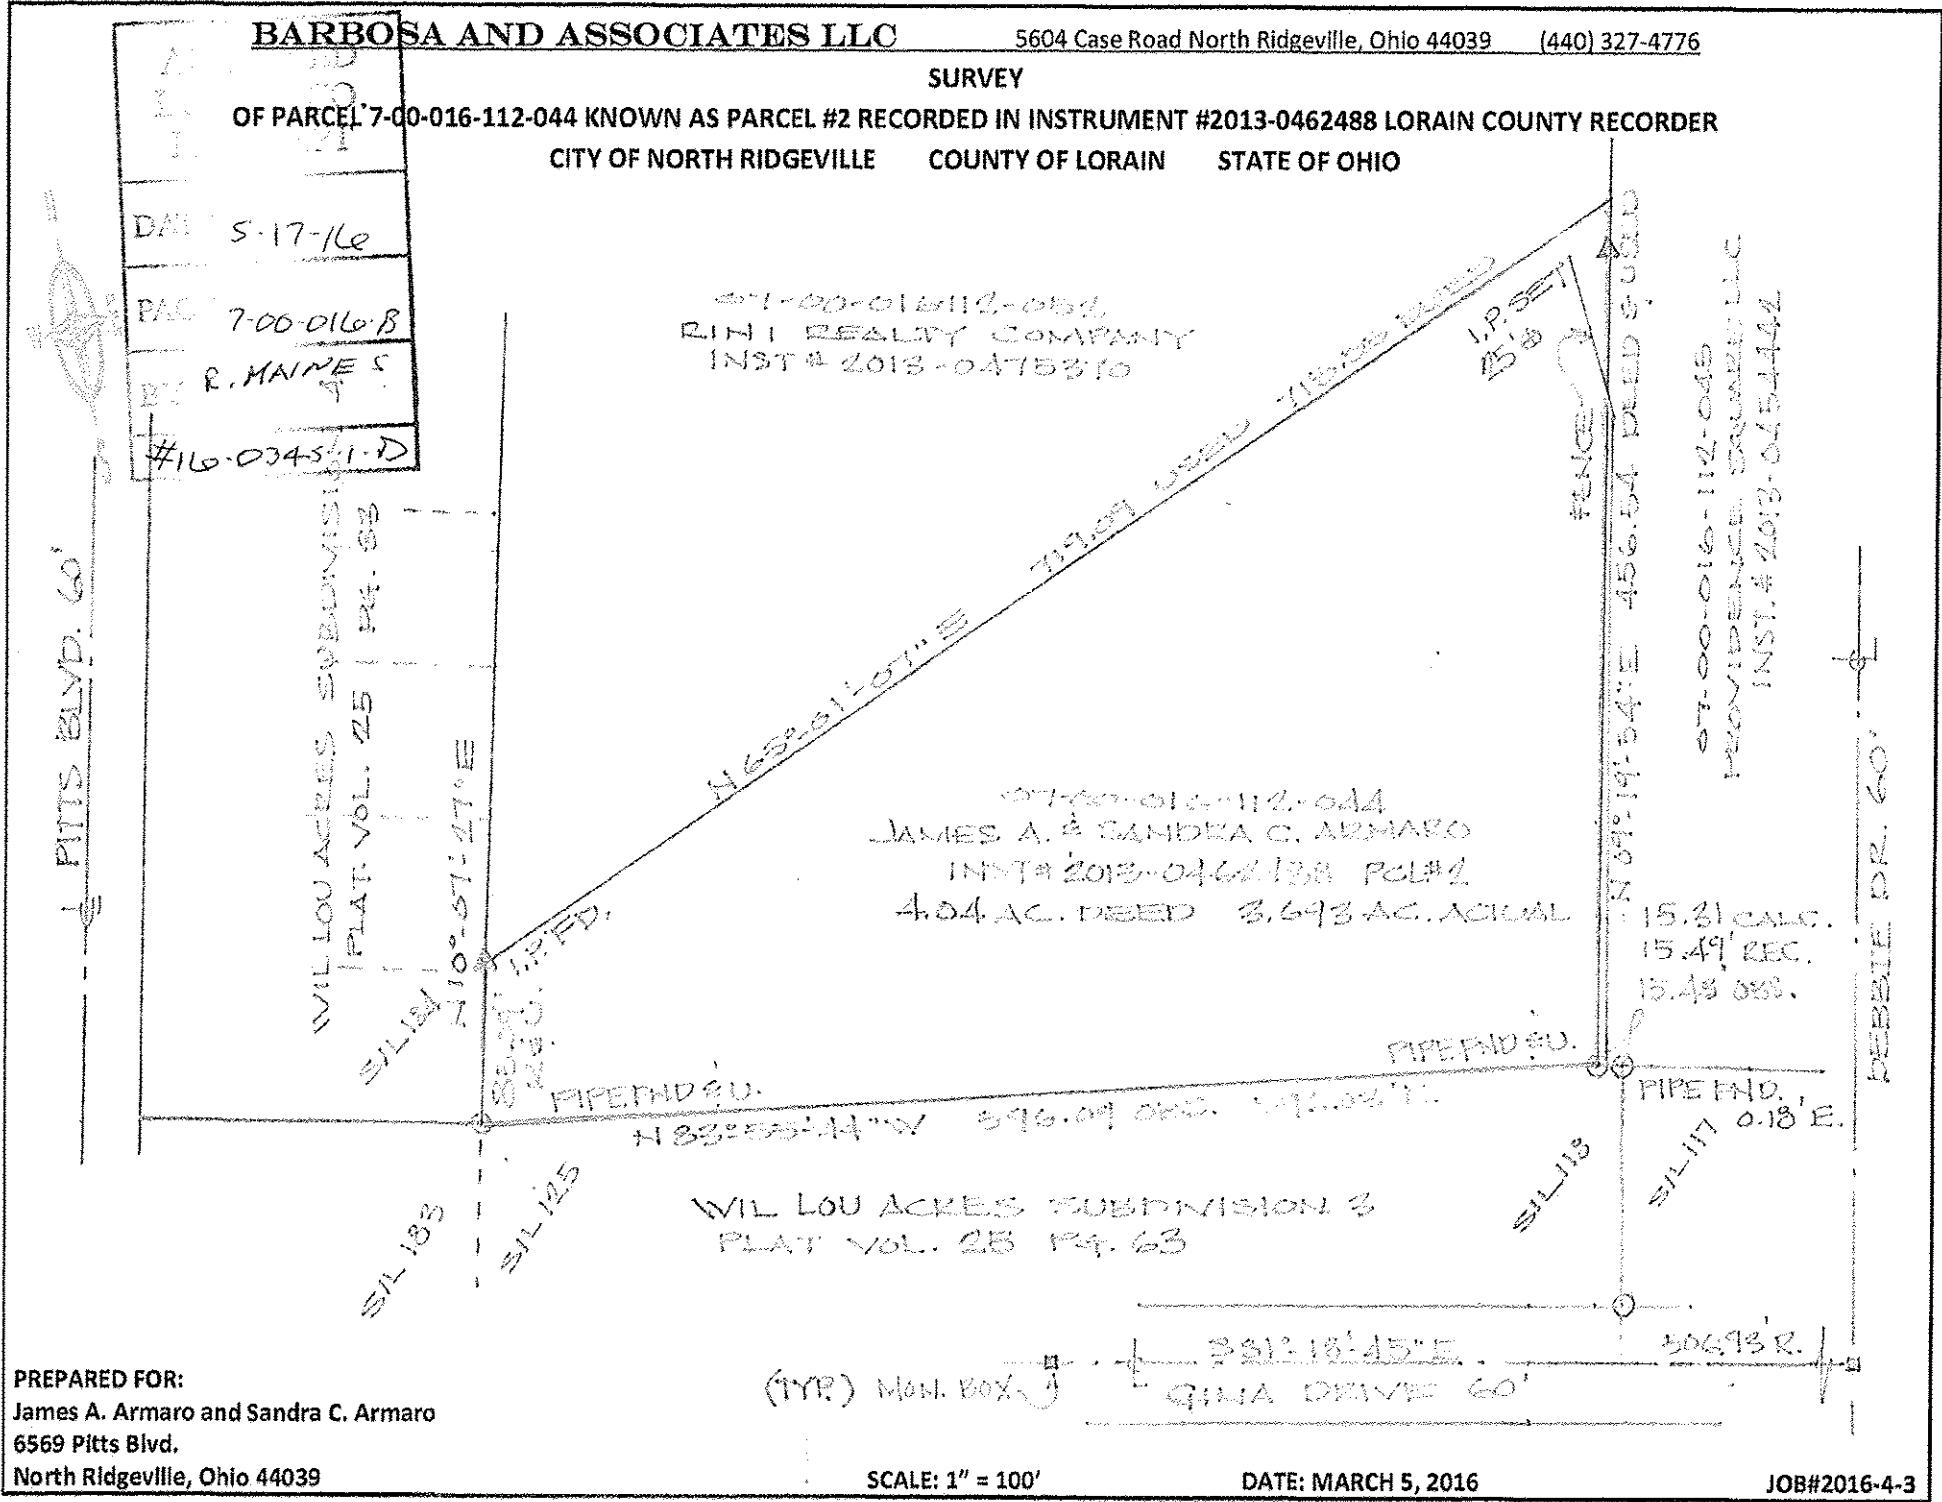

PREPARED FOR:
James A. Armaro and Sandra C. Armaro
6569 Pitts Blvd.
North Ridgeville, Ohio 44039

SCALE: 1" = 100'

DATE: MARCH 5, 2016

JOB#2016-4-3