STATE OF OHIO, COUNTY OF LORAIN, CITY OF ELYRIA,
BEING PART OF ORIGINAL ELYRIA TOWNSHIP LOTS 10 AND 102
WEST OF THE BLACK RIVER

0' 30' 60' 90'

SCALE: 1"=30'

BASIS OF BEARINGS

THE BASIS FOR BEARINGS FOR THIS SURVEY IS GRID NORTH OF THE OHIO STATE PLANE COORDINATE SYSTEM, NORTH ZONE, NAD83 (2011).

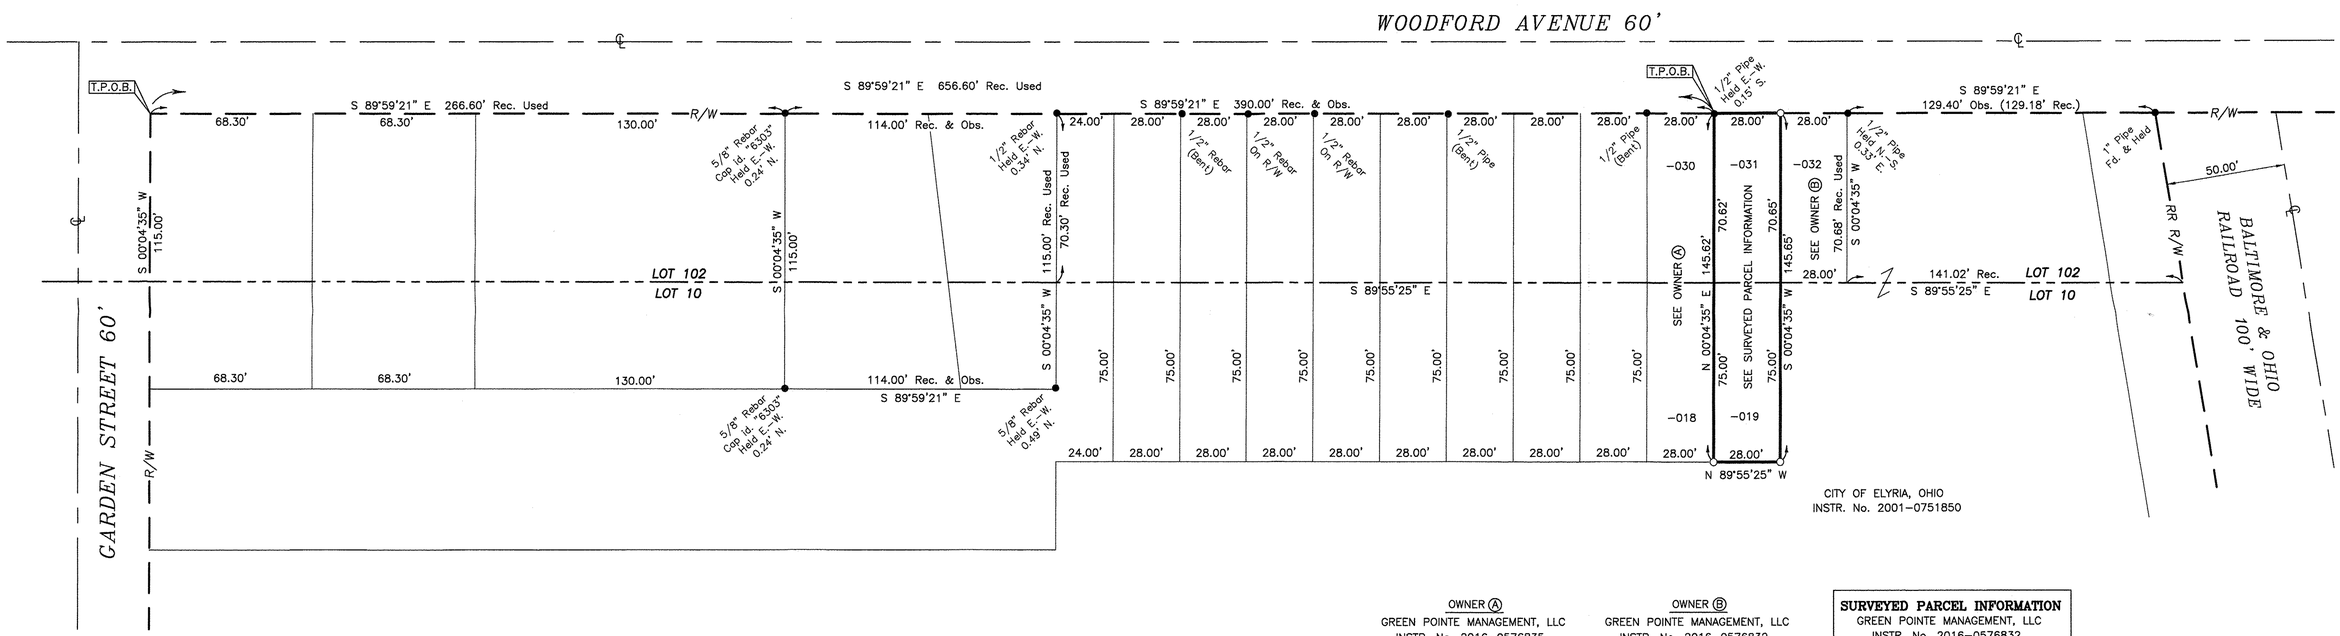

OWNER (A)
GREEN POINTE MANAGEMENT, LLC
INSTR. No. 2016-0576835

OWNER (B)
GREEN POINTE MANAGEMENT, LLC
INSTR. No. 2016-0576832

SURVEYED PARCEL INFORMATION
GREEN POINTE MANAGEMENT, LLC
INSTR. No. 2016-0576832

TOTAL AREA
4078 SQ. FT.
0.094 ACRES

PARCEL #06-24-102-000-031
(PART LOT 102 – 0.046 AC.)

PARCEL #06-24-010-102-019
(PART LOT 10 – 0.048 AC.)

LEGEND

REC. - RECORD
CALC. - CALCULATED
OBS. - OBSERVED
T.P.O.B. - TRUE PLACE OF BEGINNING
P.O.B. - PLACE OF BEGINNING
■ - MONUMENT BOX
● - MONUMENT FOUND, SIZE & TYPE AS INDICATED.
○ - 5/8" REBAR, 30 INCHES IN LENGTH, WITH I.D. CAP C&A SET
△ - MAG NAIL SET
(XX°XX'XX" XX.XX') - RECORD BEARING & DISTANCE

REFERENCES

LORAIN COUNTY AUDITOR/GIS

LORAIN COUNTY DEEDS REFERENCED HEREON

SURVEYS BY:
- C.E. PENFOUND NOV., 1956
- JAMES H. SCHMIDT FEB., 1972
- KLEINOEDER-SCHMIDT & ASSOC. JAN., 1983

APPROVED
LORAIN CO.
MAP DEPT.
DATE 7/8/16
PPN 06-24-010
102
BY T Spillman
TAX # 03479 D

SCAN # 48899

I HEREBY CERTIFY THAT THIS SURVEY WAS PREPARED IN ACCORDANCE WITH THE MINIMUM STANDARDS FOR BOUNDARY SURVEYS IN THE STATE OF OHIO AS DESCRIBED IN O.A.C. CHAPTER 4733-37.

6/15/2016

JAMES P. YURKSCHATT REG. NO. 7809 DATE
CAMPBELL & ASSOCIATES, INC.

STATE OF OHIO
JAMES P YURKSCHATT
S-7809
REGISTERED
PROFESSIONAL SURVEYOR

BOUNDARY SURVEY
WOODFORD AVENUE
ELYRIA, OHIO

CAMPBELL & ASSOCIATES, INC.
Land Surveying
(330) 945-4117
www.campbellsurvey.com
3485 Fortuna Drive Suite 100 Akron, Ohio 44312

Date:	JUNE, 2016
By:	JPY
Scale:	1"= 30'
Job:	20160130