

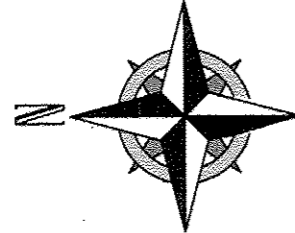


SURVEY
OF PART OF
ORIGINAL ELYRIA TOWNSHIP LOT NO. 157 WEST OF THE BLACK RIVER
06-24-157-000-004
CITY OF ELYRIA COUNTY OF LORAIN STATE OF OHIO

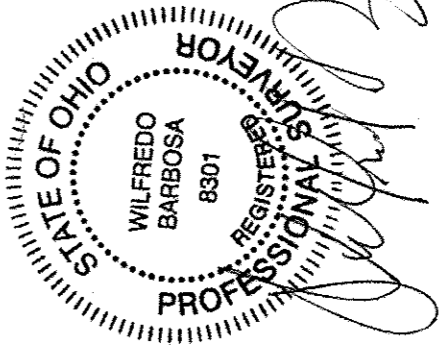

APPROVED
LORAIN CO.
MAP DEPT.
DATE 1/12/17
PAGE 6-24-157
BY T. SULLIVAN
03584-C
Scan# 49042

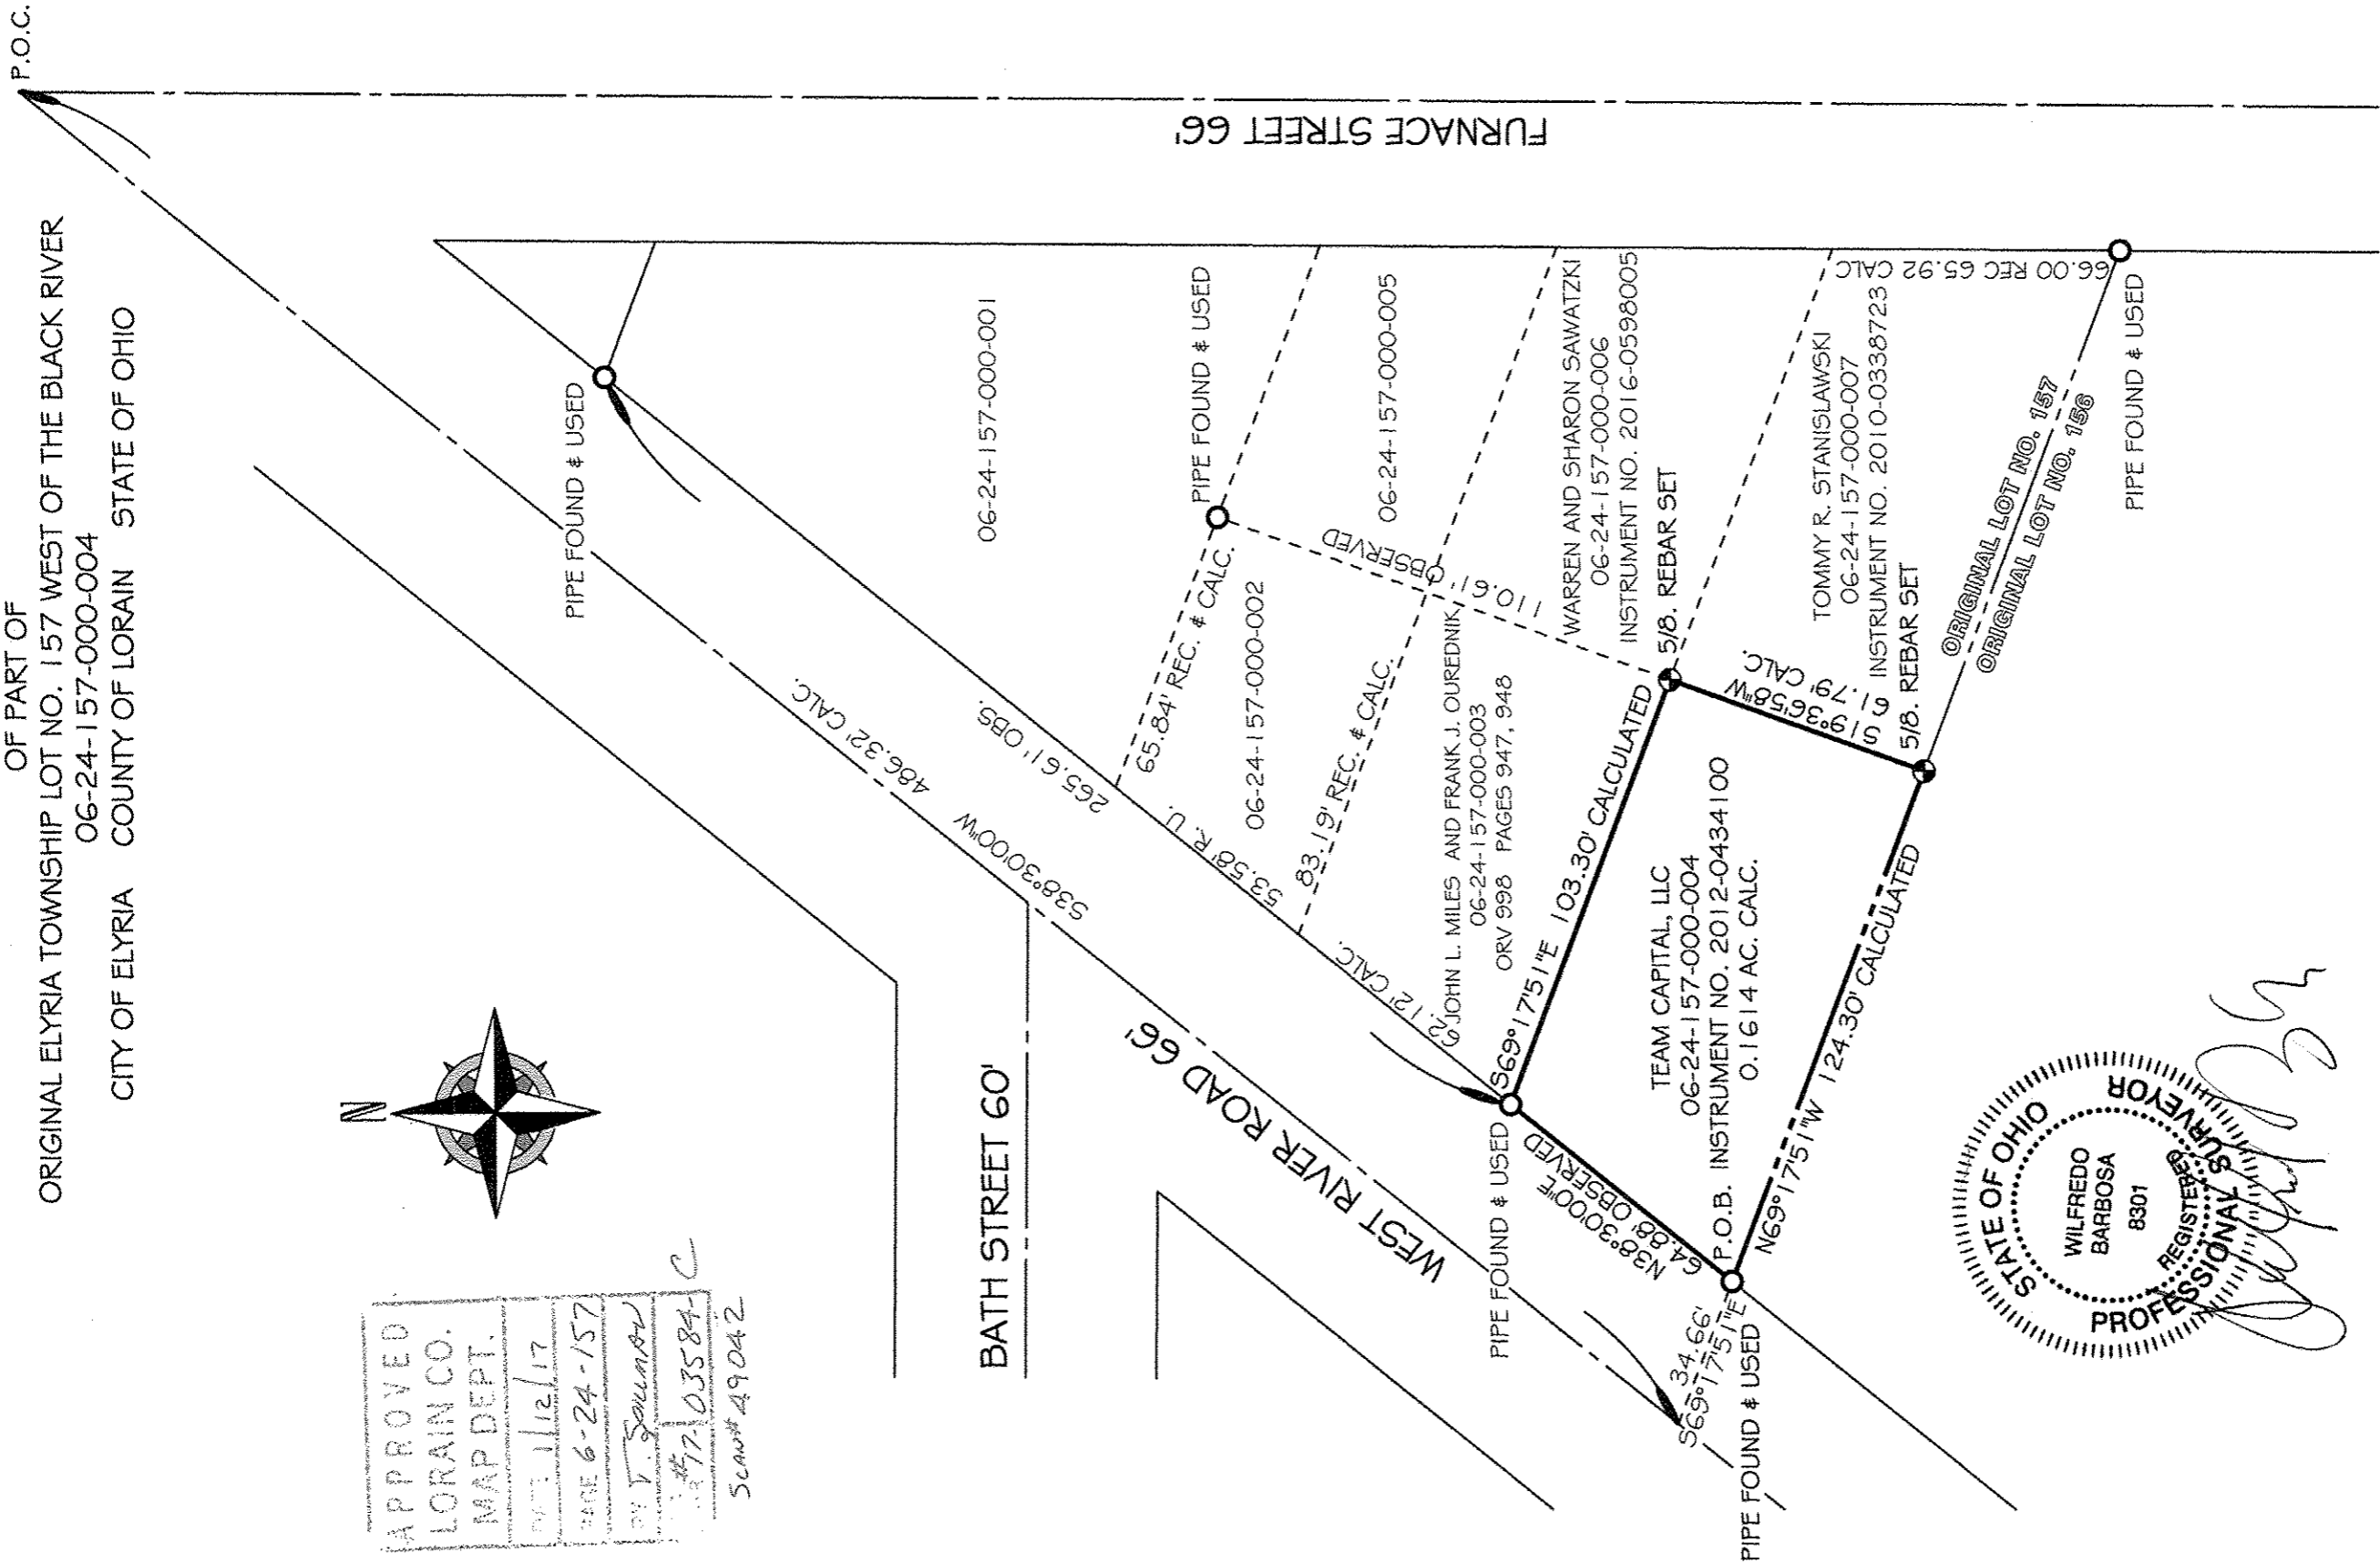

BASIS OF BEARINGS: ASSUMED

DATE: DECEMBER 21, 2016

PROPERTY ADDRESS:
759 WEST RIVER ROAD N.
ELYRIA, OHIO


BARBOSA AND ASSOCIATES LLC
5604 CASE ROAD
NORTH RIDGEVILLE, OH 44039
440 327-4776

PREPARED AT THE REQUEST OF:
OMAR FELICIE
514 E. 32ND STREET
LORAIN OHIO 44055

DRAWN BY: WB
JOB No: 2016-12-2

CHECKED BY: WB
SHEET 1 of 1

GRAPHIC SCALE

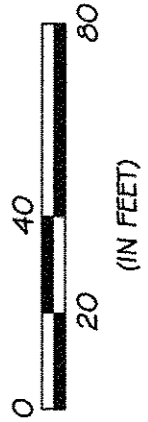

SCALE: 1" = 40'