Note: Bearing are based on the Ohio State Plane, North Zone, NAD 83 Grid North, but are shown to describe angles only.

Being known as Part of Original lot
29 of Columbia Township, County of Lorain
and the State of Ohio.
And Known as Lorain County Parcel
Number 12-00-029-000-016

N
W E
S

0 80'

Scale 1" = 80'
July 30, 2016

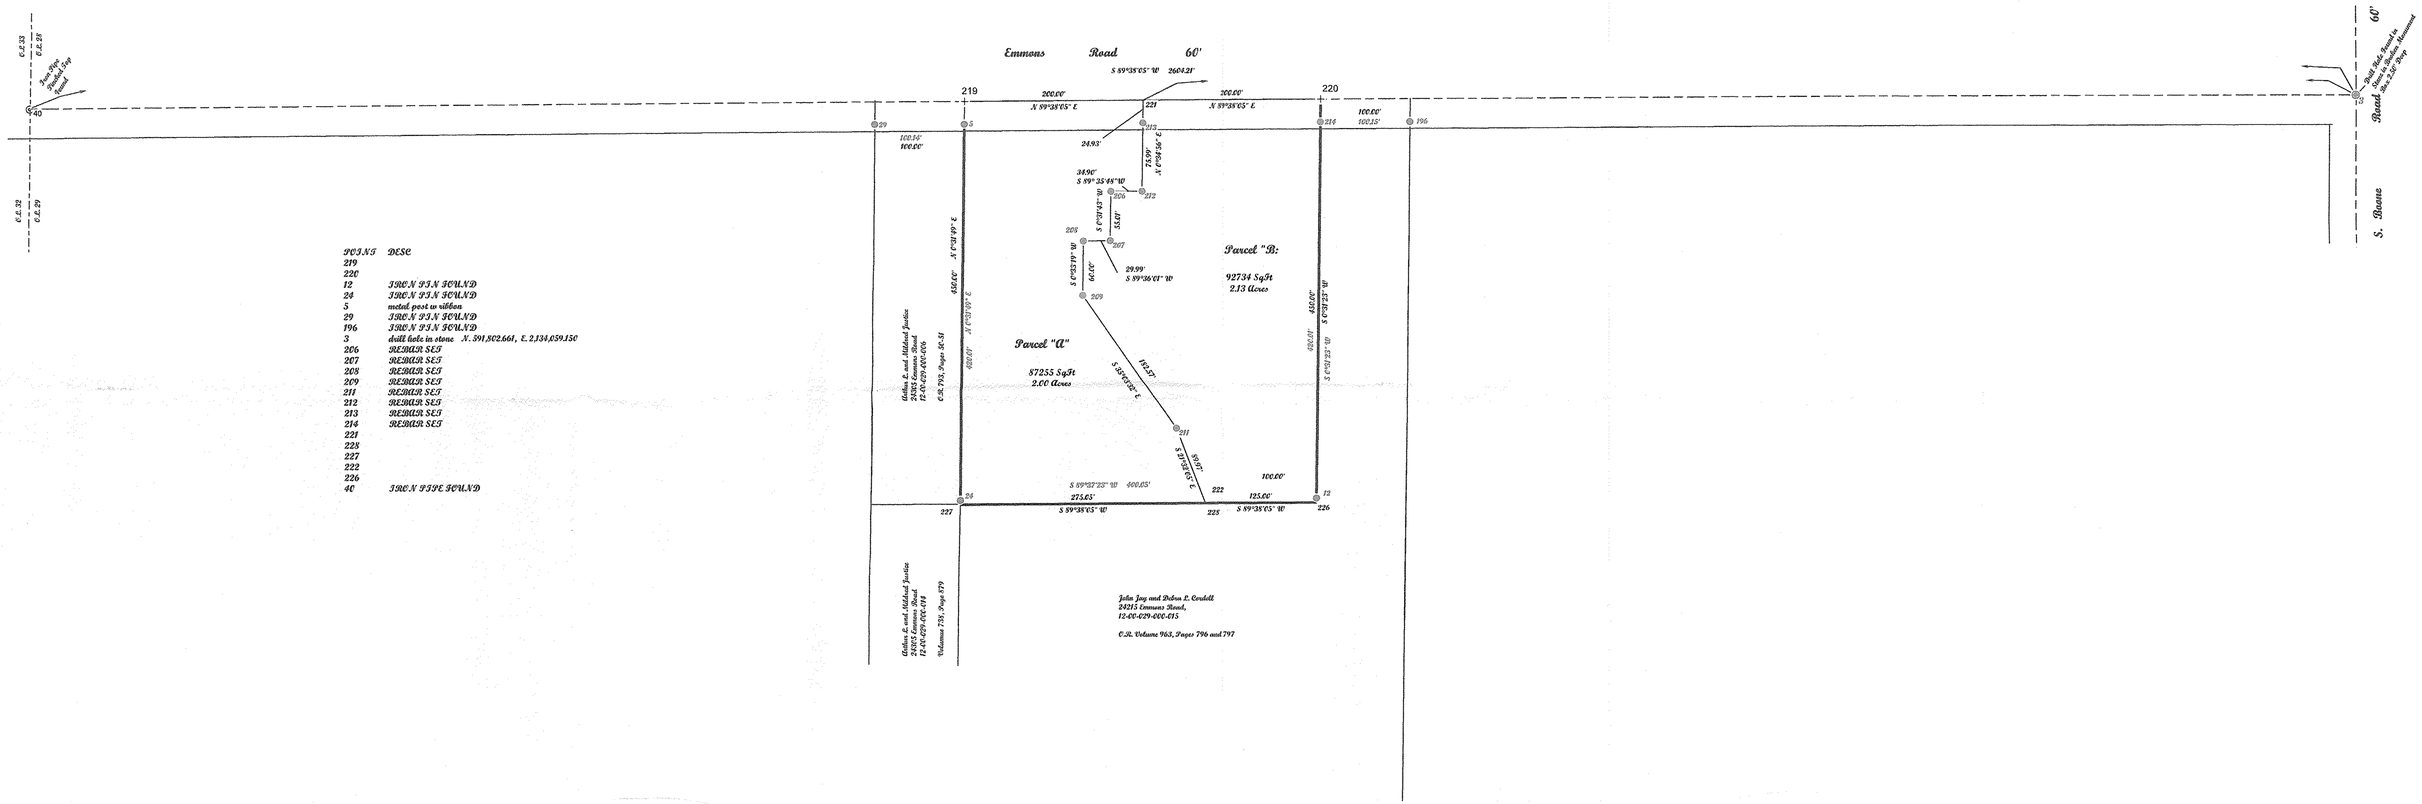

POINTS	DESC
219	
220	
12	IRON IN IRON FOUND
24	IRON IN IRON FOUND
5	metal post w ribbon
29	IRON IN IRON FOUND
196	IRON IN IRON FOUND
3	drill hole in stone N. 591,802.661, E. 2,334,059.150
206	REBAR SET
207	REBAR SET
208	REBAR SET
209	REBAR SET
211	REBAR SET
212	REBAR SET
213	REBAR SET
214	REBAR SET
221	
225	
227	
222	
226	
40	IRON IN IRON FOUND

McGannon Surveying, LLC
Boundary Survey
Patrick A. McGannon
Registered Professional Surveyor
1731 Gettysburg Drive, Lorain, Ohio 44053 (440) 282-2712
www.mcgannonsurveying.com

Note: Only copies signed with Red ink shall be considered Valid.

Patrick A. McGannon P.S. 7154

Prepared for John L. and Susan Cordell of 24251 Emmons Road Columbia Station, Ohio 44028.

P.S.S.O.

STATE OF OHIO
PATRICK A. McGANNON
7154
REGISTERED
PROFESSIONAL SURVEYOR

Note: Dimensions shown in Blue are record values and those shown in red are field observed values.

Cordell.SRV S.N. 1452

№ 03627

APPROVED
LORAIN CO.
MAP DEPT.
DATE 1/19/17
PARCEL 12-00-029
BY T. Spielman
17-03627

SCAN # 49045

Traverse PC