06-24-005-000-056 Scan # 49061

MAP OF SURVEY FOR EDWARD & MARY T. McDANIEL

SITUATED IN THE TOWNSHIP OF ELYRIA, COUNTY OF LORAIN AND STATE OF OHIO; AND KNOWN AS BEbeing PART OF ORIGINAL ELYRIA TOWNSHIP LOT NO. 5, WEST OF BLACK RIVER

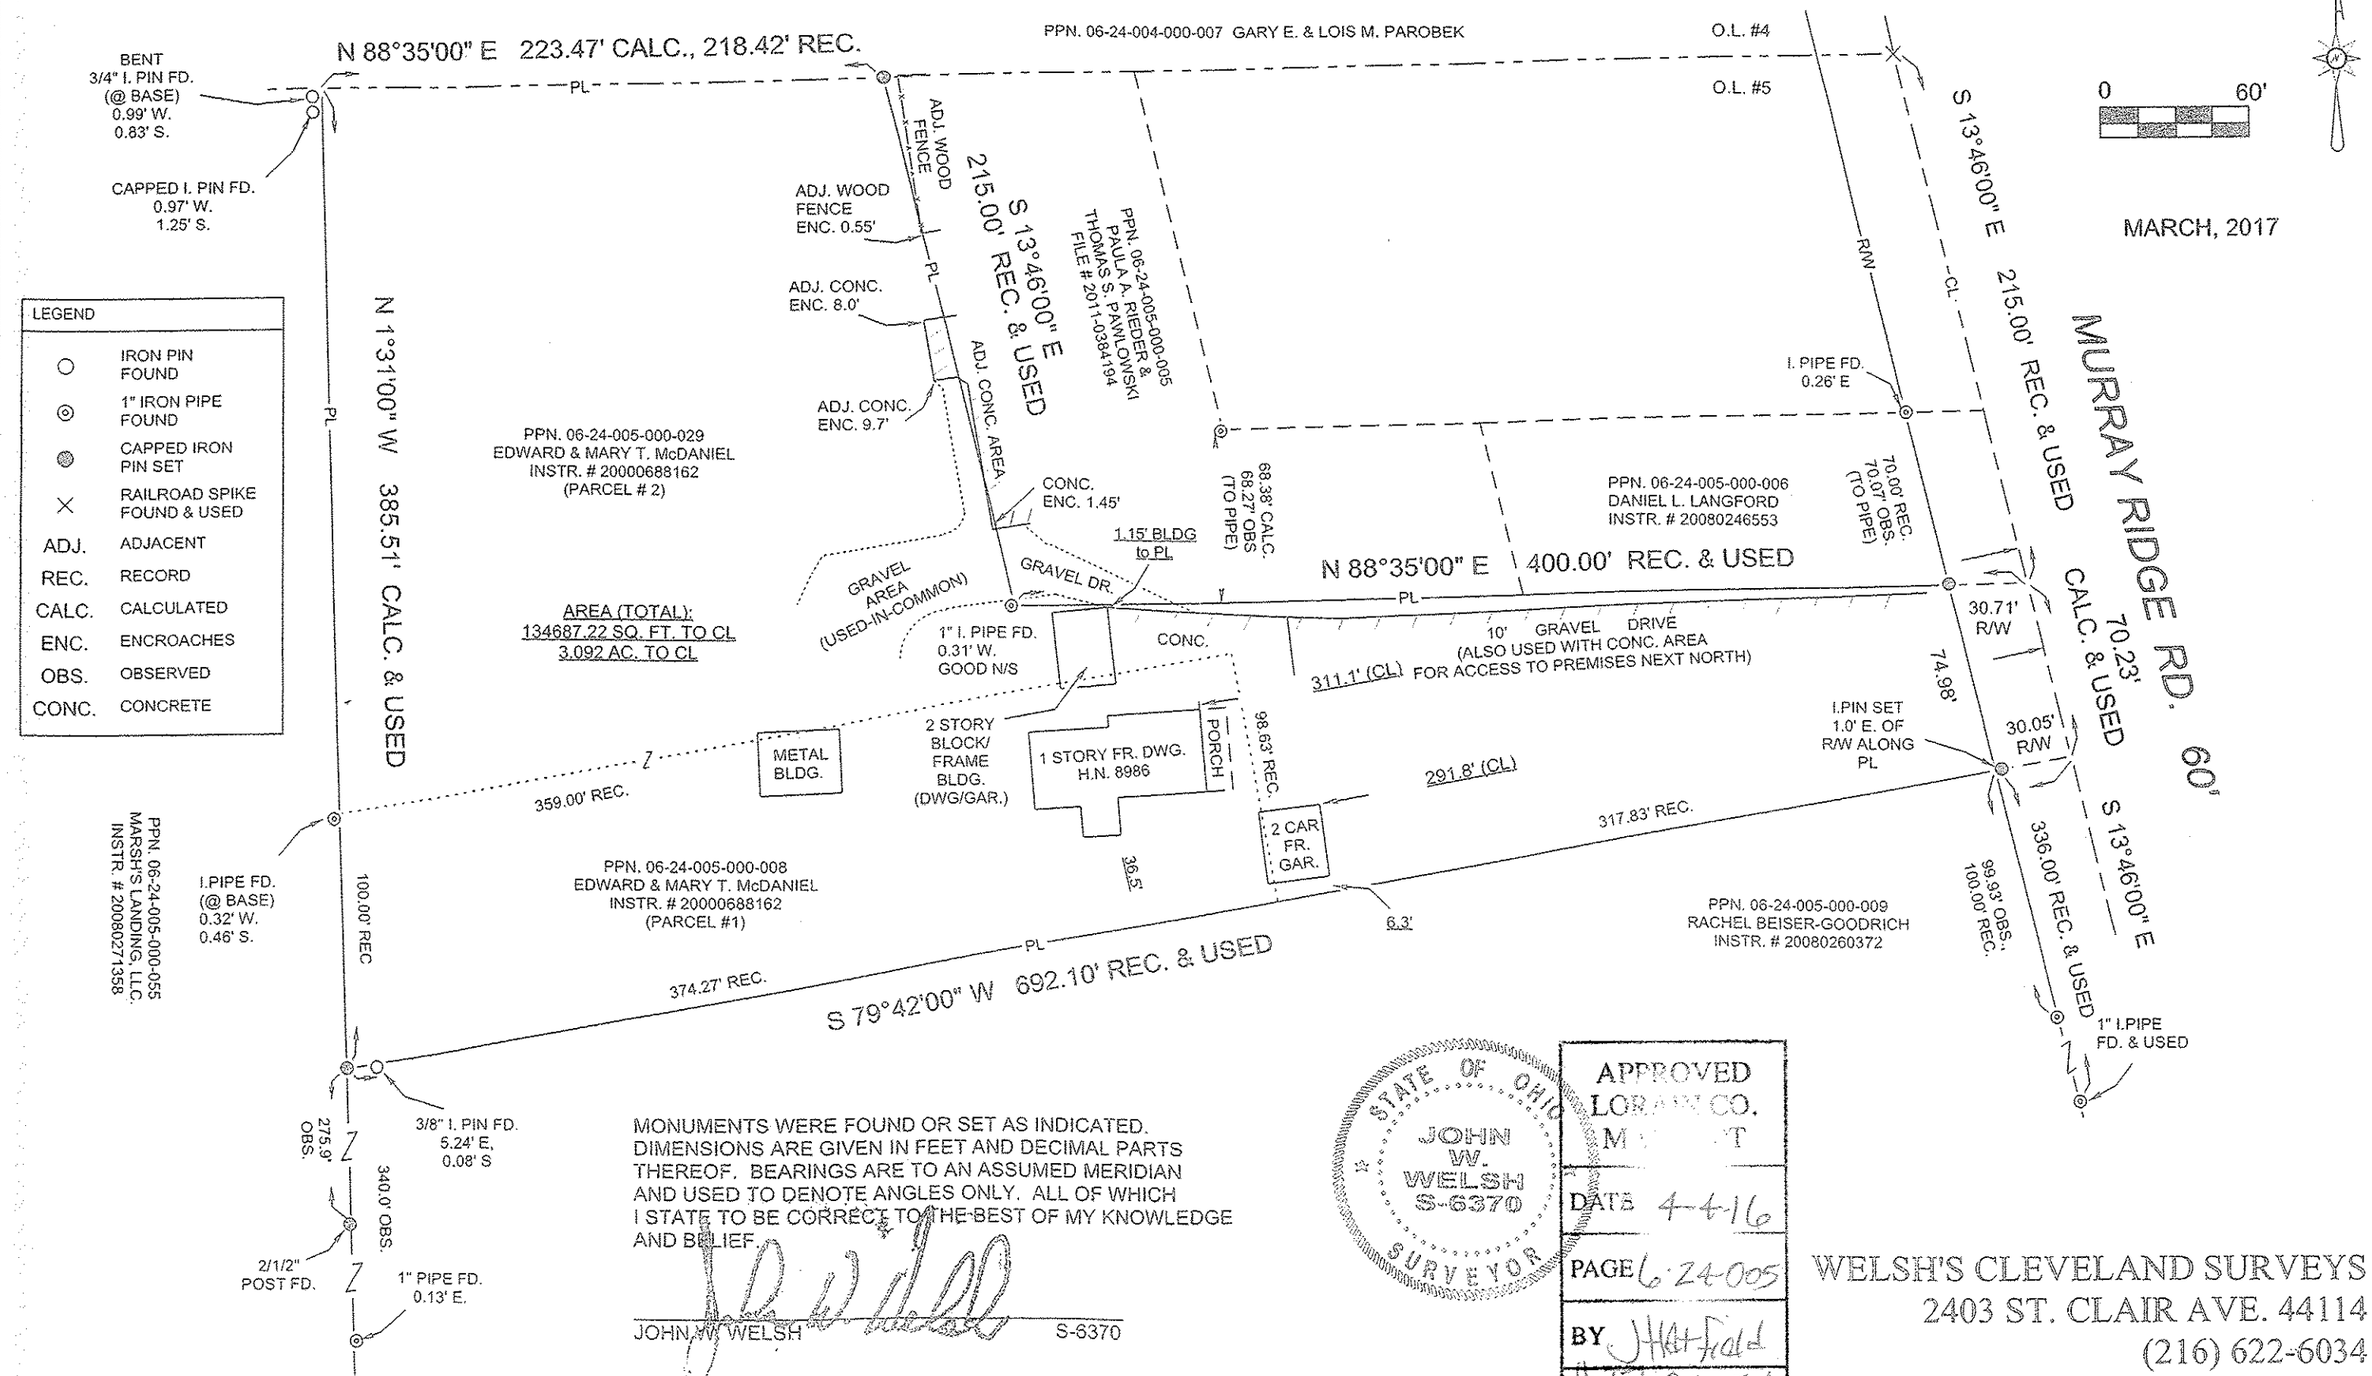

MONUMENTS WERE FOUND OR SET AS INDICATED. DIMENSIONS ARE GIVEN IN FEET AND DECIMAL PARTS THEREOF. BEARINGS ARE TO AN ASSUMED MERIDIAN AND USED TO DENOTE ANGLES ONLY. ALL OF WHICH I STATE TO BE CORRECT TO THE BEST OF MY KNOWLEDGE AND BELIEF.

JOHN W. WELSH S-6370

STATE OF OHIO JOHN W. WELSH S-6370 SURVEYOR

APPROVED LORAIN CO. M[illegible]T
DATE 4-4-16
PAGE 6-24-005
BY JHatfield
#16-03654

WELSH'S CLEVELAND SURVEYS
2403 ST. CLAIR AVE. 44114
(216) 622-6034

Traverse PC