200 0 200 400 600
GRAPHIC SCALE - FEET

-N-

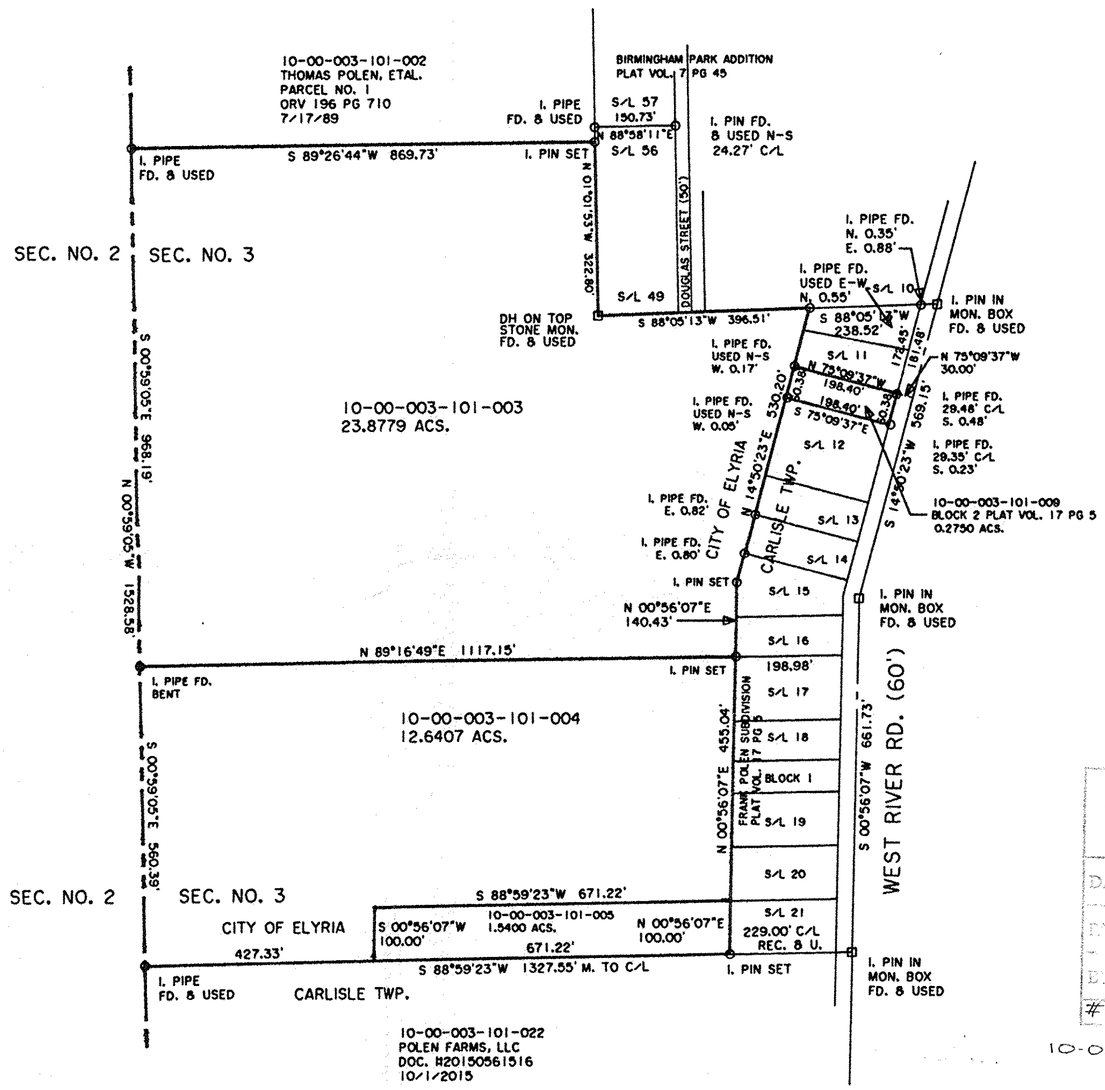

DIMENSIONS SHOWN ON THIS PLAT ARE EXPRESSED IN FEET AND DECIMAL PARTS THEREOF, ALL BEARINGS ARE TO AN ASSUMED MERIDIAN AND ARE USED TO INDICATE ANGLES ONLY. PERMANENT MONUMENTS WERE FOUND OR SET AT ALL POINTS INDICATED HEREON, ALL OF WHICH I CERTIFY TO BE CORRECT.

THOMAS A. SIMON
REG. PROFESSIONAL SURVEYOR
NO. S-7775

BASIS OF BEARINGS IS THE CENTERLINE OF WEST RIVER ROAD (SOUTH 14°50'23" WEST). IRON PINS SET ARE 5/8" DIAMETER, 30" LONG WITH PLASTIC CAPS "T. SIMON, S-7775".

DATE 2-14-17
10-00-003
R. MAINES
#17-03609-D

10-00-003-101-003
-004
-005
-009

PLAT OF BOUNDARY SURVEY FOR JAMES POLEN – PATRICIA SMITH

BEING KNOWN AS PART OF
ORIGINAL CARLISLE TOWNSHIP SECTION NO. 3

PARTLY IN THE CITY OF ELYRIA

COUNTY OF LORAIN STATE OF OHIO
FEBRUARY, 2017 SCALE: 1" = 200'

THOMAS SIMON & ASSOCIATES, INC.
PROFESSIONAL LAND SURVEYORS

150 SOUTH OLIVE STREET
ELYRIA, OHIO 44035

(440) 327-2925
FAX 327-2964

JOB NO. 2017-006