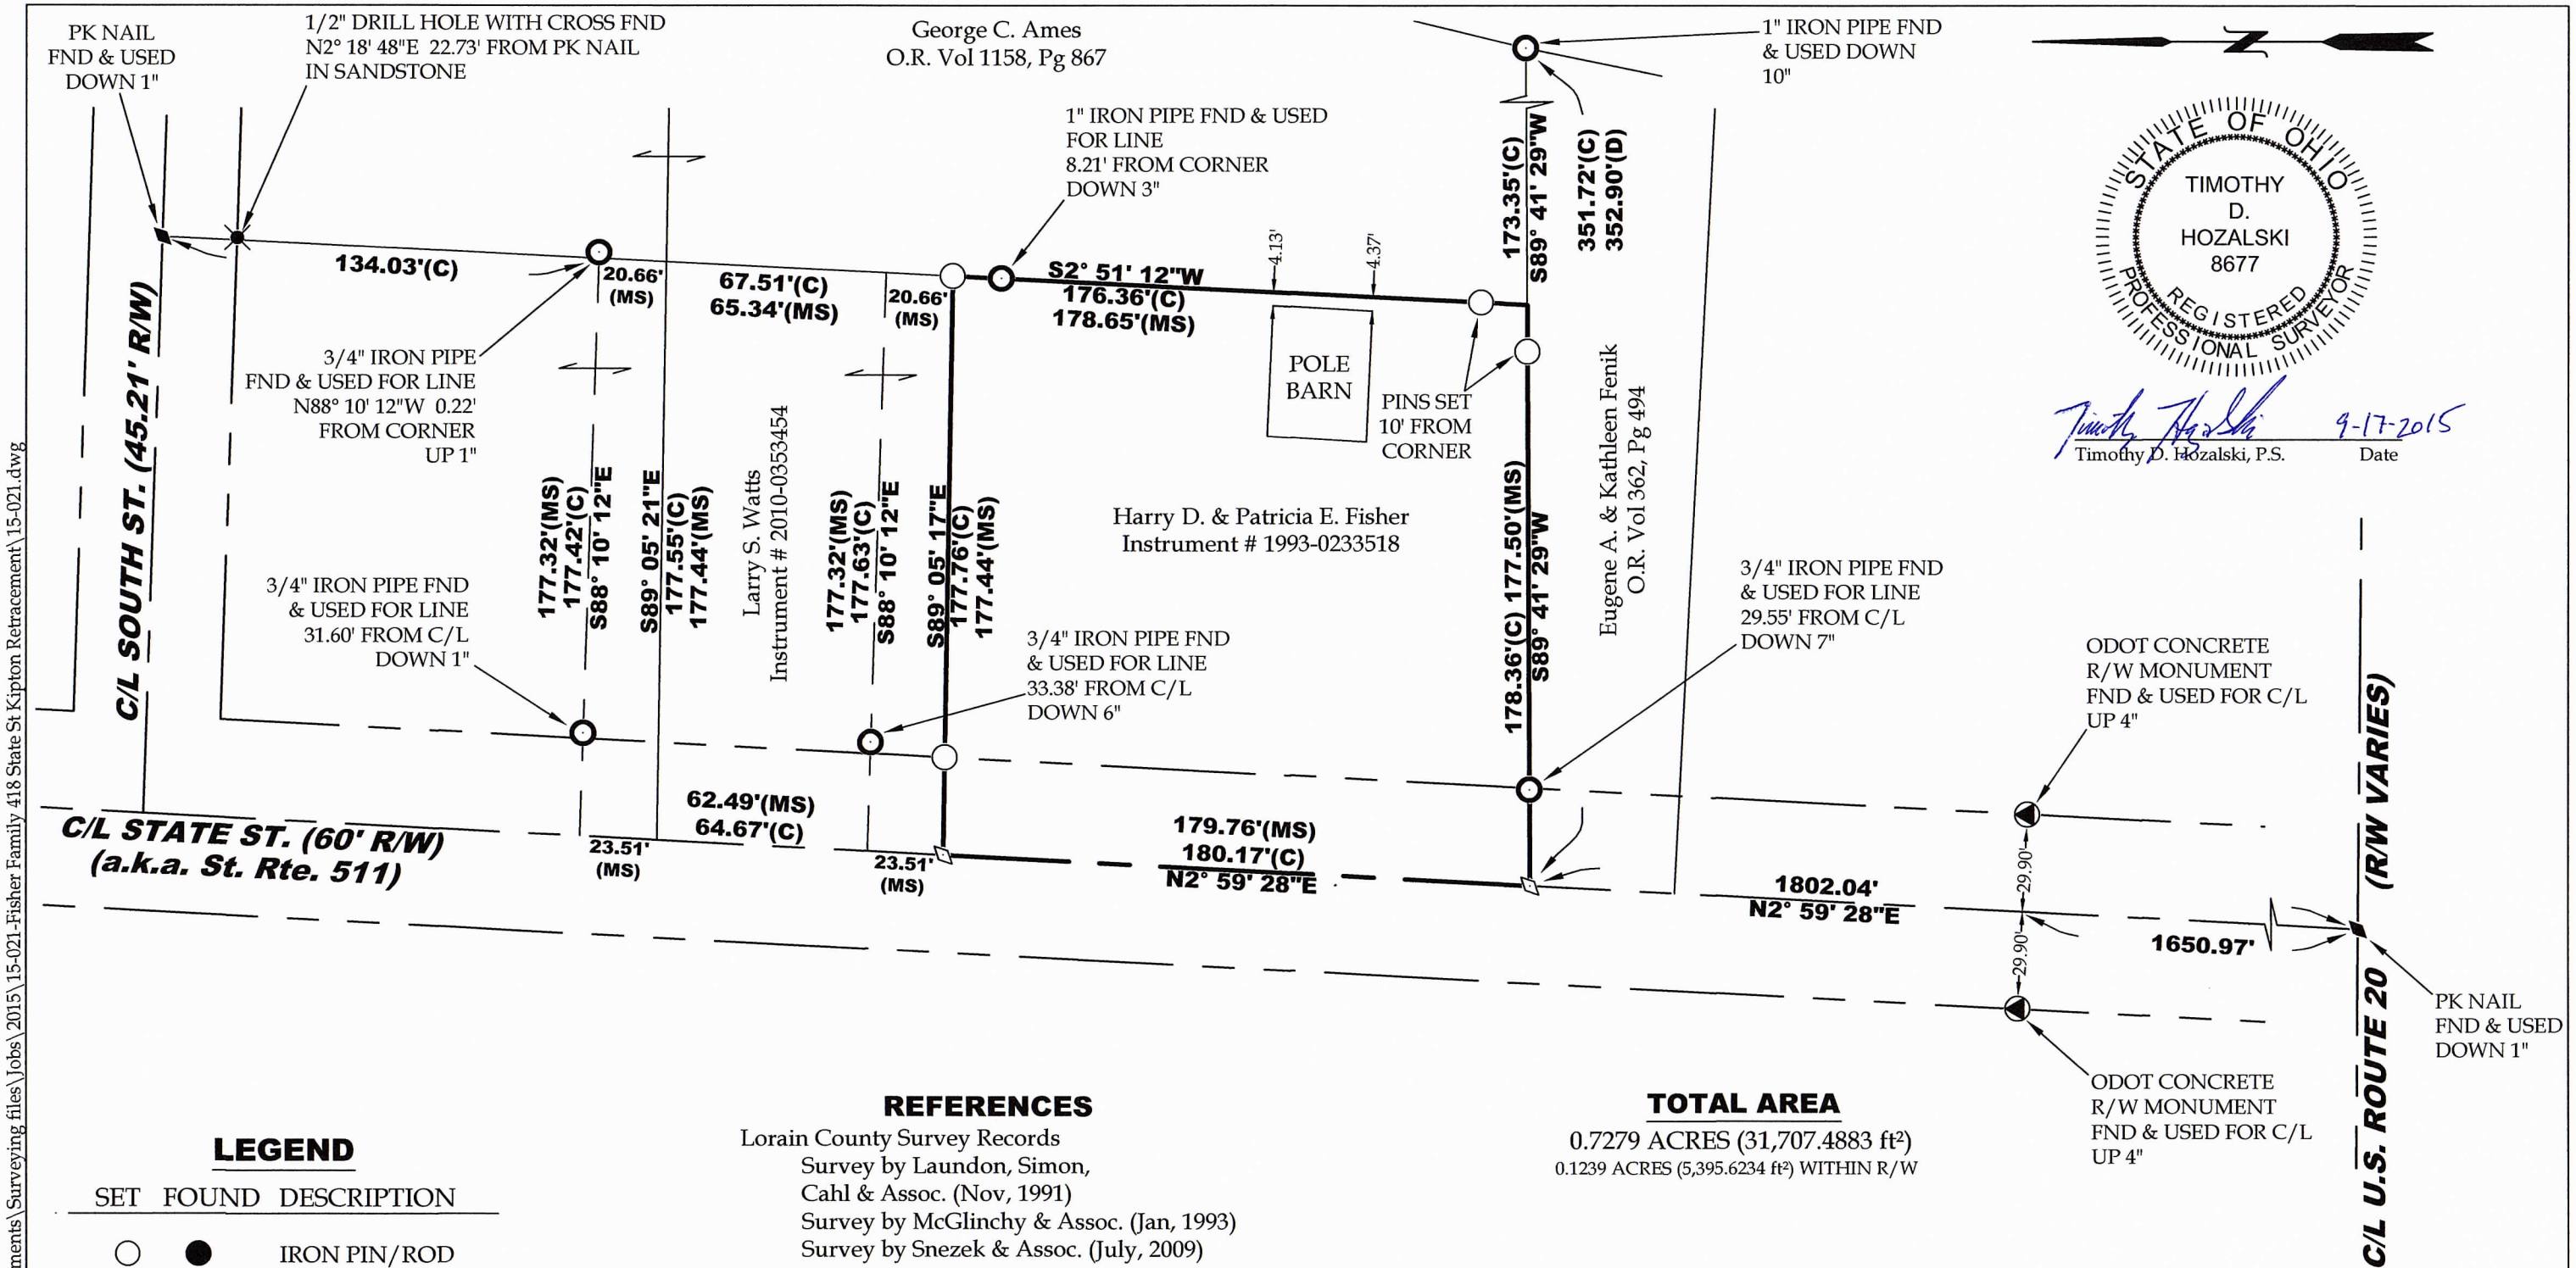

STATE OF OHIO
TIMOTHY D. HOZALSKI 8677
REGISTERED PROFESSIONAL SURVEYOR

Timothy D. Hozalski, P.S. 9-17-2015 Date

LEGEND

SET	FOUND	DESCRIPTION
○	●	IRON PIN/ROD
◊	♦	SURVEY NAIL
⊗	⊗	MAG SPIKE
⌘	⌘	DRILL HOLE
	◕	RAILROAD SPIKE
	▣	MONUMENT BOX
	◭	CONCRETE MONUMENT
	○	IRON PIPE
	▲	STONE
	■	WOOD POST

REFERENCES

Lorain County Survey Records
Survey by Laundon, Simon, Cahl & Assoc. (Nov, 1991)
Survey by McGlinchy & Assoc. (Jan, 1993)
Survey by Snezek & Assoc. (July, 2009)

Lorain County Deed Records
Volume and Pages as indicated

ABBREVIATIONS

(D) PER DEED (M) MEASURED (P) PER PLAT
(C) CALCULATED (MS) PER McGLINCHY SURVEY
(LS) PER LAUNDON SURVEY (SS) PER SNEZEK SURVEY

ALL IRON PINS SET ARE 5/8"x30" REBAR WITH YELLOW PLASTIC CAPS STAMPED "HOZALSKI P.S. 8677/ VECTOR SURVEYING"
ALL DRILL HOLES SET ARE 1/2" IN DIAMETER

TOTAL AREA

0.7279 ACRES (31,707.4883 ft²)
0.1239 ACRES (5,395.6234 ft²) WITHIN R/W

Retracement Survey for
Harry & Patricia Fisher

Being a parcel of land located in part of Original Lot 26, Tract 11, Camden Township, Twp 4 North, Range 19 West, Connecticut Western Reserve, Lorain County, Ohio

SCALE 1"=50'

50 0 50 100

BEARINGS ARE RELATIVE TO THE OHIO STATE PLANE COORDINATE SYSTEM, NORTH ZONE (3401), NAD83(2011), AND CORRECTED VIA THE ODOT VRS

MINIMUM ERROR OF CLOSURE: 1 : 10,000

VECTOR
SURVEYING SERVICES, LLC
OFFICE: 440-865-8445 WAKEMAN, OH
VECTORSURVEYING@YAHOO.COM

Job No.	15-021	Drawn By:	CAD
Date:	Sept, 2015	Checked By:	TDH

File Name: C:\Users\Vector Surveying\Documents\Surveying files\Jobs\2015\15-021-Fisher Family 418 State St Kipton Retracement\15-021.dwg