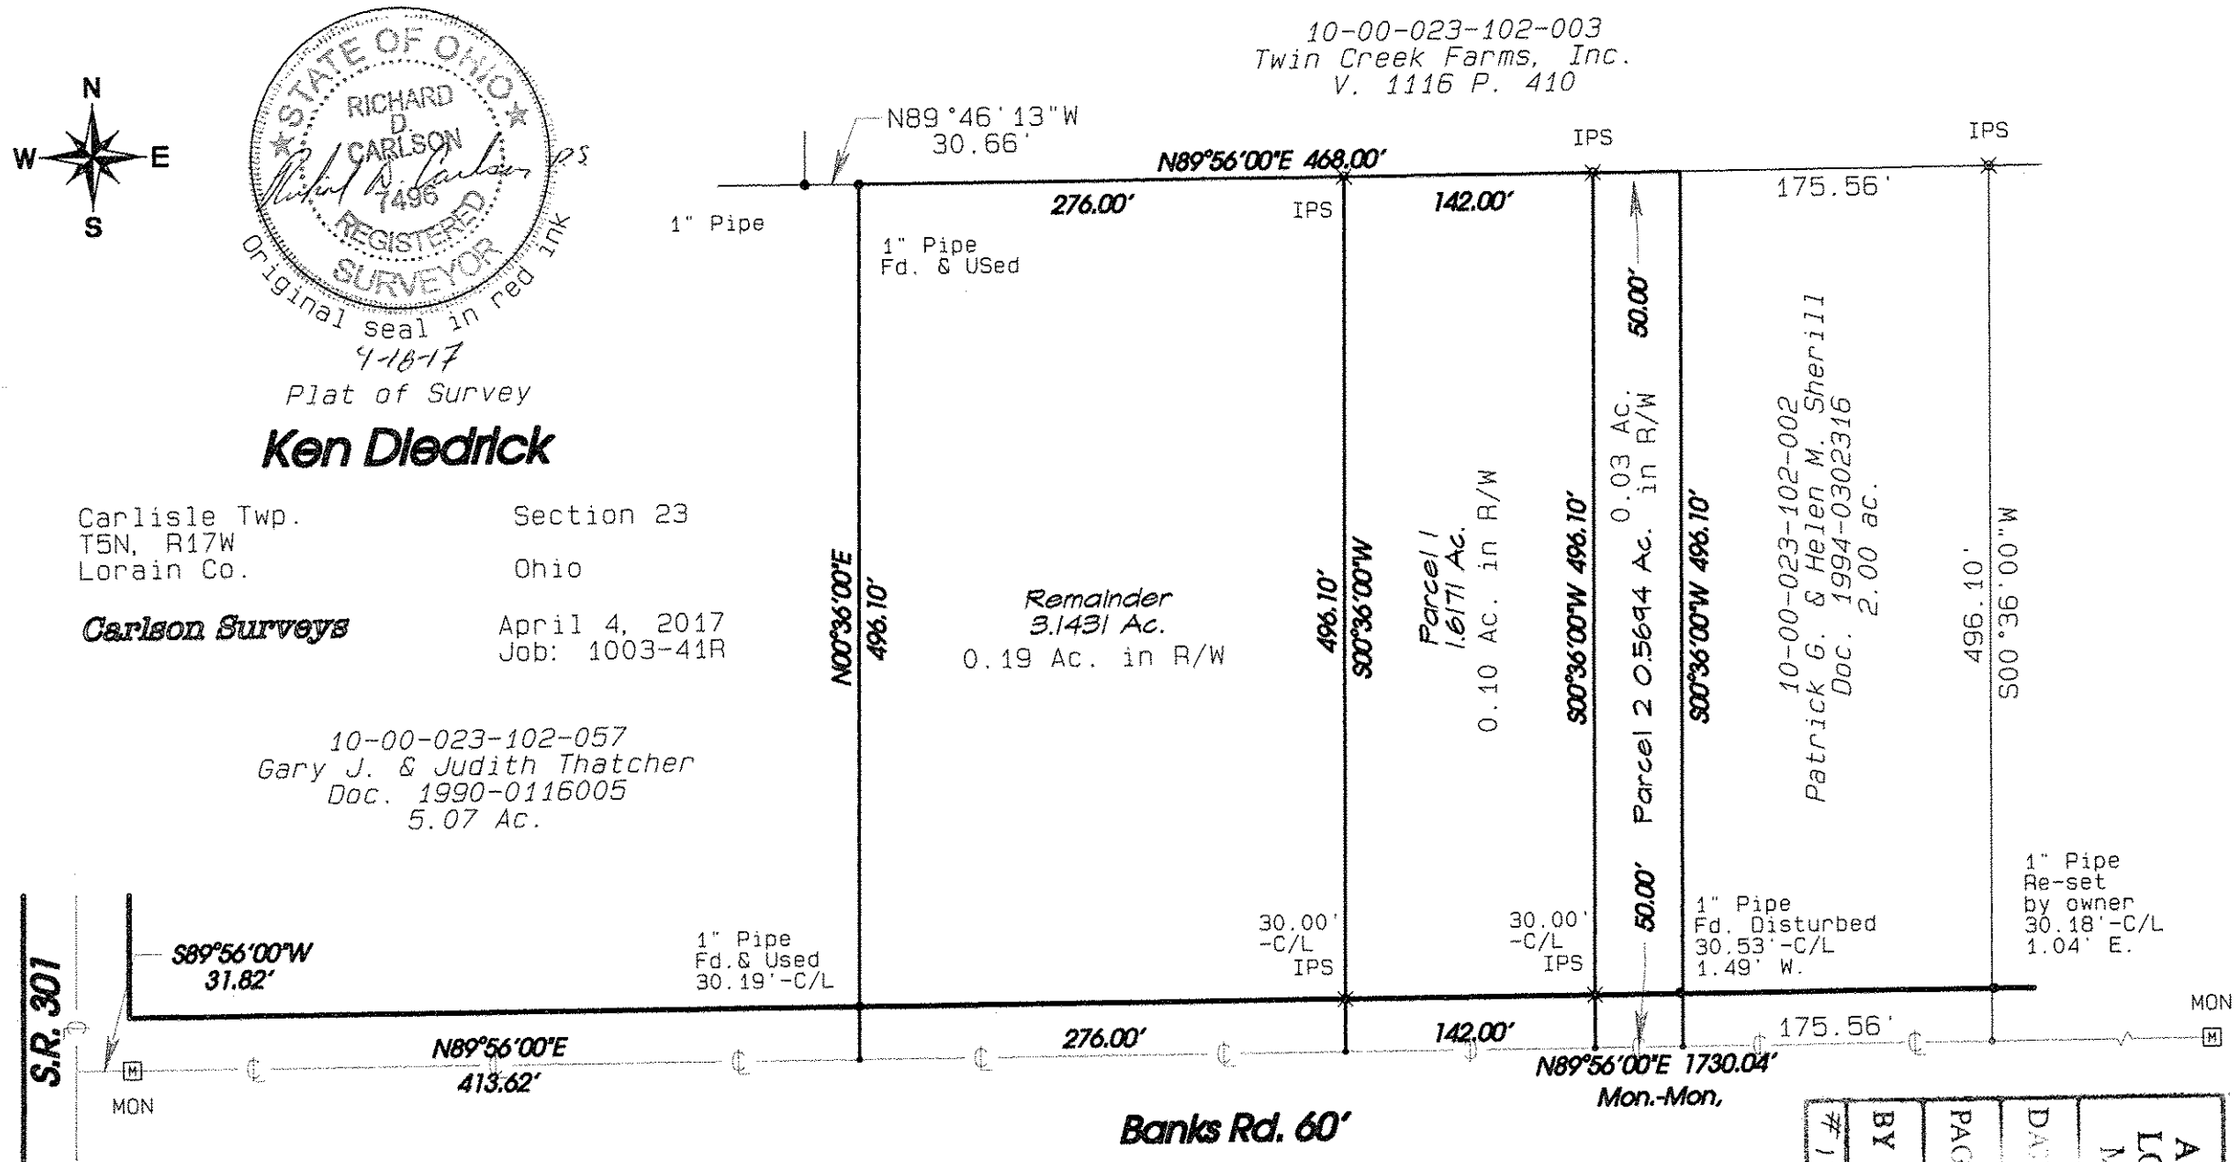

10-00-023-102-069 thru -073