Note: Bearings and coordinates shown are based on the Ohio State Plane but are shown are to describe angles only.

Being known as parts of Original Lots 9 and 12 and Tract 14, of Henretta Township, and know as Lorain County Parcel Numbers, 08-14-009-000-007 and 08-14-012-000-001 in the County of Lorainand the State of Ohio.

Scale 1" = 200'

December 9, 2017

Point Table

POINT	NORTHING	EASTING	DESC
1	602175.01	2018778.48	IRON PIN FOUND IN A MONUMENT BOX garfield and baird
2	600667.12	2018820.30	IRON PIN FOUND IN A MONUMENT BOX garfield and baird east
3	598663.58	2018871.47	IRON PIN FOUND baird 12331
4	598707.97	2015164.55	IRON PIN FOUND IN A MONUMENT BOX gore orphanage 12301
5	600191.58	2015094.46	IRON PIN FOUND IN A MONUMENT BOX gore orphanage north of 12130
6	602469.15	2014861.78	IRON PIN FOUND IN A MONUMENT BOX gore orphanage and garfield
7	601321.36	2015037.98	IRON PIN FOUND IN A MONUMENT BOX gore orphanage 11823
16	600720.32	2015875.38	IRON PIN FOUND
18	600666.99	2018820.31	
19	600393.44	2018827.32	
20	600115.60	2018834.43	
21	599592.75	2018847.83	
22	599599.77	2017094.78	
23	601157.93	2017074.66	
24	601158.67	2017226.70	
25	600795.21	2018344.17	
26	600670.62	2018347.62	
27	600397.07	2018354.63	
28	600393.41	2018827.32	
29	600122.59	2017088.03	
30	600680.34	2017080.83	
31	600722.11	2015067.94	
33	600720.32	2015876.63	
34	601319.57	2015846.68	
35	601319.75	2015767.98	
36	601020.12	2015782.96	
37	601021.73	2015052.96	
38	601316.86	2017072.61	
39	601321.44	2015037.97	
40	601319.88	2015767.97	
41	599632.26	2015120.88	
43	600192.42	2015094.42	
44	598728.47	2015163.58	
45	599069.05	2015147.49	
46	599066.10	2015403.44	
47	598725.52	2015419.53	
48	598684.71	2017106.60	
49	599609.96	2017094.65	
50	600188.62	2017087.18	
52	600695.76	2015069.25	
54	601158.11	2017074.98	REBAR FOUND bent
55	601316.85	2017072.63	REBAR SET
57	601319.55	2015845.65	IRON PIN FOUND
59	600680.38	2017081.03	REBAR FOUND
62	600122.59	2017088.06	REBAR FOUND
63	600188.65	2017087.25	REBAR SET
67	600722.12	2015097.96	REBAR FOUND hunter
68	600695.61	2015087.64	REBAR SET
69	600192.36	2015124.41	REBAR SET
73	0.00	0.00	

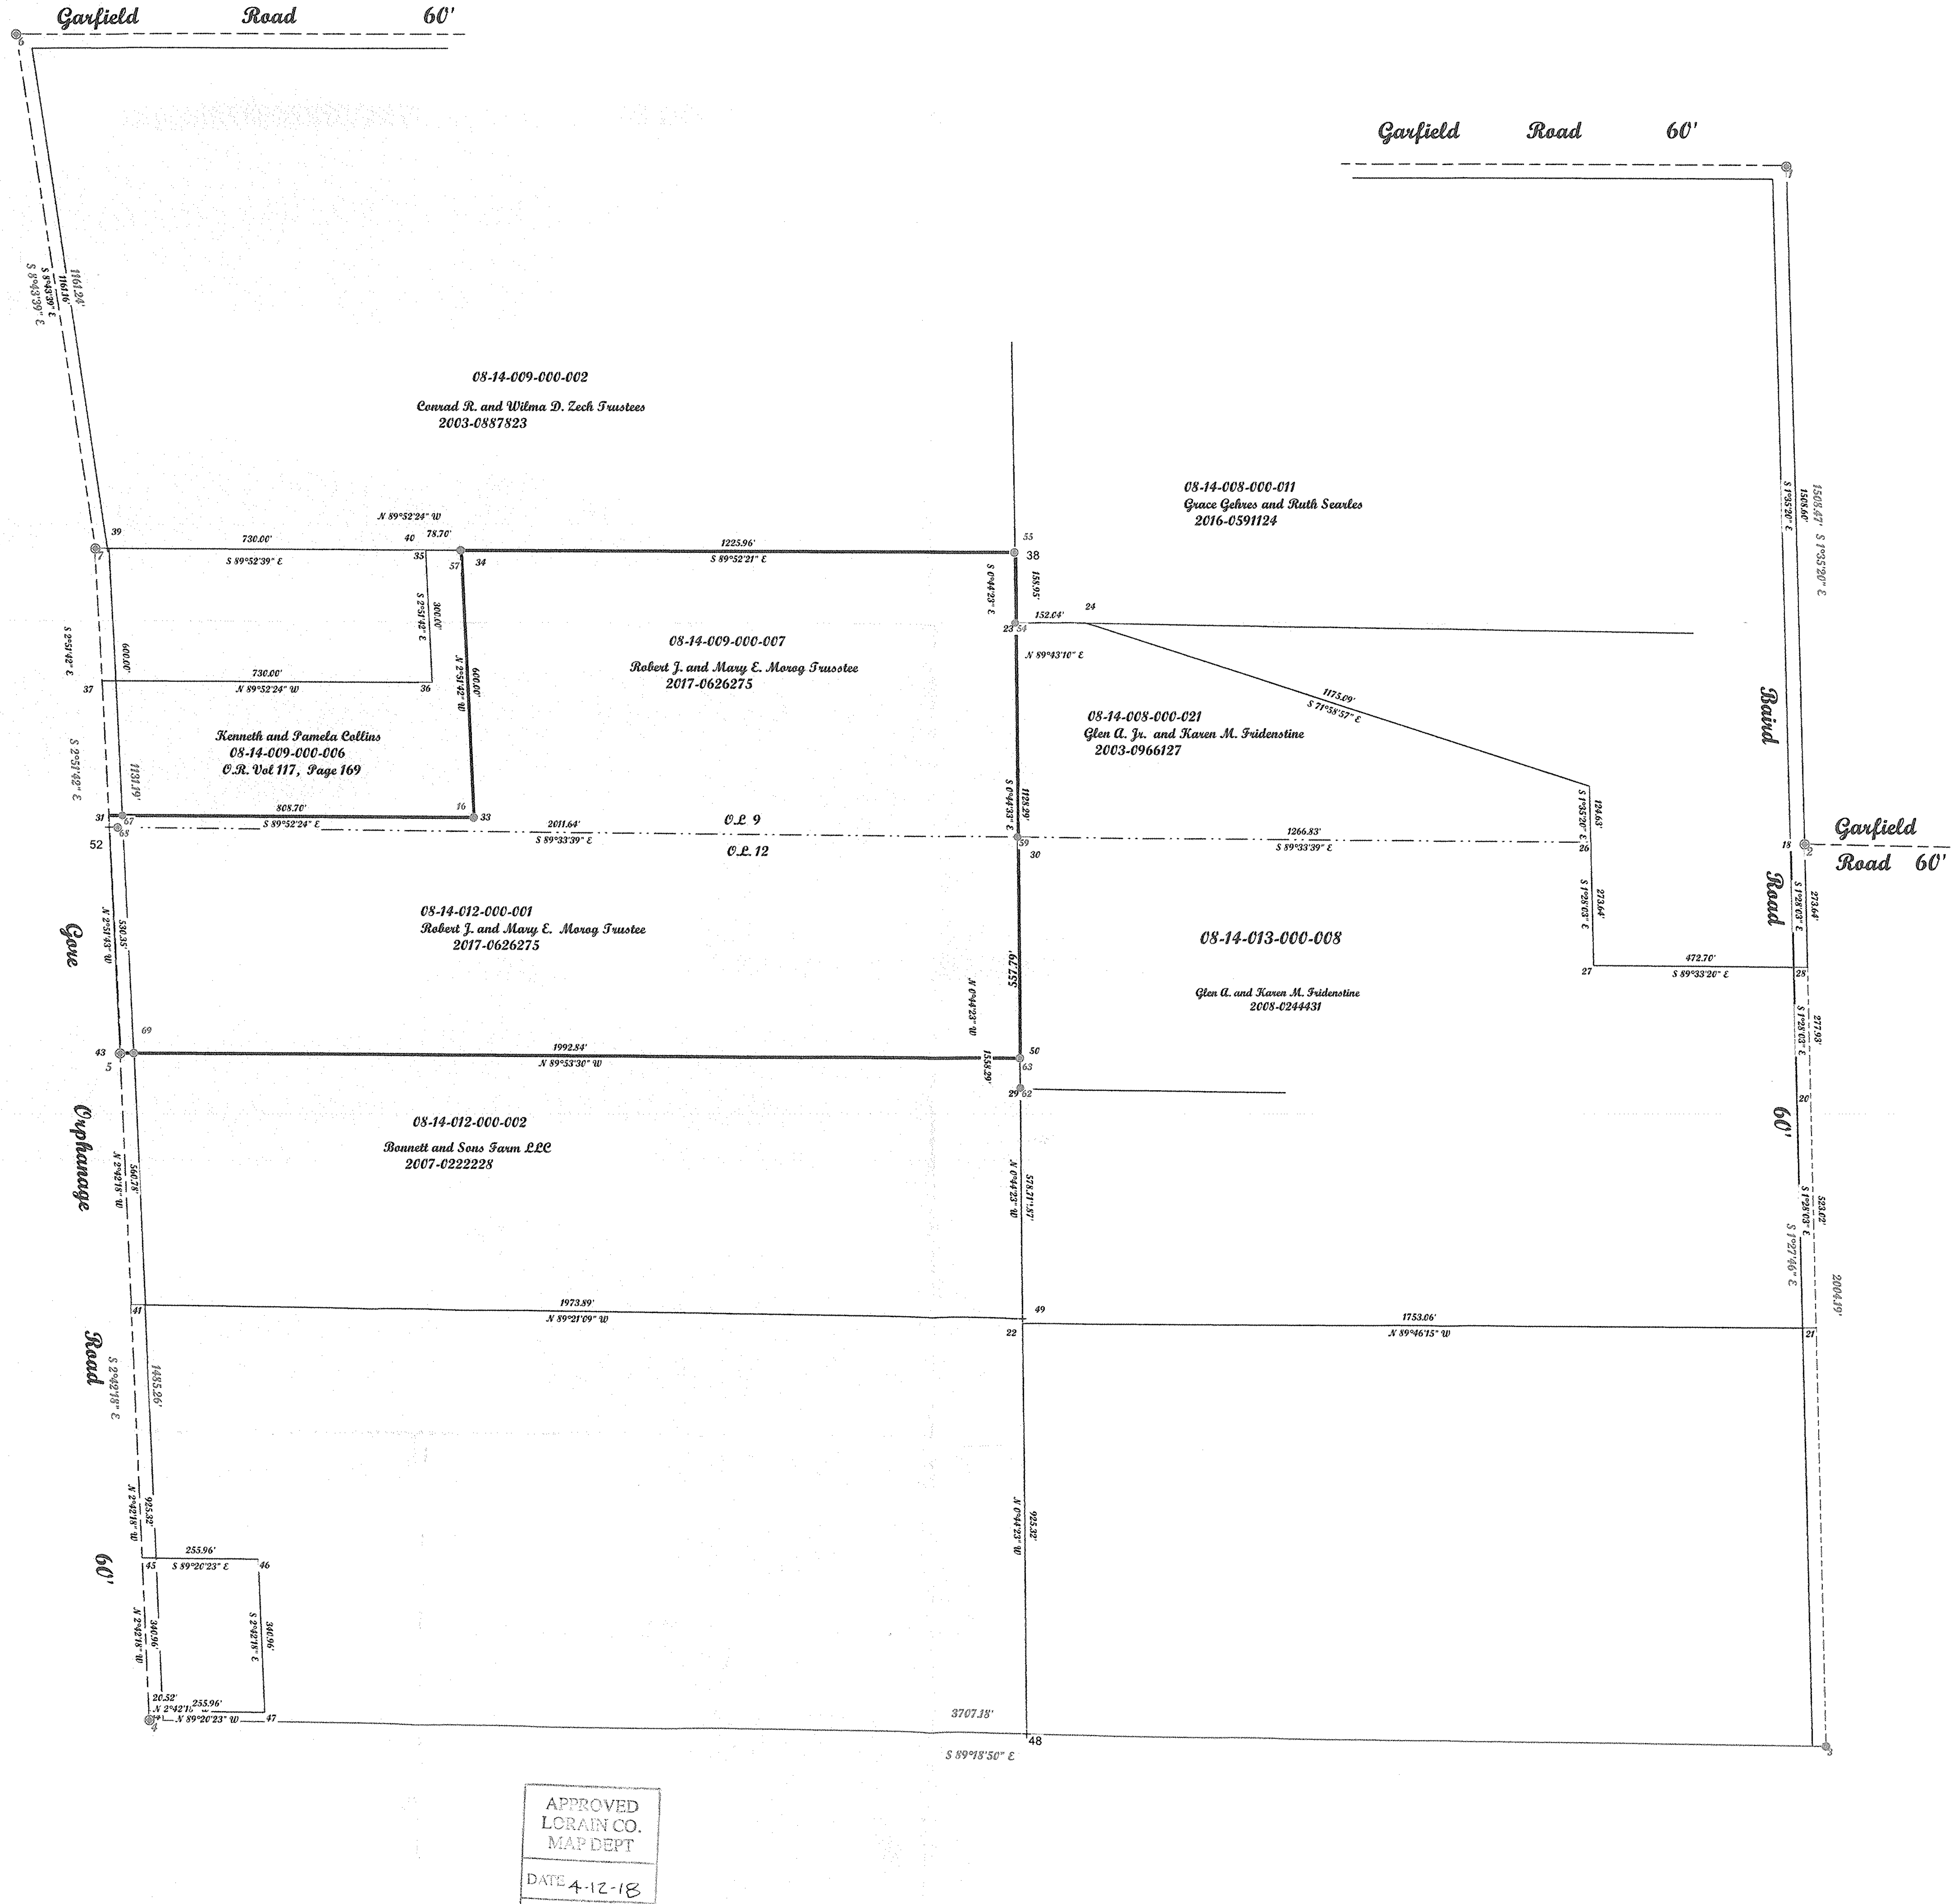

APPROVED LORAIN CO. MAP DEPT
DATE 4-12-18
PAGE 8-A
BY R. MAINES
#18-03870-C

08-14-009-000-007
08-14-012-000-001

McGannon Surveying, LLC
Boundary Survey
Patrick A. McGannon
Registered Professional Surveyor

1731 Gettysburg Drive, Lorain, Ohio 44053 (440) 282-2712
www.mcgannonsurveying.com

Note: Only copies signed with Red ink shall be considered Valid.

Patrick A. McGannon P.S. 7154

Prepared for Robert and Mary Morog of 13020 Green Road, Wakeman Ohio 44889.

P.L.S.O.

STATE OF OHIO
PATRICK A. McGANNON 7154
REGISTERED PROFESSIONAL SURVEYOR

Note: Dimensions shown in Blue are record values and those shown in red are field observed values.

morog2017x.trv F.N. 1568

Traverse PC