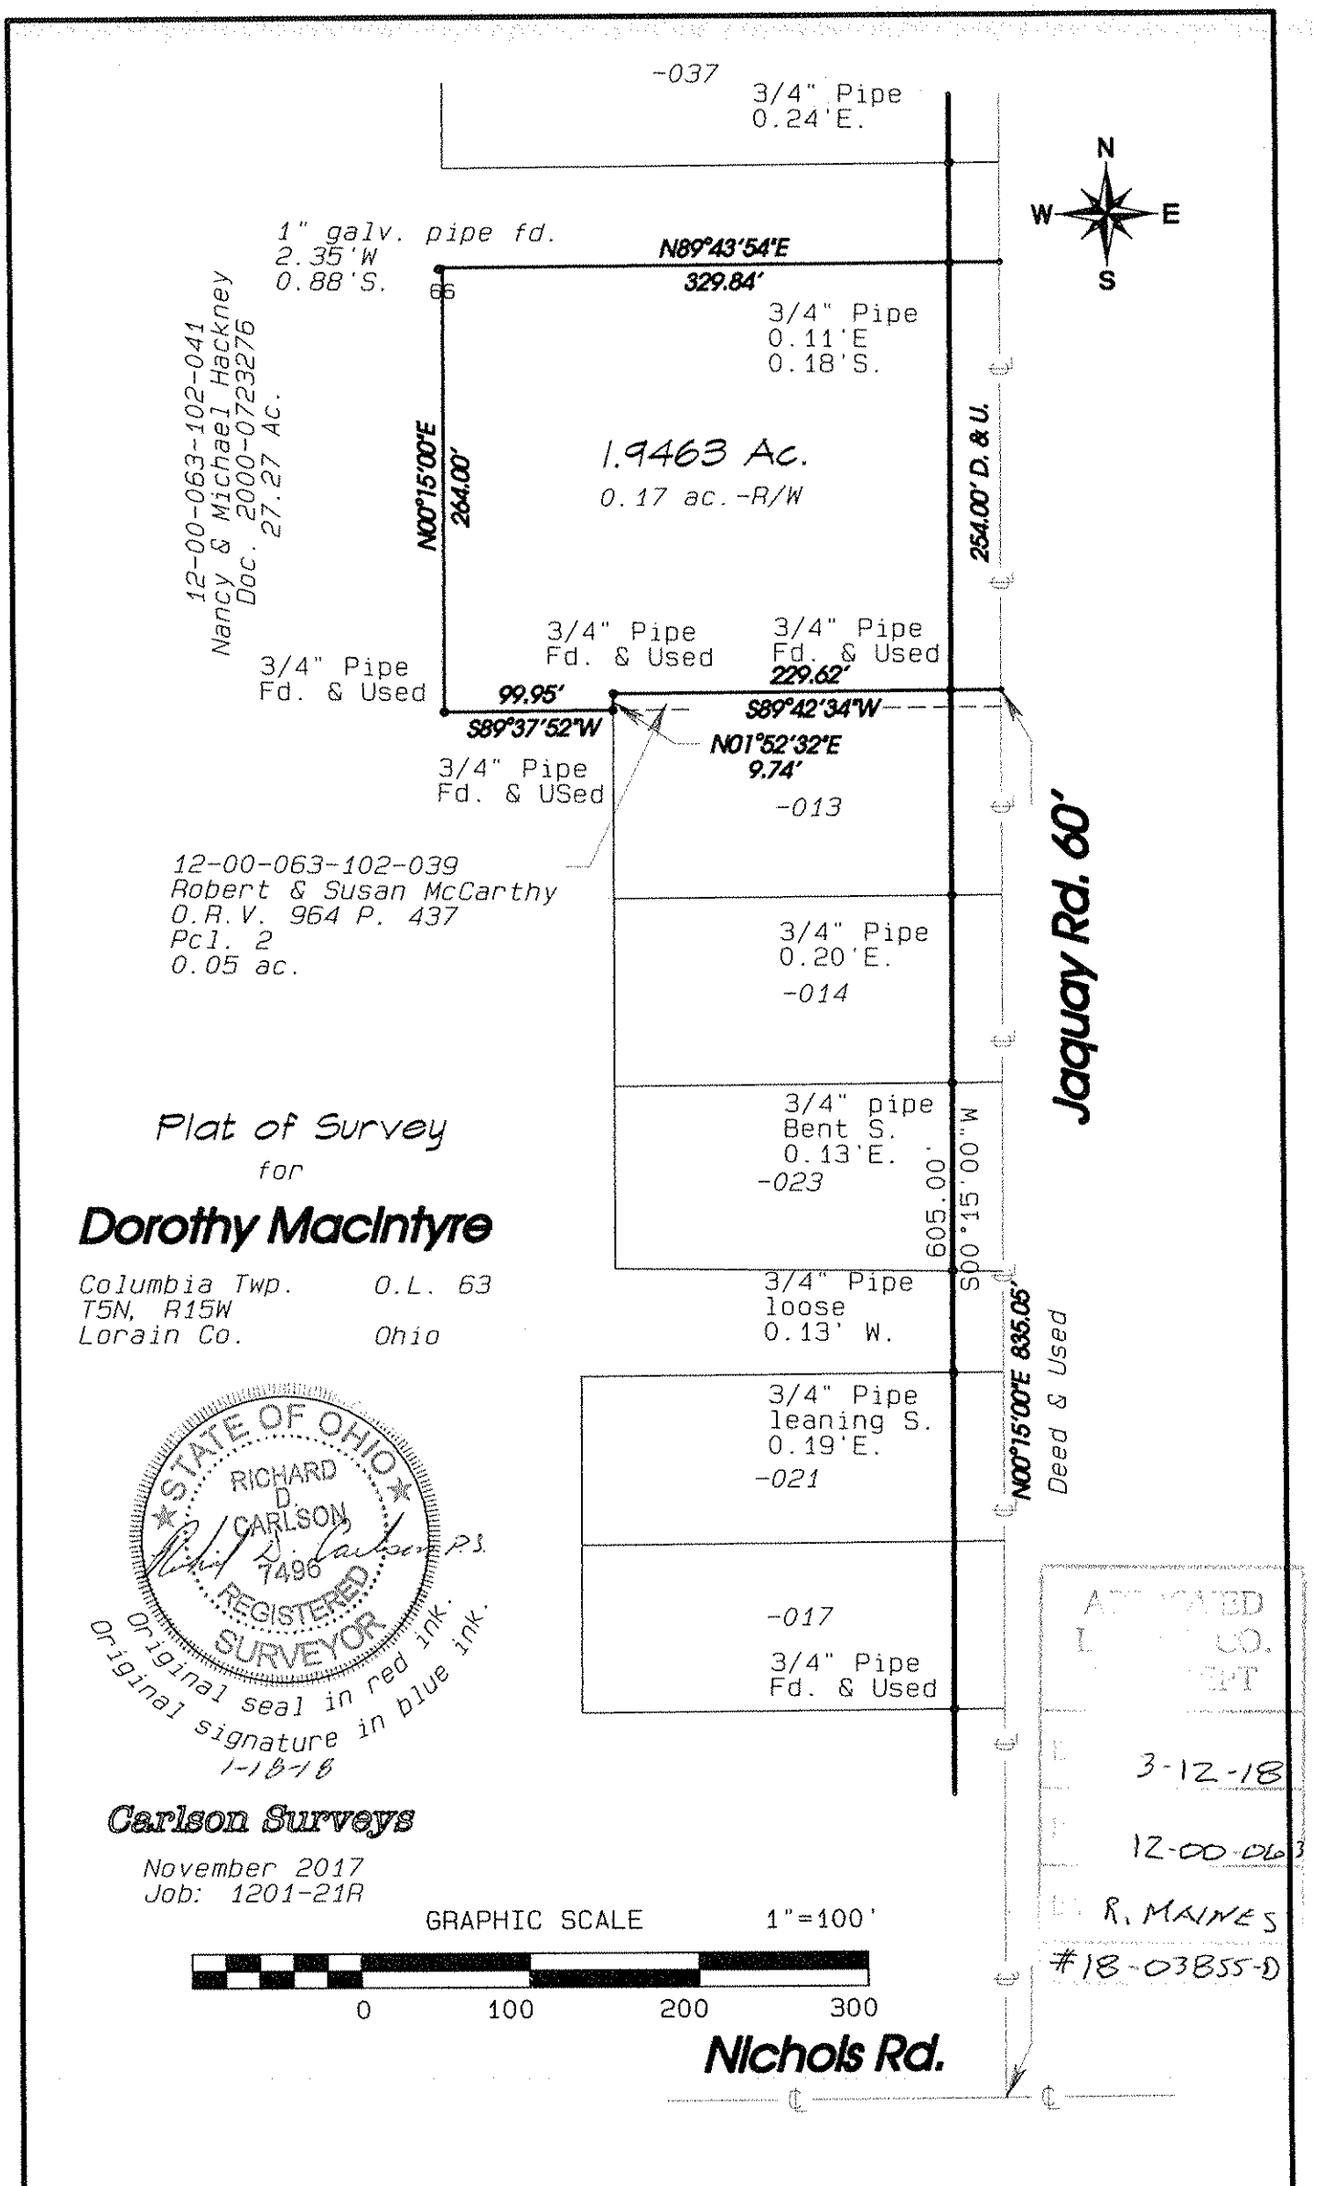


Plat of Survey

for

**Dorothy MacIntyre**

Columbia Twp. O.L. 63
T5N, R15W
Lorain Co. Ohio

STATE OF OHIO
RICHARD D CARLSON
7496
REGISTERED SURVEYOR
P.S.

Original seal in red ink.
Original signature in blue ink.
1-18-18

**Carlson Surveys**

November 2017
Job: 1201-21R

GRAPHIC SCALE 1"=100'

0 100 200 300

**Nichols Rd.**

ATTACHED
L CO.
PT

3-12-18

12-00-063

R. MAINES

#18-03855-D

12-00-063-102-040