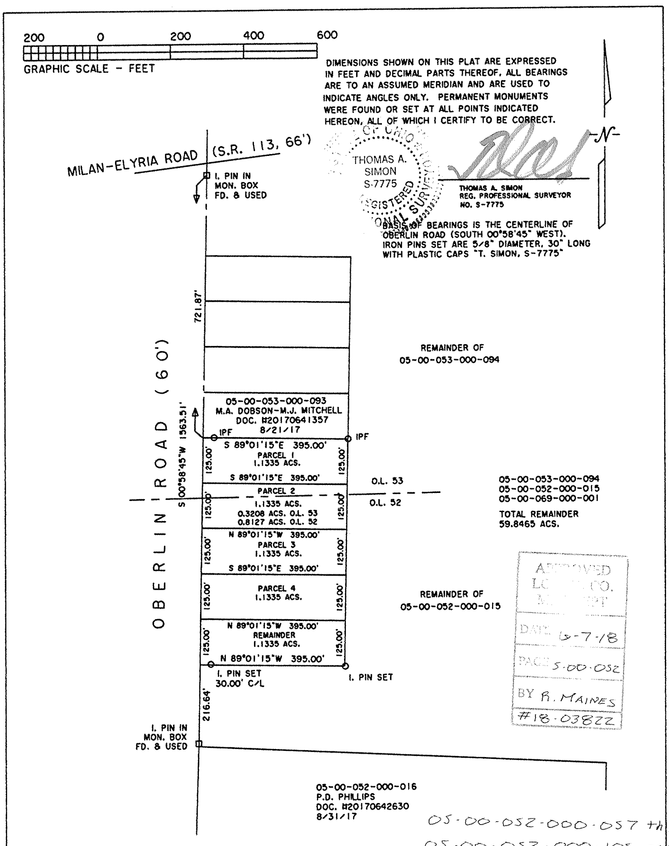

05-00-052-000-057 thru -060
05-00-053-000-105, -106

THOMAS SIMON & ASSOCIATES, INC.
PROFESSIONAL LAND SURVEYORS
150 SOUTH OLIVE STREET
ELYRIA, OHIO 44035
(440) 327-2925
FAX 327-2964

PLAT OF SURVEY & SPLIT

BEING KNOWN AS PARTS OF
ORIGINAL AMHERST TOWNSHIP
LOT NOS. 52 AND 53

COUTH OF LORAIN STATE OF OHIO
APRIL, 2018 SCALE: 1" = 200'

JOB NO. 2018-008