

PEARL R. MYERS
PPN. 0624040101001

PEARL R. MYERS
PPN. 0624044102004

ROSE GAINER VAN AMBURGH
& WICKY C. SCARBROUGH
PPN. 0624044102005

JAMES P. MALONEY, JR. &
EVELYN A. MALONEY
PPN. 0624044102006

JAMES T. POZENEL
PPN. 0624044102007

MELVIN NOBLE & SARAH B. NOBLE
INST. NO. 2017-0649558
PPN. 06-24-040-101-045
PPN. 06-24-044-102-020
3.574 AC.

CHARLES R. MYERS, JR.
&
PATRICIA D. MYERS
PPN. 0624040101047

JOHN & MARY BLAZ
PPN. 0624044102017

LINDA FRINGSSTEN
PPN. 0624040101043
S-8396

213.81'-M.
N 00°40'00" W

219.94'-D.
219.72'-M.
S 89°14'33" W

214.41'-D.
213.81'-M.
N 00°38'38" W

215.00'-D.
214.72'-O.
N 00°38'38" W

32.27'-D.&C.
S 89°20'45" W

ACE JOVANOVSKI
PPN. 0624040101048

319.84'-D.
320.22'-M.
S 00°47'33" E

319.80'-D.
319.97'-O.
S 00°37'57" E

REF=24.94'

REF=24.87'

REF=24.94'

140.00'-D.&C.
N 89°20'45" E

Q ADELBERT STREET



- LEGEND**
- C - CALCULATED
 - M - MEASURED
 - O - OBSERVED
 - D - DEEDED
 - - IRON PIN/PIPE FOUND
 - △ - MAGNAIL SPIKE FOUND
 - - IRON PIN SET-5/8" REBAR SET WITH I.D. CAP STAMPED "RAMSEY S-8396"

Distances shown hereon are expressed in feet and decimal parts thereof.

Bearings are to an assumed meridian and are used to express angles only.


CERTIFICATION: I hereby state that the foregoing survey was prepared from actual field measurements, in accordance with Chapter 4733-37, Ohio Administrative Code.

By: *Nathaniel B. Ramsey* Date: *5/12/2018*

Nathaniel B. Ramsey, P.S. 83306
For Ramsey Surveying

0' 50' 100' 200'

SCALE: 1" = 100'

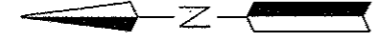

RAMSEY SURVEYING
Professional Land Surveying Services

288 Eby Road
Cincinnati, OH 45226
TEL (513) 512-2336 FAX (513) 524-0399
EMAIL: nramsey@ramsey-surveying.com

SURVEY MADE AT THE REQUEST OF
MELVIN & SARAH NOBLE

PART OF ORIGINAL ELVIRA TOWNSHIP LOT NO'S. 40 & 44
WEST OF THE BLACK RIVER ELVIRA TOWNSHIP LORAIN
COUNTY, OHIO

DATE: 05/12/2018
JOB NO: SM-5255
SHEET 1 OF 1