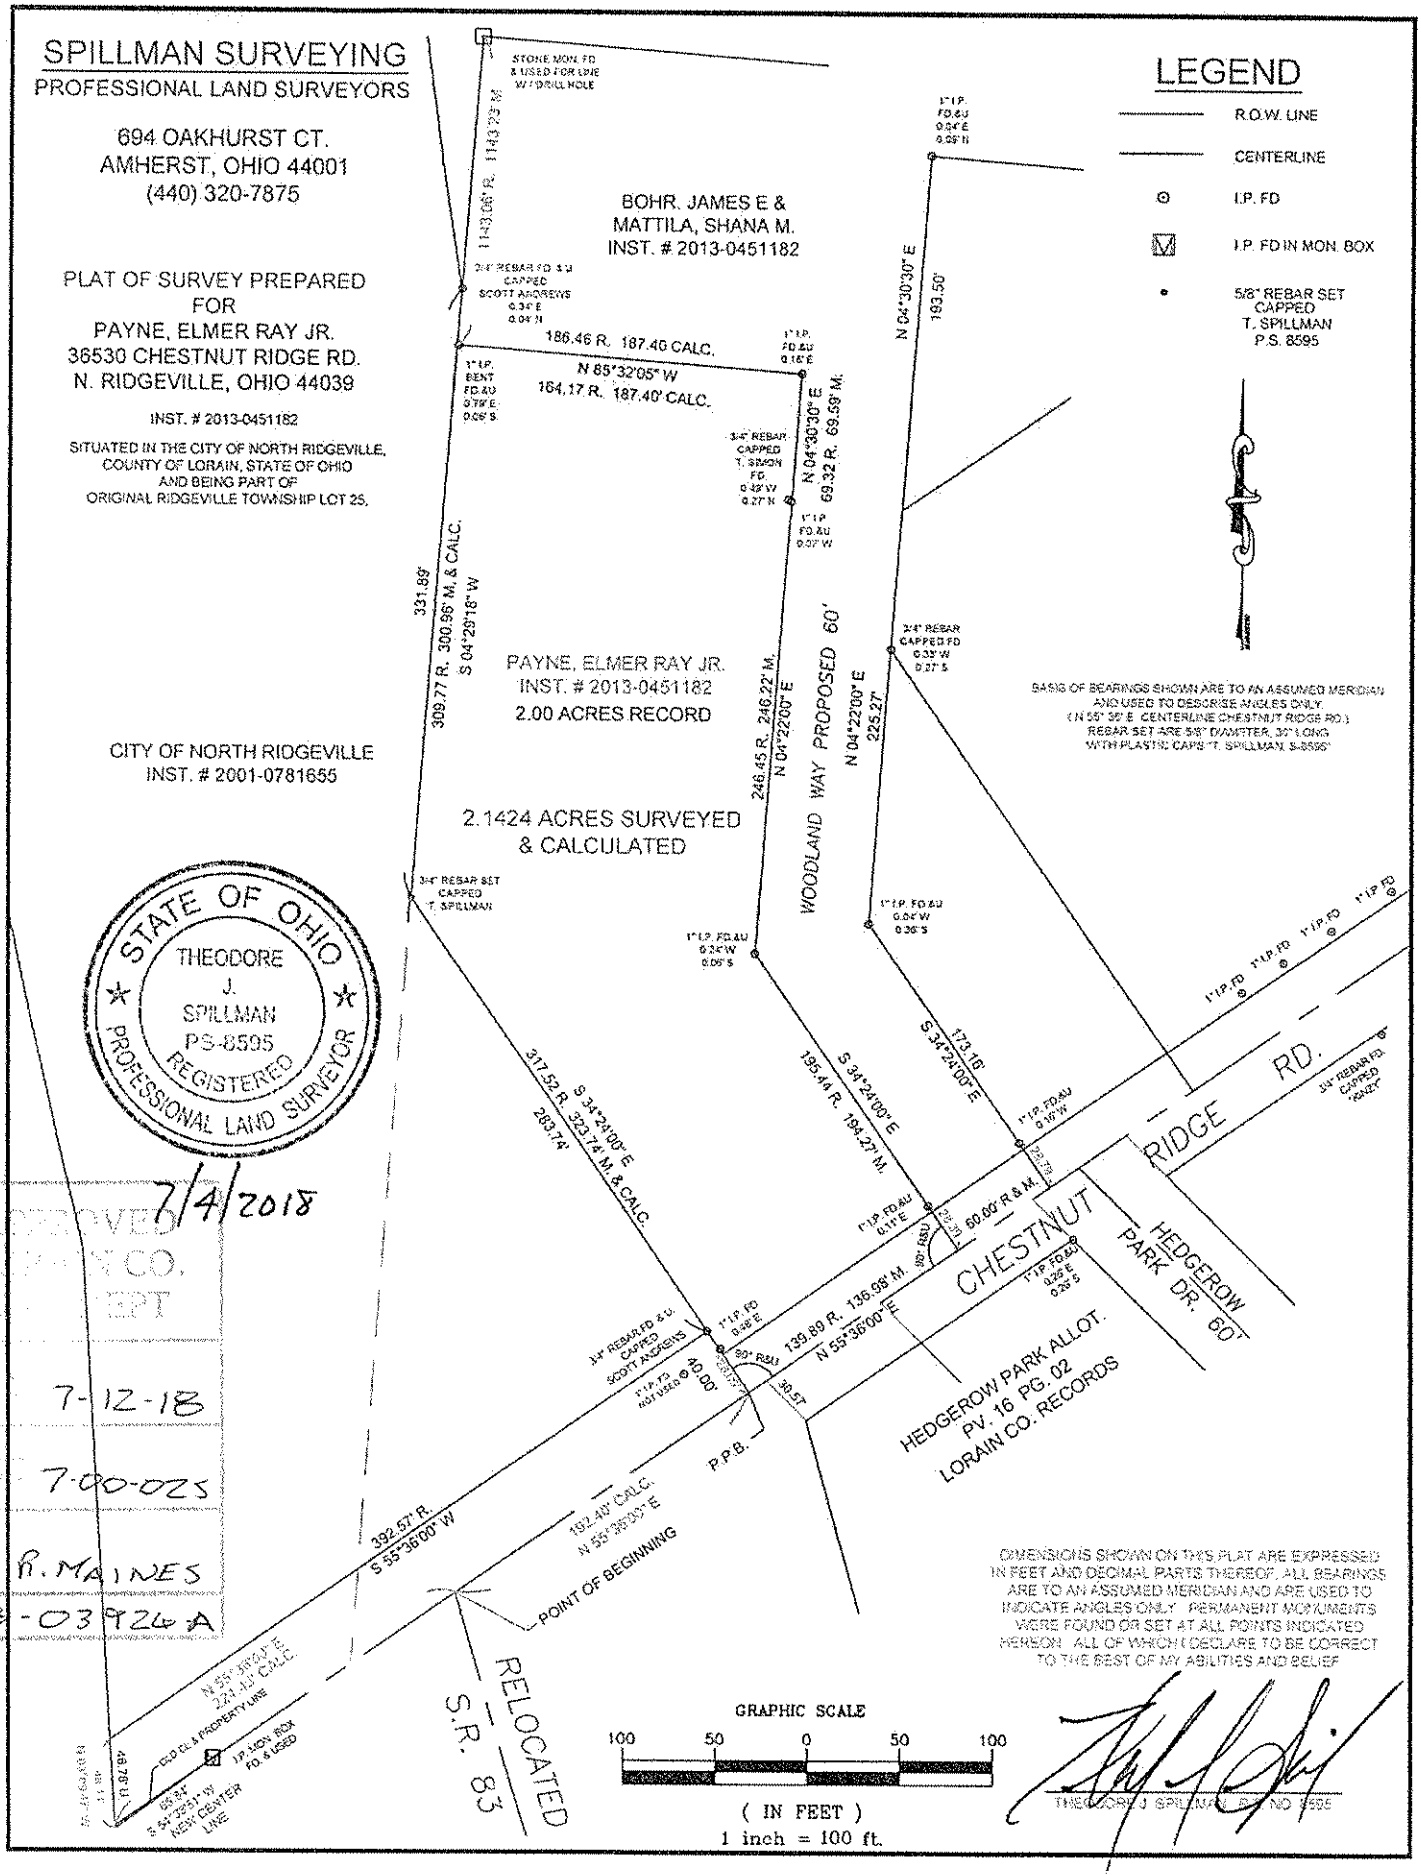

07-00-025-101-029