02-02-005-108-029

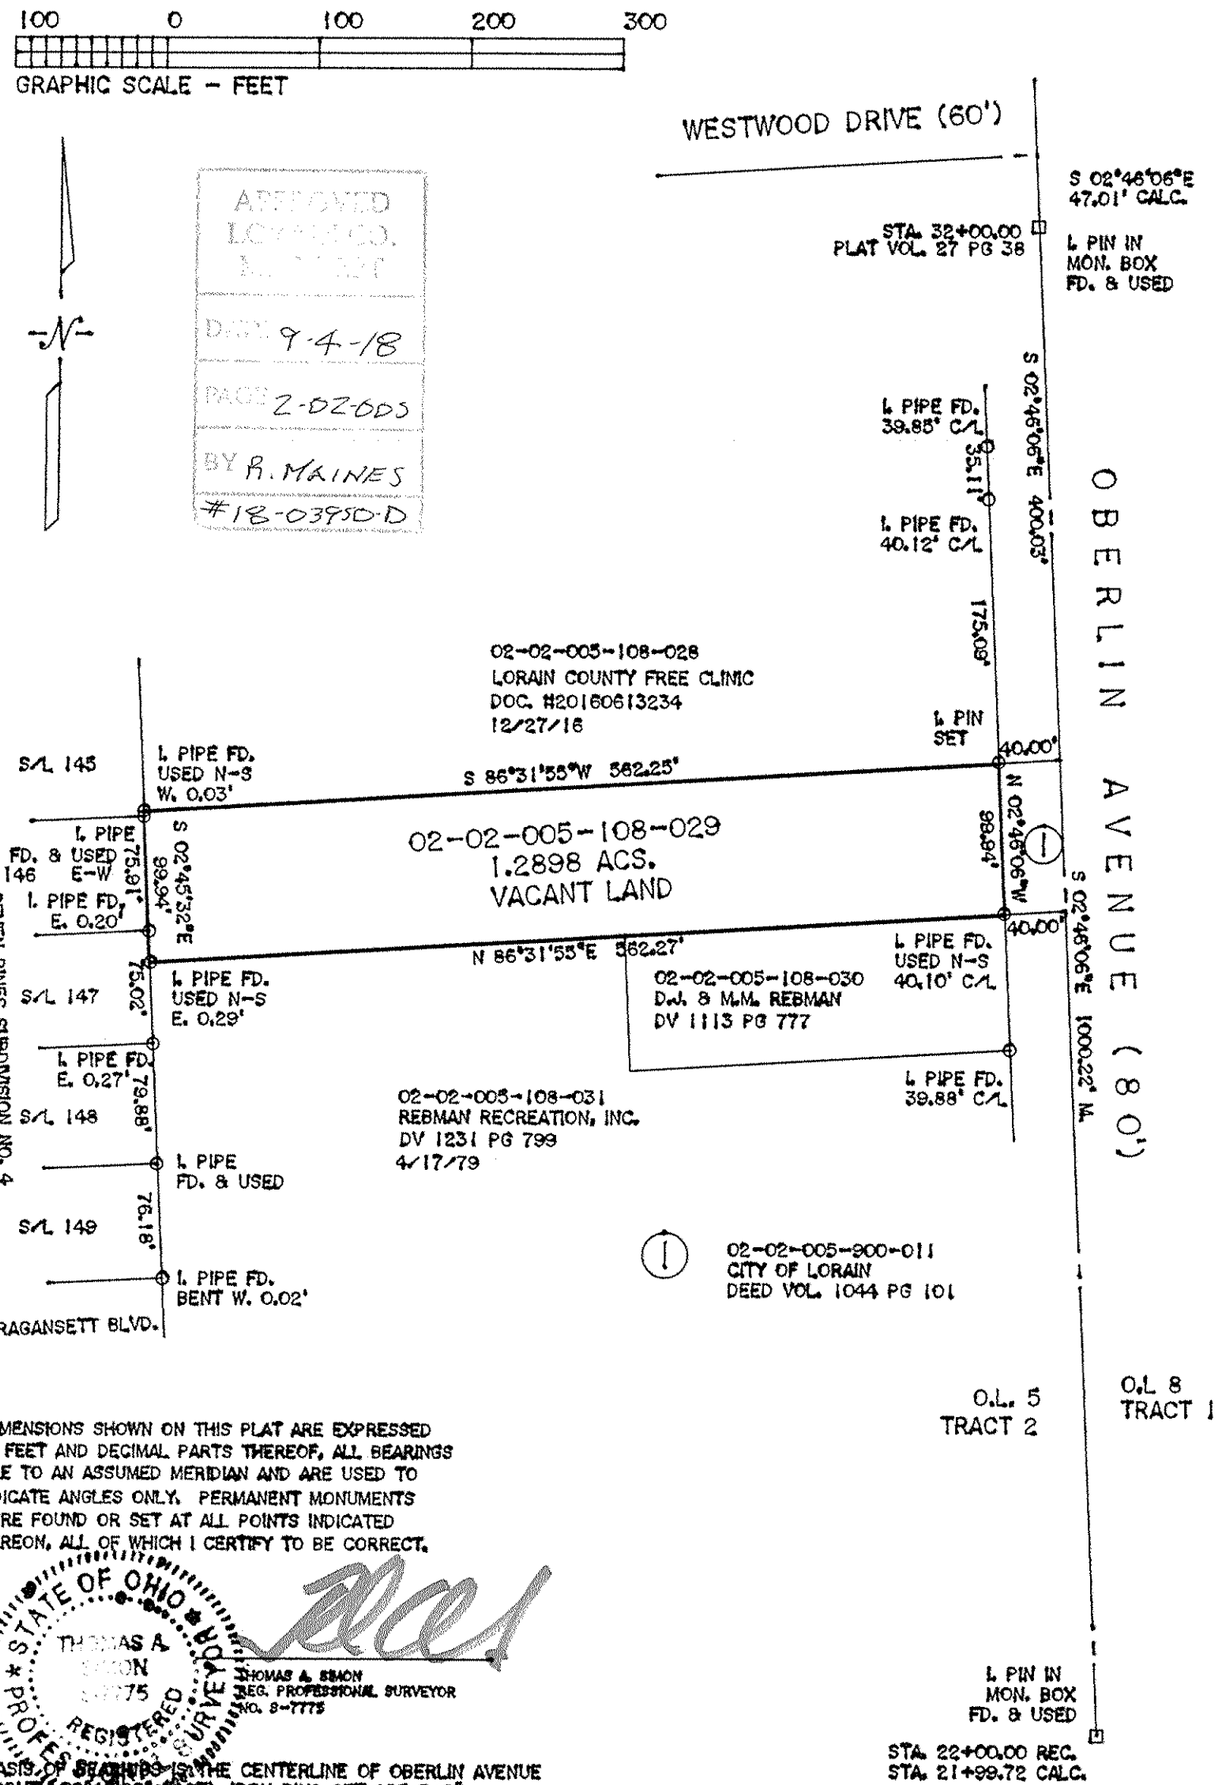

DIMENSIONS SHOWN ON THIS PLAT ARE EXPRESSED IN FEET AND DECIMAL PARTS THEREOF. ALL BEARINGS ARE TO AN ASSUMED MERIDIAN AND ARE USED TO INDICATE ANGLES ONLY. PERMANENT MONUMENTS WERE FOUND OR SET AT ALL POINTS INDICATED HEREON, ALL OF WHICH I CERTIFY TO BE CORRECT.

STATE OF OHIO * THOMAS A SIMON S-7775 REGISTERED PROFESSIONAL SURVEYOR *

THOMAS A. SIMON
REG. PROFESSIONAL SURVEYOR
NO. S-7775

BASIS OF BEARINGS IS THE CENTERLINE OF OBERLIN AVENUE (SOUTH 02°46'06" EAST). IRON PINS SET ARE 5/8" DIAMETER, 30" LONG WITH PLASTIC CAPS "T. SIMON, S-7775".

THOMAS SIMON & ASSOCIATES, INC.
PROFESSIONAL LAND SURVEYORS
150 SOUTH OLIVE STREET
ELYRIA, OHIO 44035
(440) 327-2925
FAX 327-2964

PLAT OF BOUNDARY SURVEY FOR DEBRA BLOCH

BEING KNOWN AS PART OF ORIGINAL BLACK RIVER TOWNSHIP LOT NO. 5, TRACT 2

CITY OF LORAIN COUNTY OF LORAIN STATE OF OHIO

JOB NO. 2018-057

AUGUST, 2018 SCALE: 1" = 100'