SURVEY
OF PART OF
ORIGINAL ELYRIA TWP LOTS 73 AND 74, WEST OF THE BLACK RIVER

PARCEL 06-24-073-000-011
INSTRUMENT NO. 2016-0600929
510 WEST RIVER ROAD LLC
510 WEST RIVER ROAD
WEST RIVER RD ELYRIA, OH 44035
CITY OF ELYRIA COUNTY OF LORAIN
STATE OF OHIO

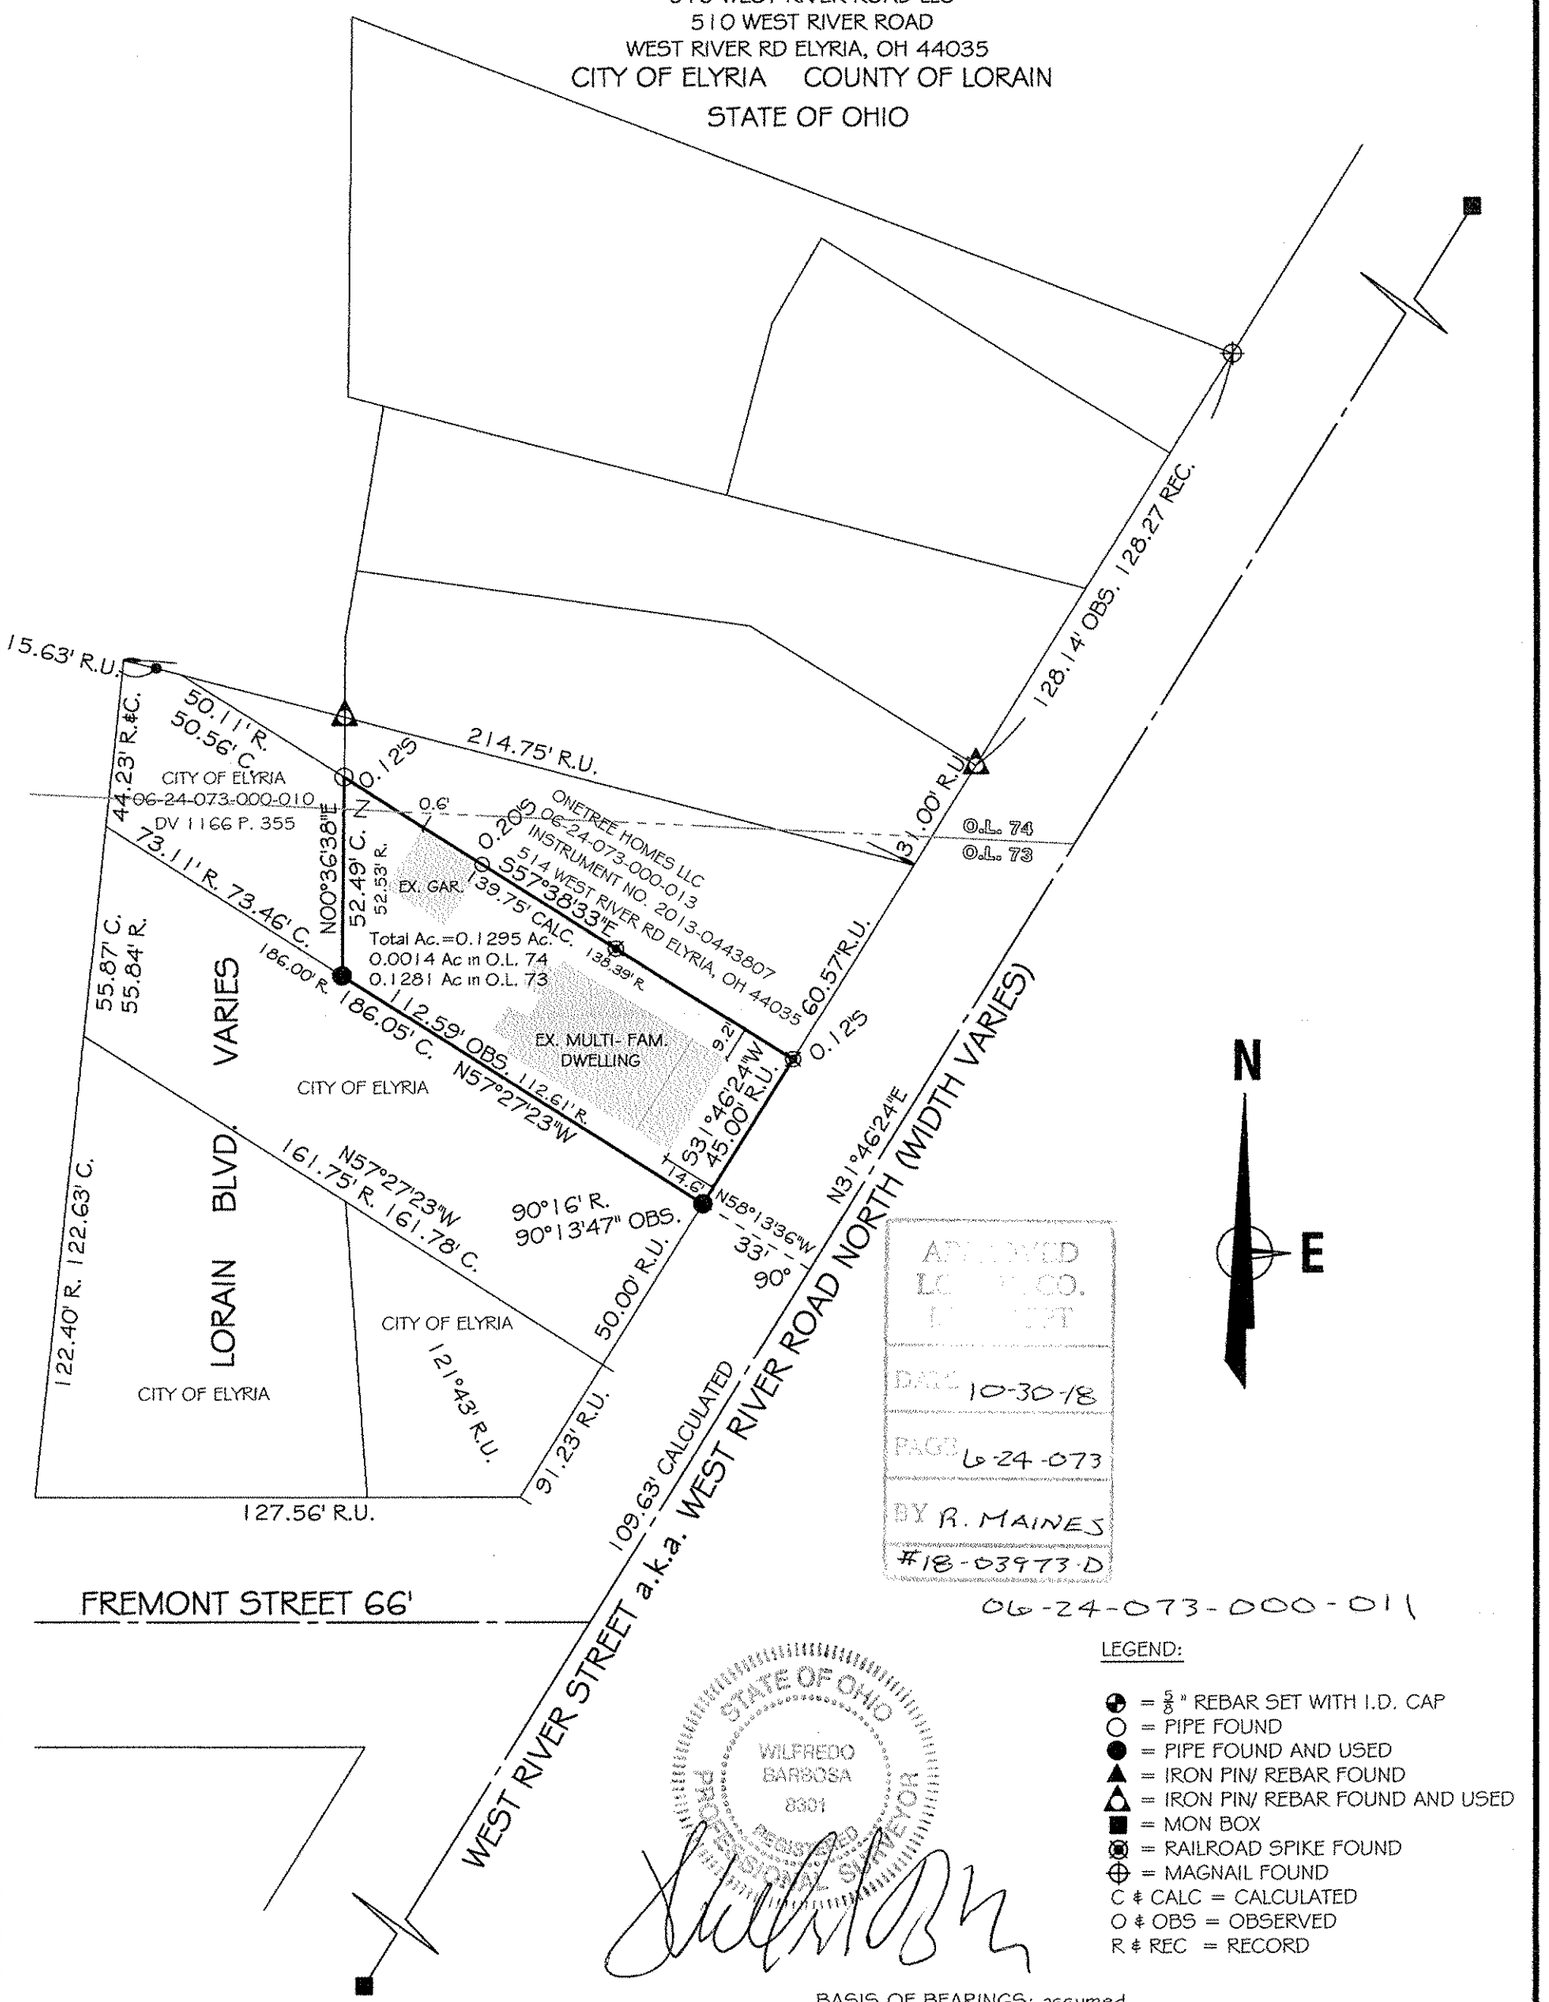

APPROVED
LORAIN CO.
ENGINEER
DATE 10-30-18
PAGE 6-24-073
BY R. MAINES
#18-03973-D

06-24-073-000-011

LEGEND:

- ⊕ = 5/8" REBAR SET WITH I.D. CAP
- ○ = PIPE FOUND
- ● = PIPE FOUND AND USED
- ▲ = IRON PIN/ REBAR FOUND
- △ = IRON PIN/ REBAR FOUND AND USED
- ■ = MON BOX
- ⊗ = RAILROAD SPIKE FOUND
- ⊕ = MAGNAIL FOUND
- C & CALC = CALCULATED
- O & OBS = OBSERVED
- R & REC = RECORD

STATE OF OHIO
WILFREDO BARBOSA
8301
REGISTERED PROFESSIONAL SURVEYOR

BASIS OF BEARINGS: assumed

PROPERTY ADDRESS: 510 West River Road North Elyria, OH 44035	**BARBOSA AND ASSOCIATES LLC** 5604 CASE ROAD NORTH RIDGEVILLE, OH 44039 440 327-4776	GRAPHIC SCALE 0 40 20 (IN FEET) 80
PREPARED AT THE REQUEST OF: Ann Cabbil & John Porter	DRAWN BY: WB 10/23/2018 / CHECKED BY:WB JOB No: 2018-10-3 / SHEET 1 of 1	SCALE: 1" = 50'