



Situated in the City of North Ridgeville, County of Lorain and State of Ohio and known as being a part of Original Ridgeville Township Lot No. 14


This is to certify that, at the request of the owner, I have surveyed and platted the parcel of land shown hereon in accordance with the provisions of Chapter 4733-37 of the Ohio Administrative Code. Monuments were found or set as indicated hereon. Dimensions are expressed in US Survey Feet and decimal parts thereof. All of which I certify to be correct to the best of my knowledge and belief.

RECEIVED
NOV 28 2018

Terence R. Allison 2/27/18
Terence R. Allison, P.S. Date
Registered Surveyor No. S-7176
State of Ohio

ALLOTTED
LORAIN CO.
PLAT
DATE 12-19-18
PAGE 7-00-014
BY R. MAINES
#18-03918

07-00-014-103-330
-331

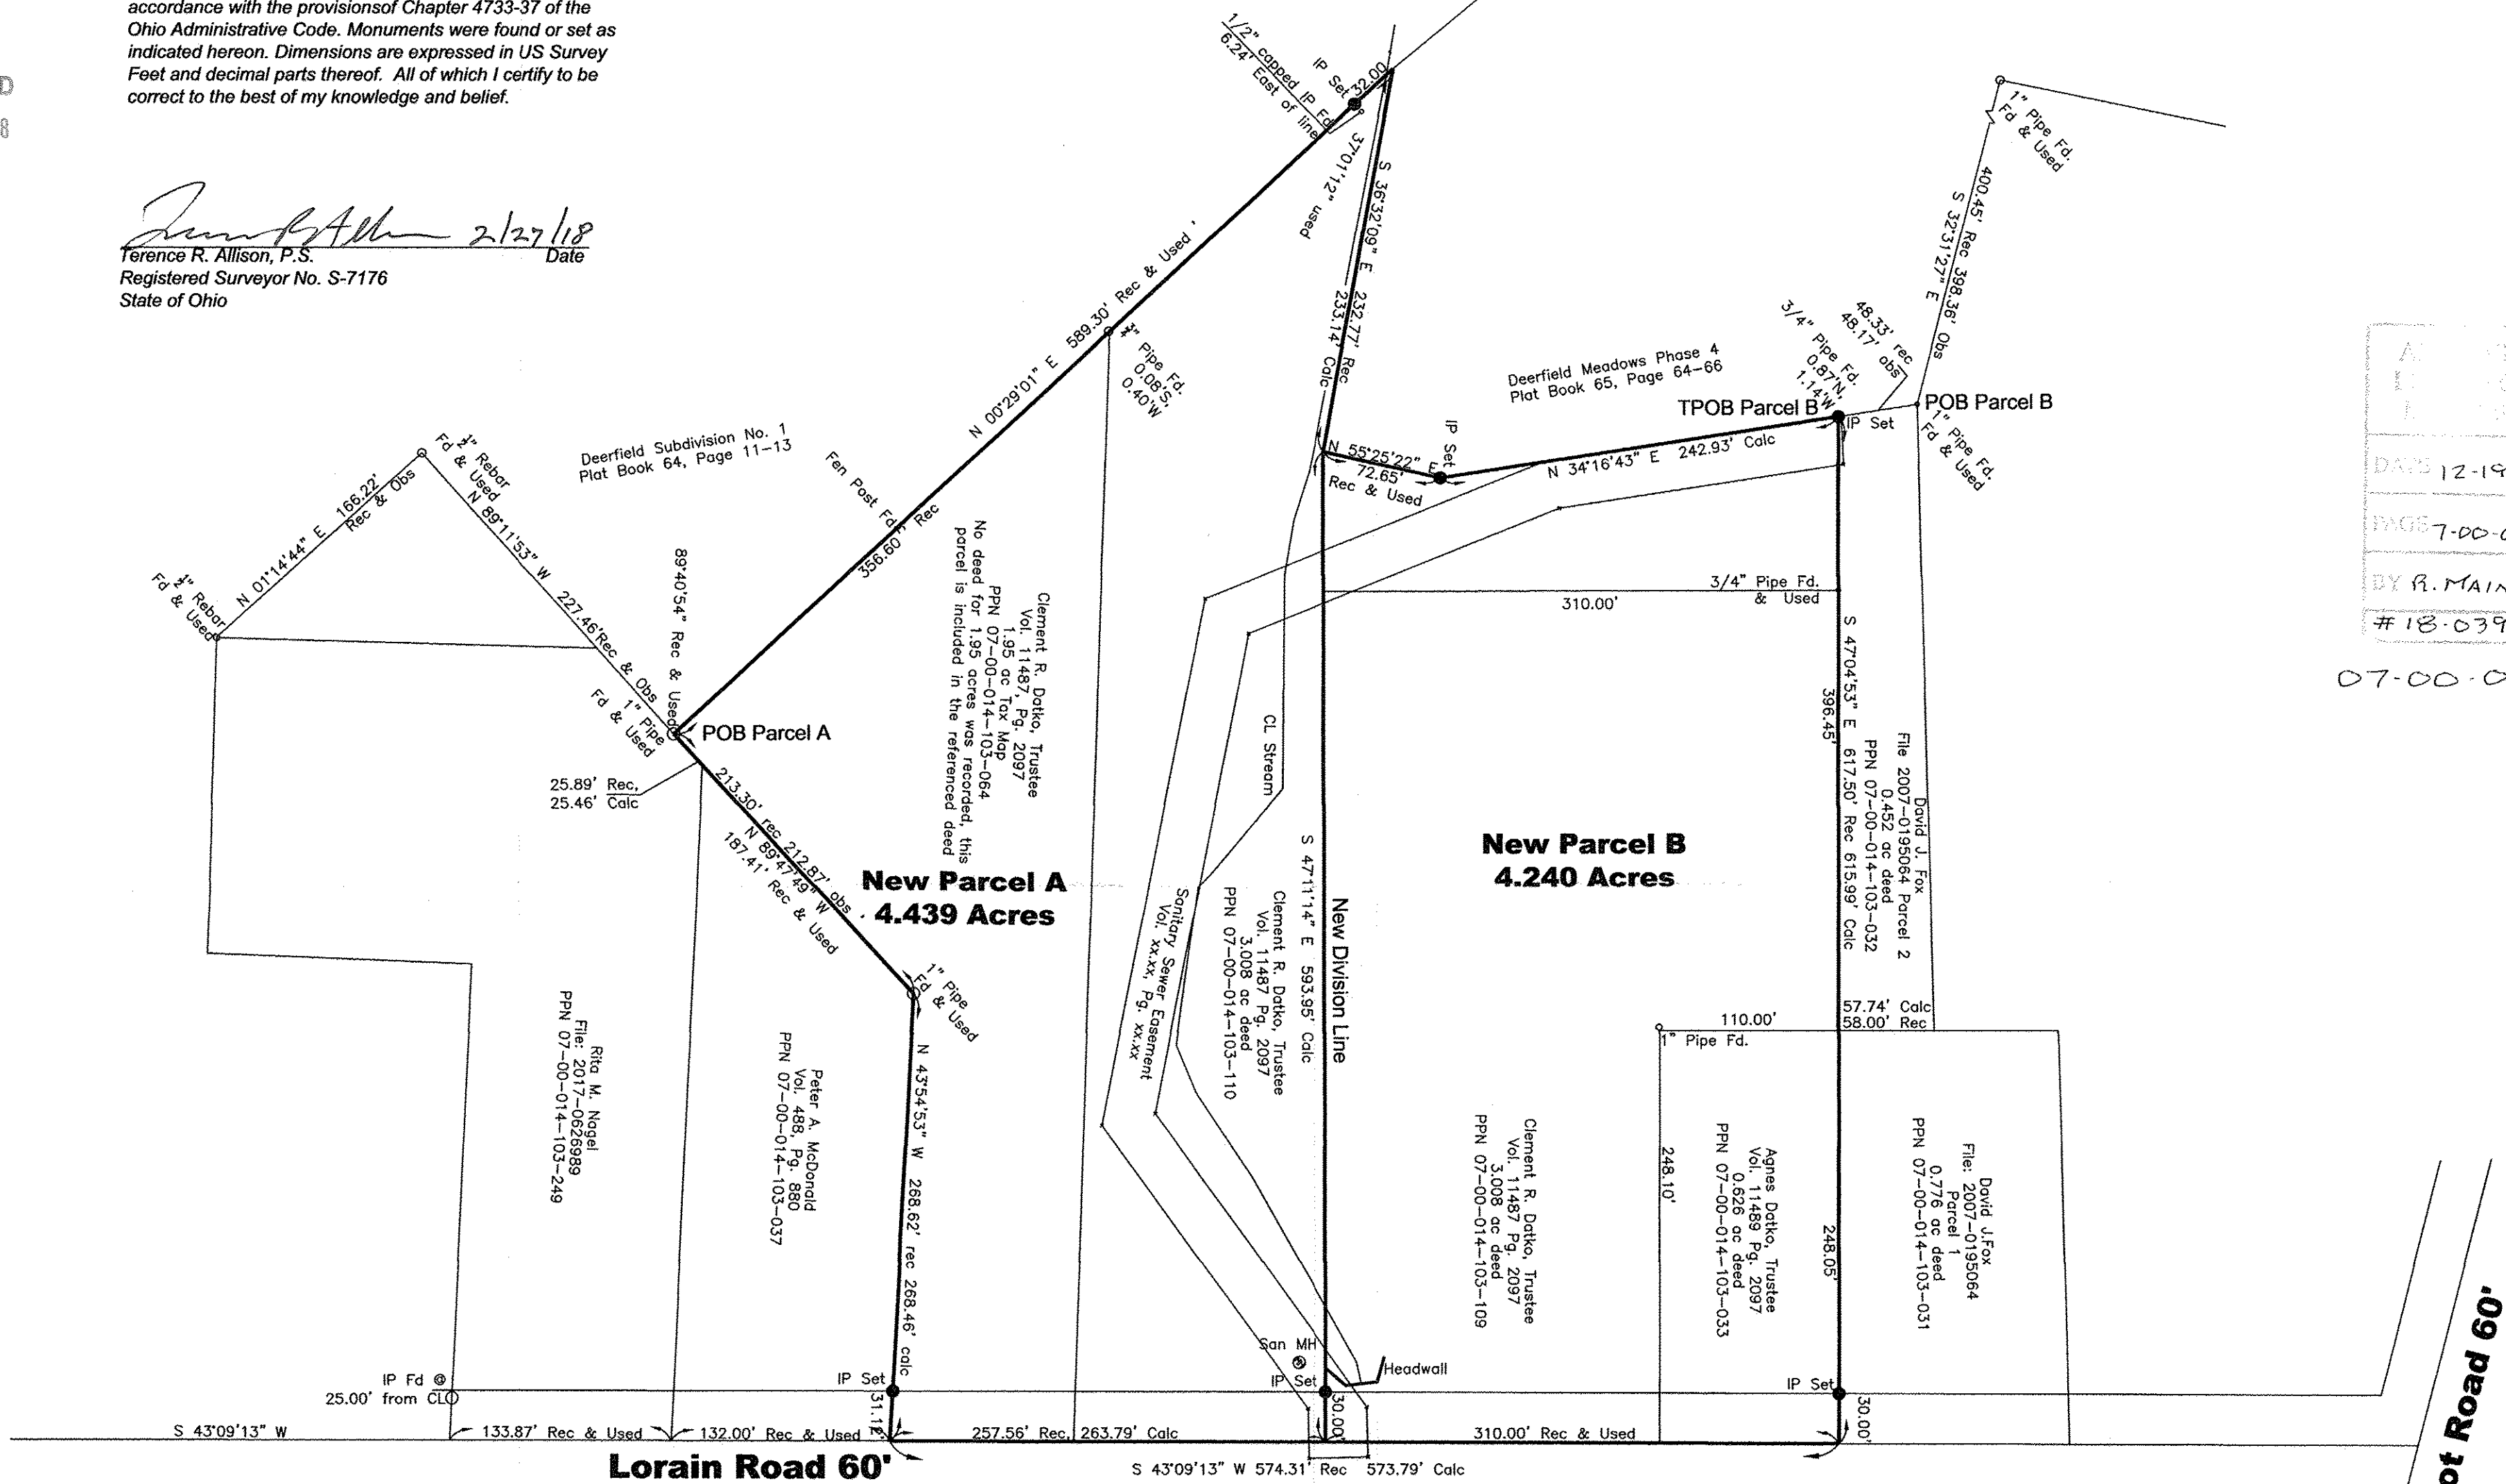


The Basis of Bearing is Ohio State Plane Coordinates, North Zone, NAD 1983.

Iron pins set are 36" 5/8" rebar with plastic cap stamped "T. Allison 7176"

- - Iron Pin Set
- ▲ - Drill Hole or Railroad Spike Set
- - Iron Pin Found
- ⊙ - Iron Pipe Found
- △ - Monument Found as Noted
- - Stone Monument Found

Reference used:
County Auditor's Tax Maps
Deeds as noted hereon
Surveys on File at the County Map Office

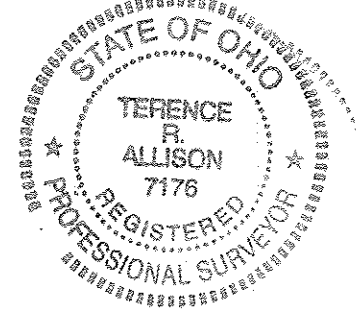

ISSUE DATE 02/26/18
SURVEYED BY TRA
DRAWN BY TRA
FILE ID: 17009

SCALE 1" = 80'
DATE 01/12/18
DATE 02/20/18

Terence R. Allison P.S.
1573 Kings Arm Circle NW
Uniontown, Ohio 44685
330-699-0428
tallison@neo.rr.com

PLAT OF SURVEY
Datko Parcel Split Plat
Lorain Road
North Ridgeville, Ohio 44309

SHEET NO:

1 / 1