
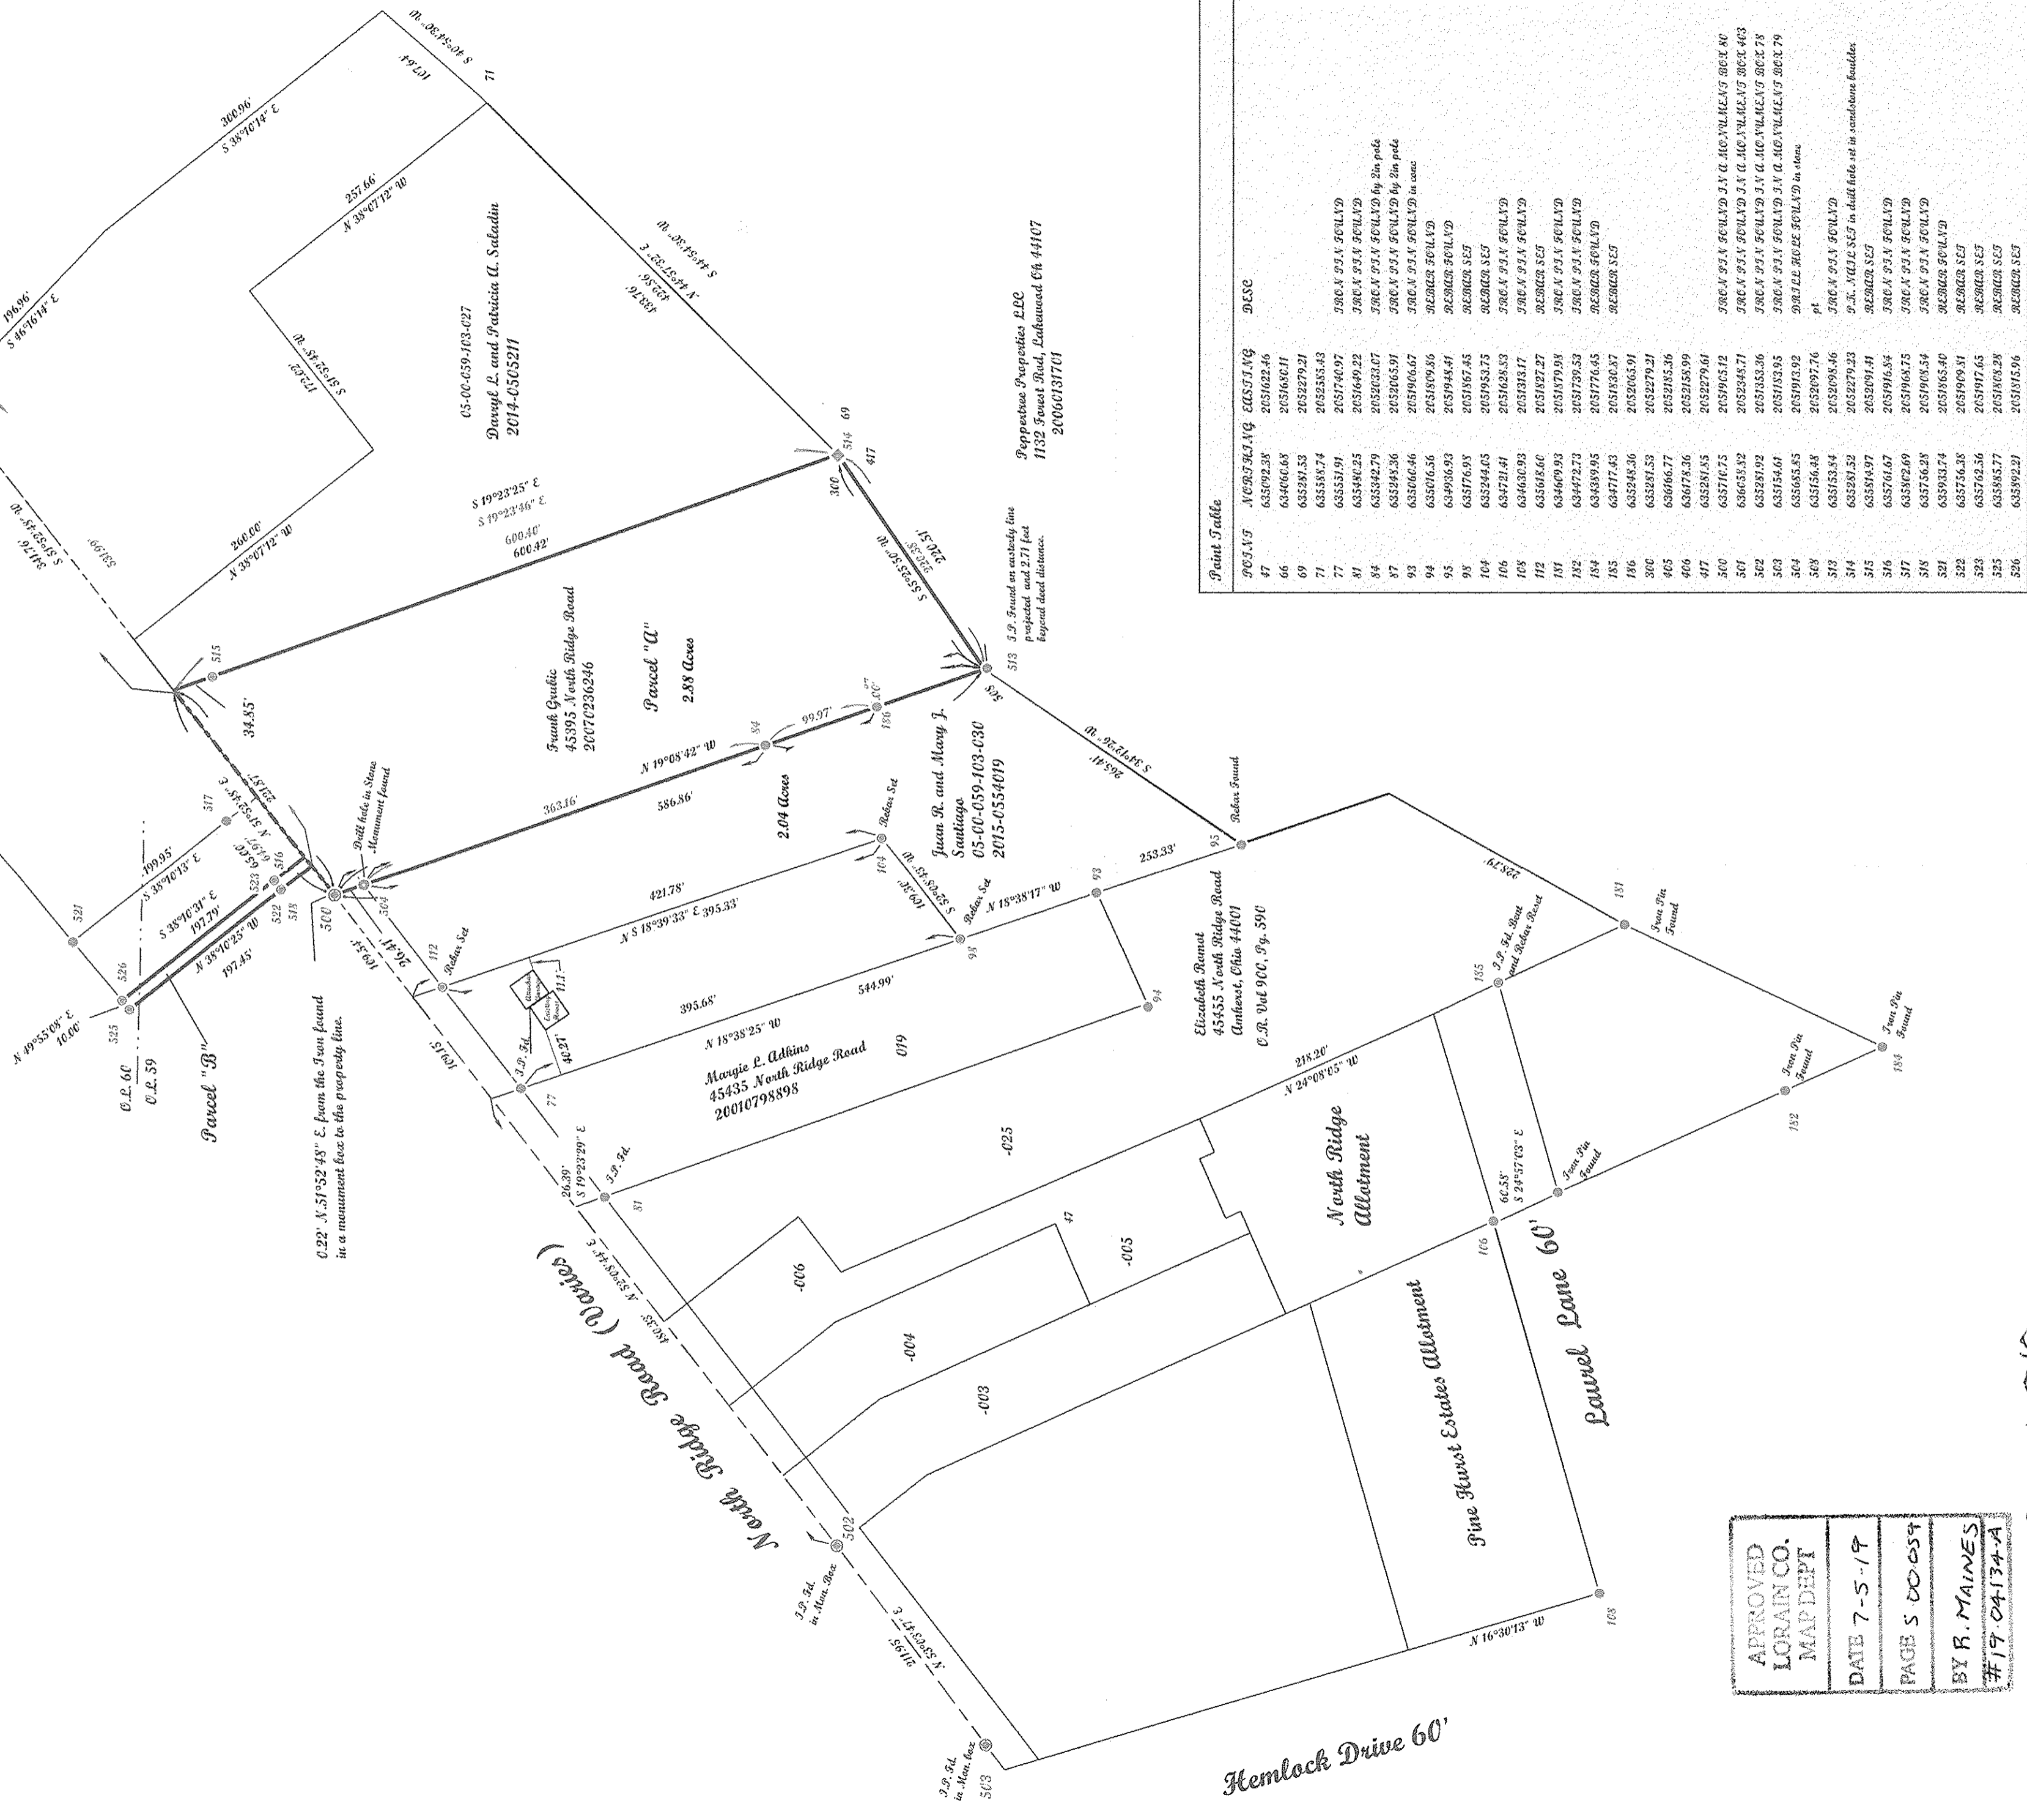


Note: Bearings and coordinates shown are based on the Ohio State Plane but are used to describe angles only.


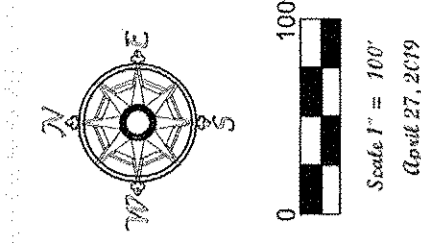

0.22' N 51°52'45" E from the Iron found in a monument box to the property line.



POINT NO.	NORTHING	EASTING	DESC.


APPROVED  
LORAIN CO.  
MAP DEPT  
DATE 7-5-19  
PAGE 5 00054  
BY R. MAINES  
#19 04134-A

05-00-059-101-010  
05-00-059-103-009



Note: Only copies signed with Red ink shall be considered valid.

Patrick A. McGannon  
Patrick A. McGannon P.S. 7754

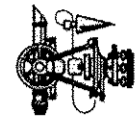

Note: Dimensions shown in Blue are record values and those shown in red are field observed values.

McGannon Surveying, LLC  
Boundary Survey  
Patrick A. McGannon  
Registered Professional Surveyor  
1731 Gettysburg Drive, Leveson, Ohio 44653 (440) 282-2712  
www.mcgannonsurveying.com

Prepared exclusively for Frank J. Grudis of 45395 North Ridge Road, Amherst Township, 44001.