


APPROVED
LORAIN CO.
MAPSHEET

DATE 8-19-19

DATE 1-00-061

BY R. MAINES

19-0400T

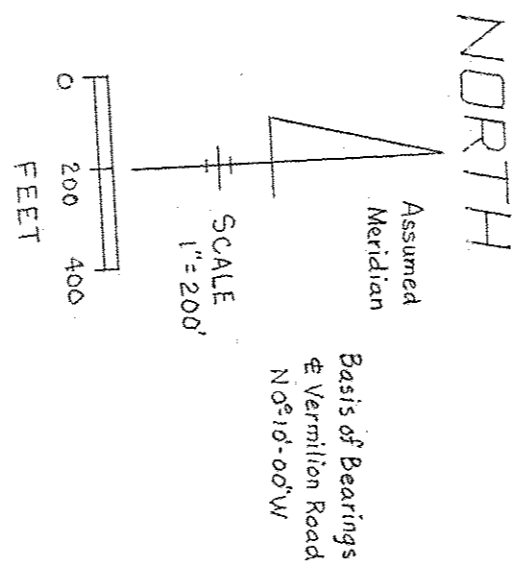

LEGEND: ○ Denotes 1" Iron Pipes Found
○ Denotes 1/2" Iron Rods Set

SPLIT:

PARCEL "A" = 1.8787 Acres

PARCEL "B" = 35.6864 Acres of which

23.1787 Ac. O.L. 60

12.5077 Ac. O.L. 61

Perm. Par. No. 08-00-061-000-010

01-00-061-000-019
-020

046
01-00-060-000-000

Charles P. Waryu
CHARLES P. WARYU Registered Surveyor
No. 5029 August 27, 2009

MAP OF SURVEY
MADE OF LANDS, SPLIT,
Part of Orig. Brownhelm Twp Lots
No. 60, 61, Lorain County, Ohio.
For Raymond A. Bechtel Aug. 2009