60 0 60 120 180
GRAPHIC SCALE – FEET

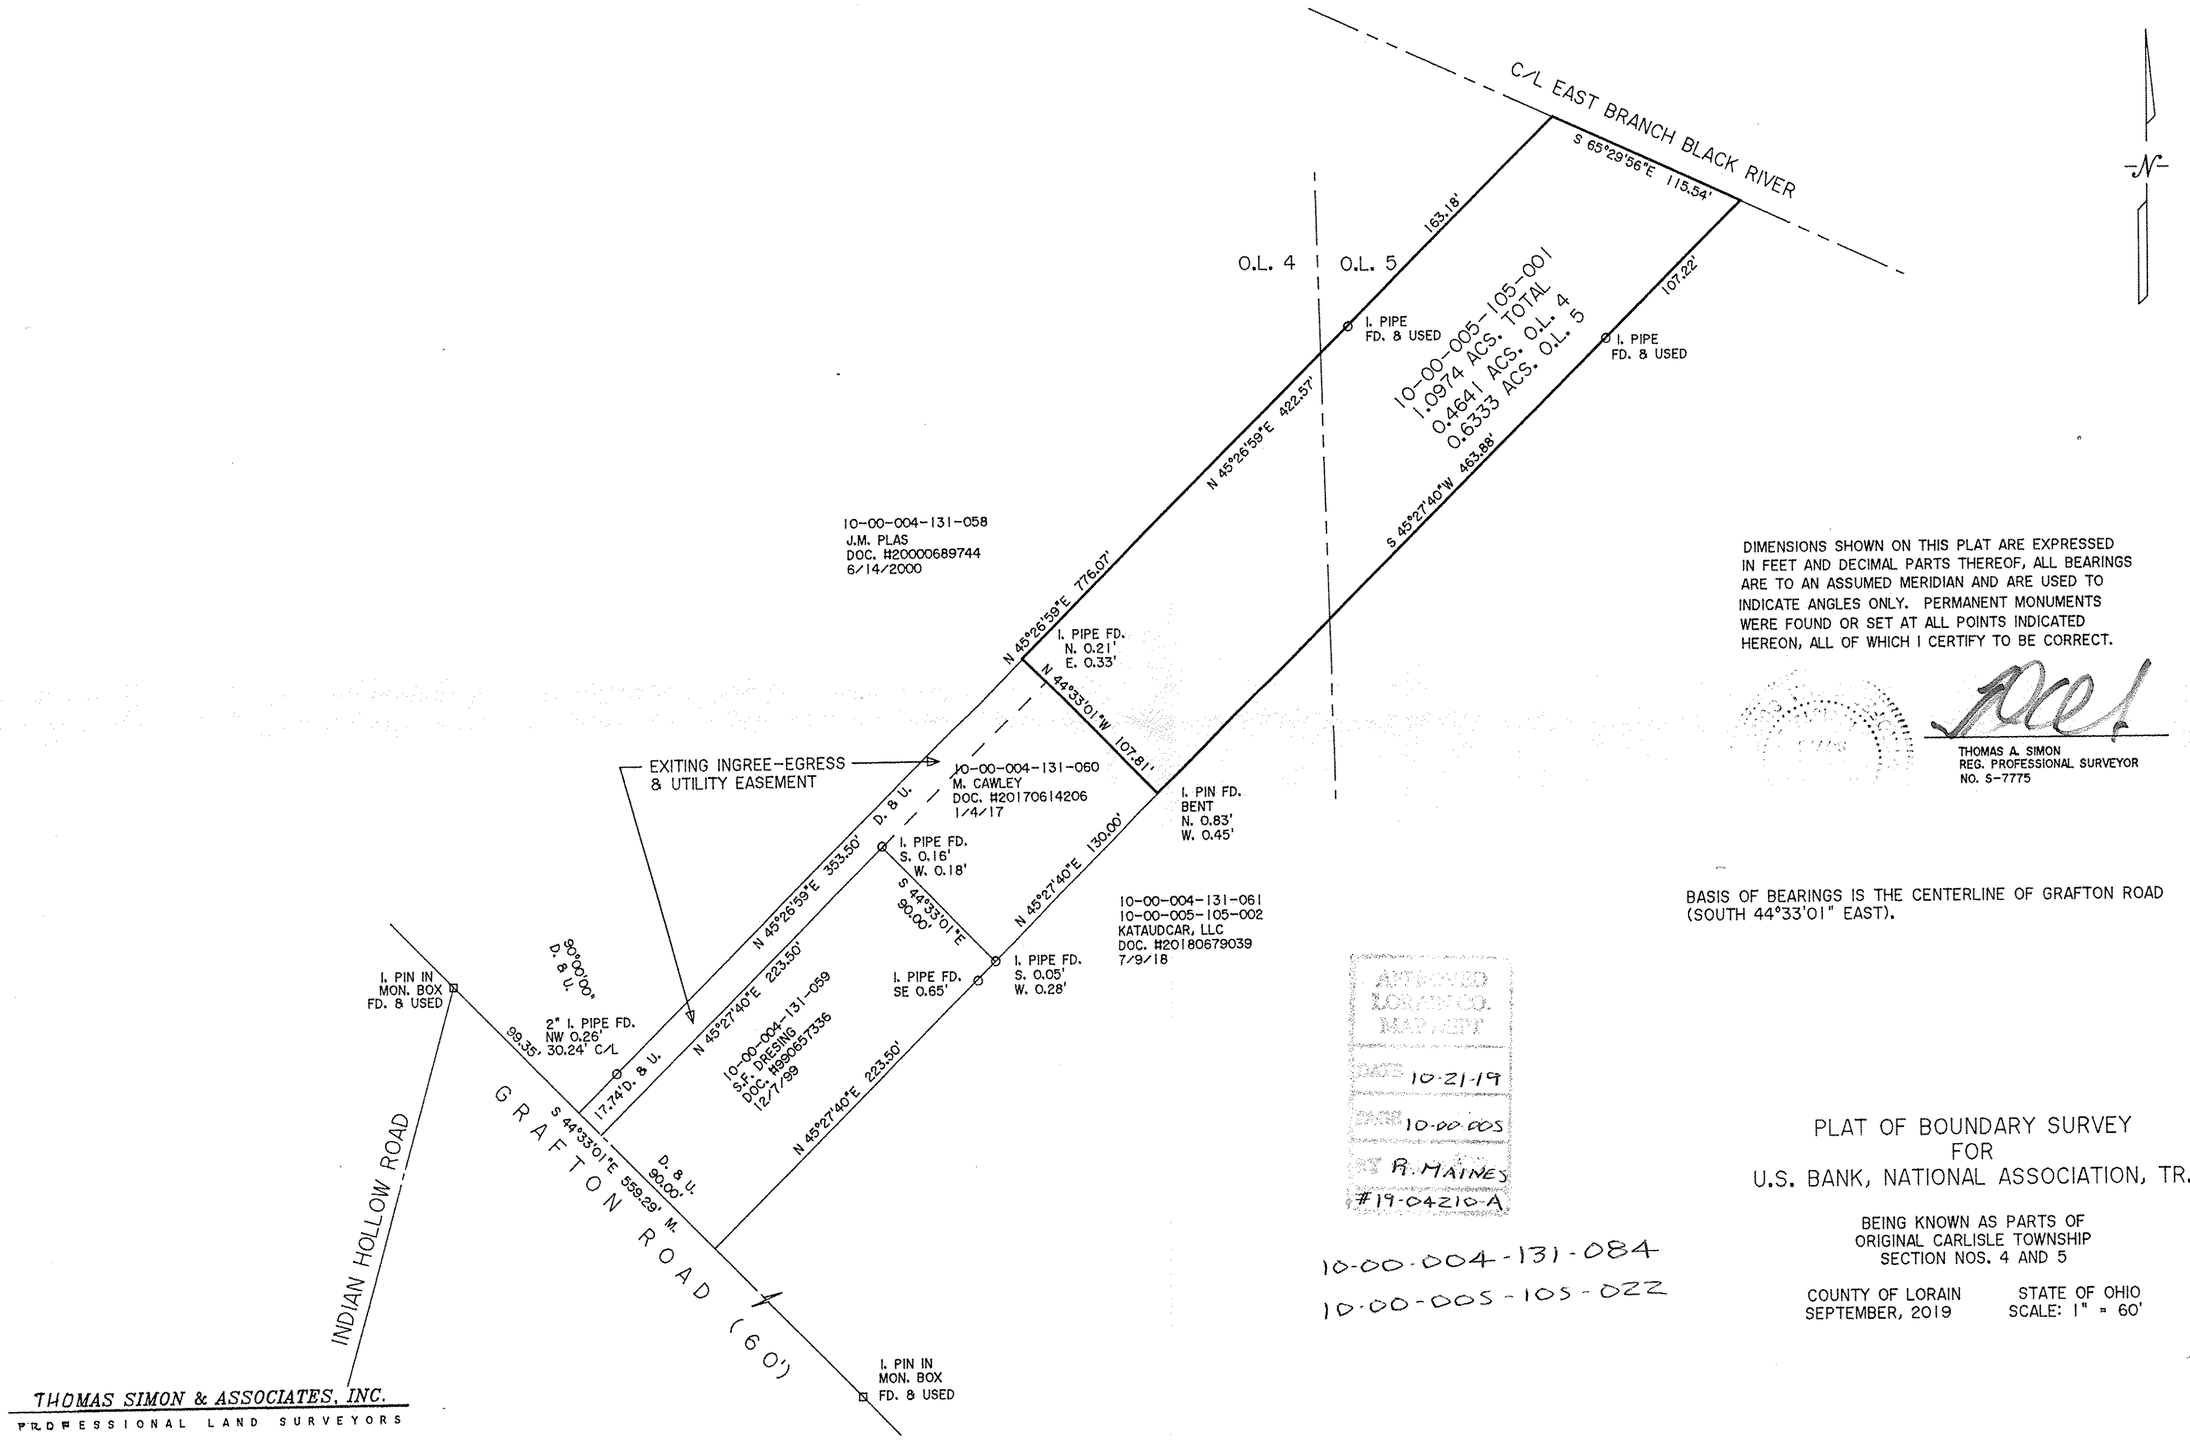


DIMENSIONS SHOWN ON THIS PLAT ARE EXPRESSED IN FEET AND DECIMAL PARTS THEREOF, ALL BEARINGS ARE TO AN ASSUMED MERIDIAN AND ARE USED TO INDICATE ANGLES ONLY. PERMANENT MONUMENTS WERE FOUND OR SET AT ALL POINTS INDICATED HEREON, ALL OF WHICH I CERTIFY TO BE CORRECT.

THOMAS A. SIMON
REG. PROFESSIONAL SURVEYOR
NO. S-7775

BASIS OF BEARINGS IS THE CENTERLINE OF GRAFTON ROAD (SOUTH 44°33'01" EAST).

APPROVED
LORAIN CO.
MAP DEPT
DATE 10-21-19
BY 10-00-005
BY R. MAINES
#19-04210-A

10-00-004-131-084
10-00-005-105-022

# PLAT OF BOUNDARY SURVEY
# FOR
# U.S. BANK, NATIONAL ASSOCIATION, TR.

BEING KNOWN AS PARTS OF
ORIGINAL CARLISLE TOWNSHIP
SECTION NOS. 4 AND 5

COUNTY OF LORAIN
SEPTEMBER, 2019

STATE OF OHIO
SCALE: 1" = 60'


THOMAS SIMON & ASSOCIATES, INC.
PROFESSIONAL LAND SURVEYORS
150 SOUTH OLIVE STREET
ELYRIA, OHIO 44035
(440) 327-2925
FAX 327-2964


JOB NO 2019-067