
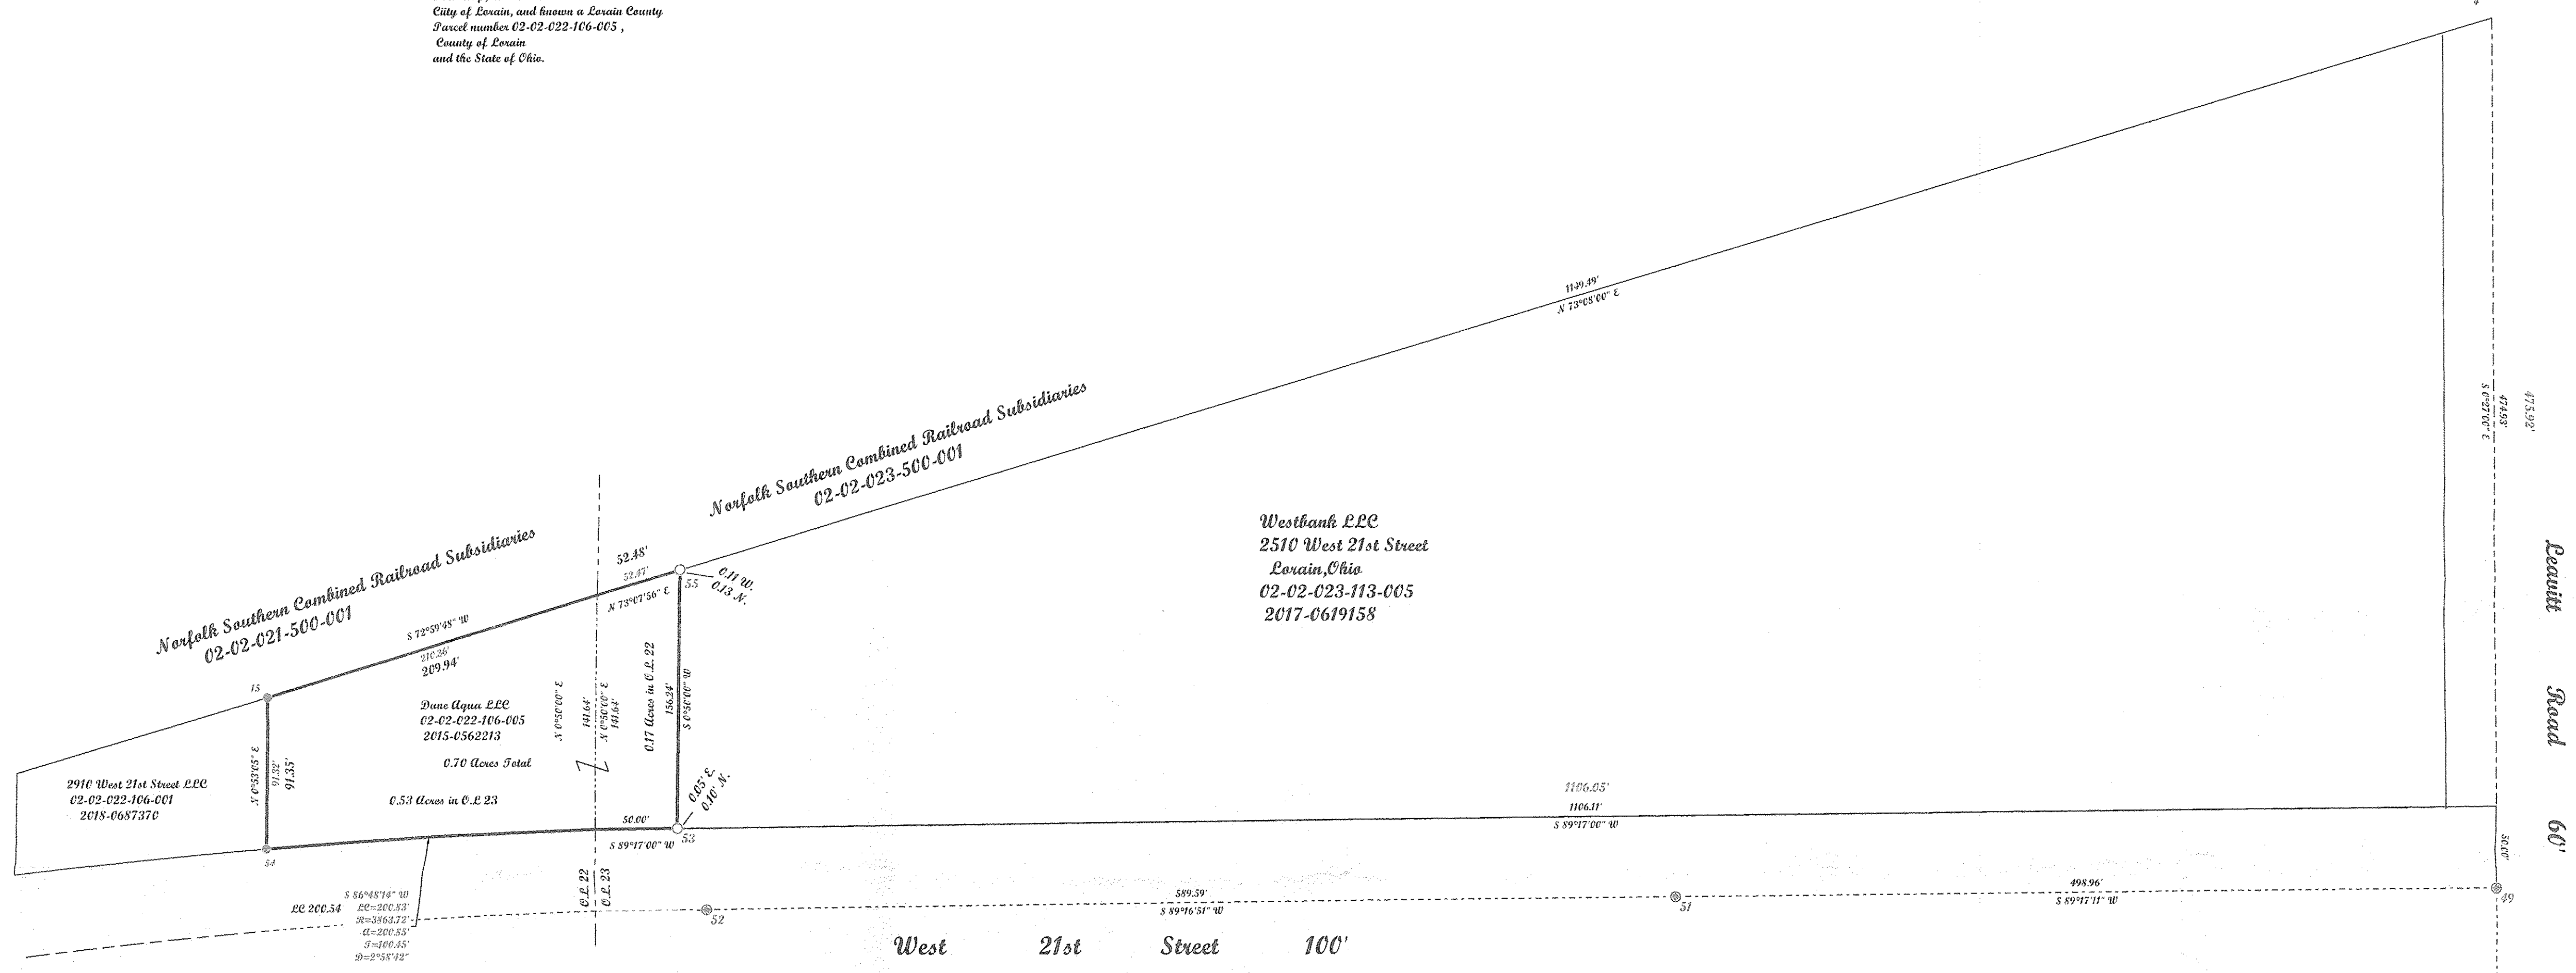


Note: Bearings and Coordinates shown are based on the Ohio State Plane (Grid North) but are used to describe angles only.

Being known as sublot Part of Original Lots 22 and 23 of Black River Township, now in the City of Lorain, and known as Lorain County Parcel number 02-02-022-106-005, County of Lorain and the State of Ohio.

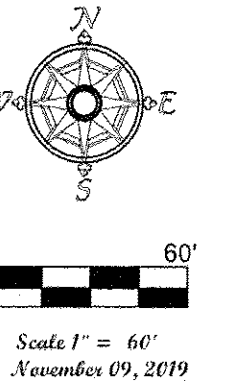

11-19-19  
2-02-022  
P. MAINES  
#19-04225-C  
02-02-022-106-006  
02-02-023-113-006

POINT	NORTHING	EASTING	DESC
1	630208.76	2650103.35	
4	630654.66	2650099.64	
15	630274.41	2648748.22	TRC.A. P.P.N. SOLV'D
49	630158.76	2650103.74	TRC.A. P.P.N. SOLV'D J.N. O. MC.VULMEY'S REC.
50	649647.18	2650107.55	TRC.A. P.P.N. SOLV'D J.N. O. MC.VULMEY'S REC.
51	630152.54	2649664.82	TRC.A. P.P.N. SOLV'D J.N. O. MC.VULMEY'S REC.
52	630145.15	2649015.28	TRC.A. P.P.N. SOLV'D J.N. O. MC.VULMEY'S REC.
53	630195.03	2648997.38	RESIDAR SOLV'D D.N. 7315 6914
54	630183.10	2648746.81	TRC.A. P.P.N. SOLV'D
55	630351.26	2648999.49	RESIDAR SOLV'D

Note: Only copies signed with Red ink shall be considered Valid.  
*Patrick A. McGannon*  
Patrick A. McGannon P.S. 7154

**McGannon Surveying, LLC**  
Boundary Survey  
Patrick A. McGannon  
Registered Professional Surveyor  
1731 Gattysburg Drive, Lorain, Ohio 44653 (440) 282-2712  
www.mcgannonsurveying.com

Prepared exclusively for Dana Agua LLC of 2808 West 21st Street Lorain, Ohio 44053 under the terms of the work order as if incorporated herewith.

P.L.S.C.  
Member Number 2433



Note: Dimensions shown in Blue are record values and those shown in Red are field observed values.  
7/11/2019