Registered Number 2063 *Registrant*

Subsequent Owners

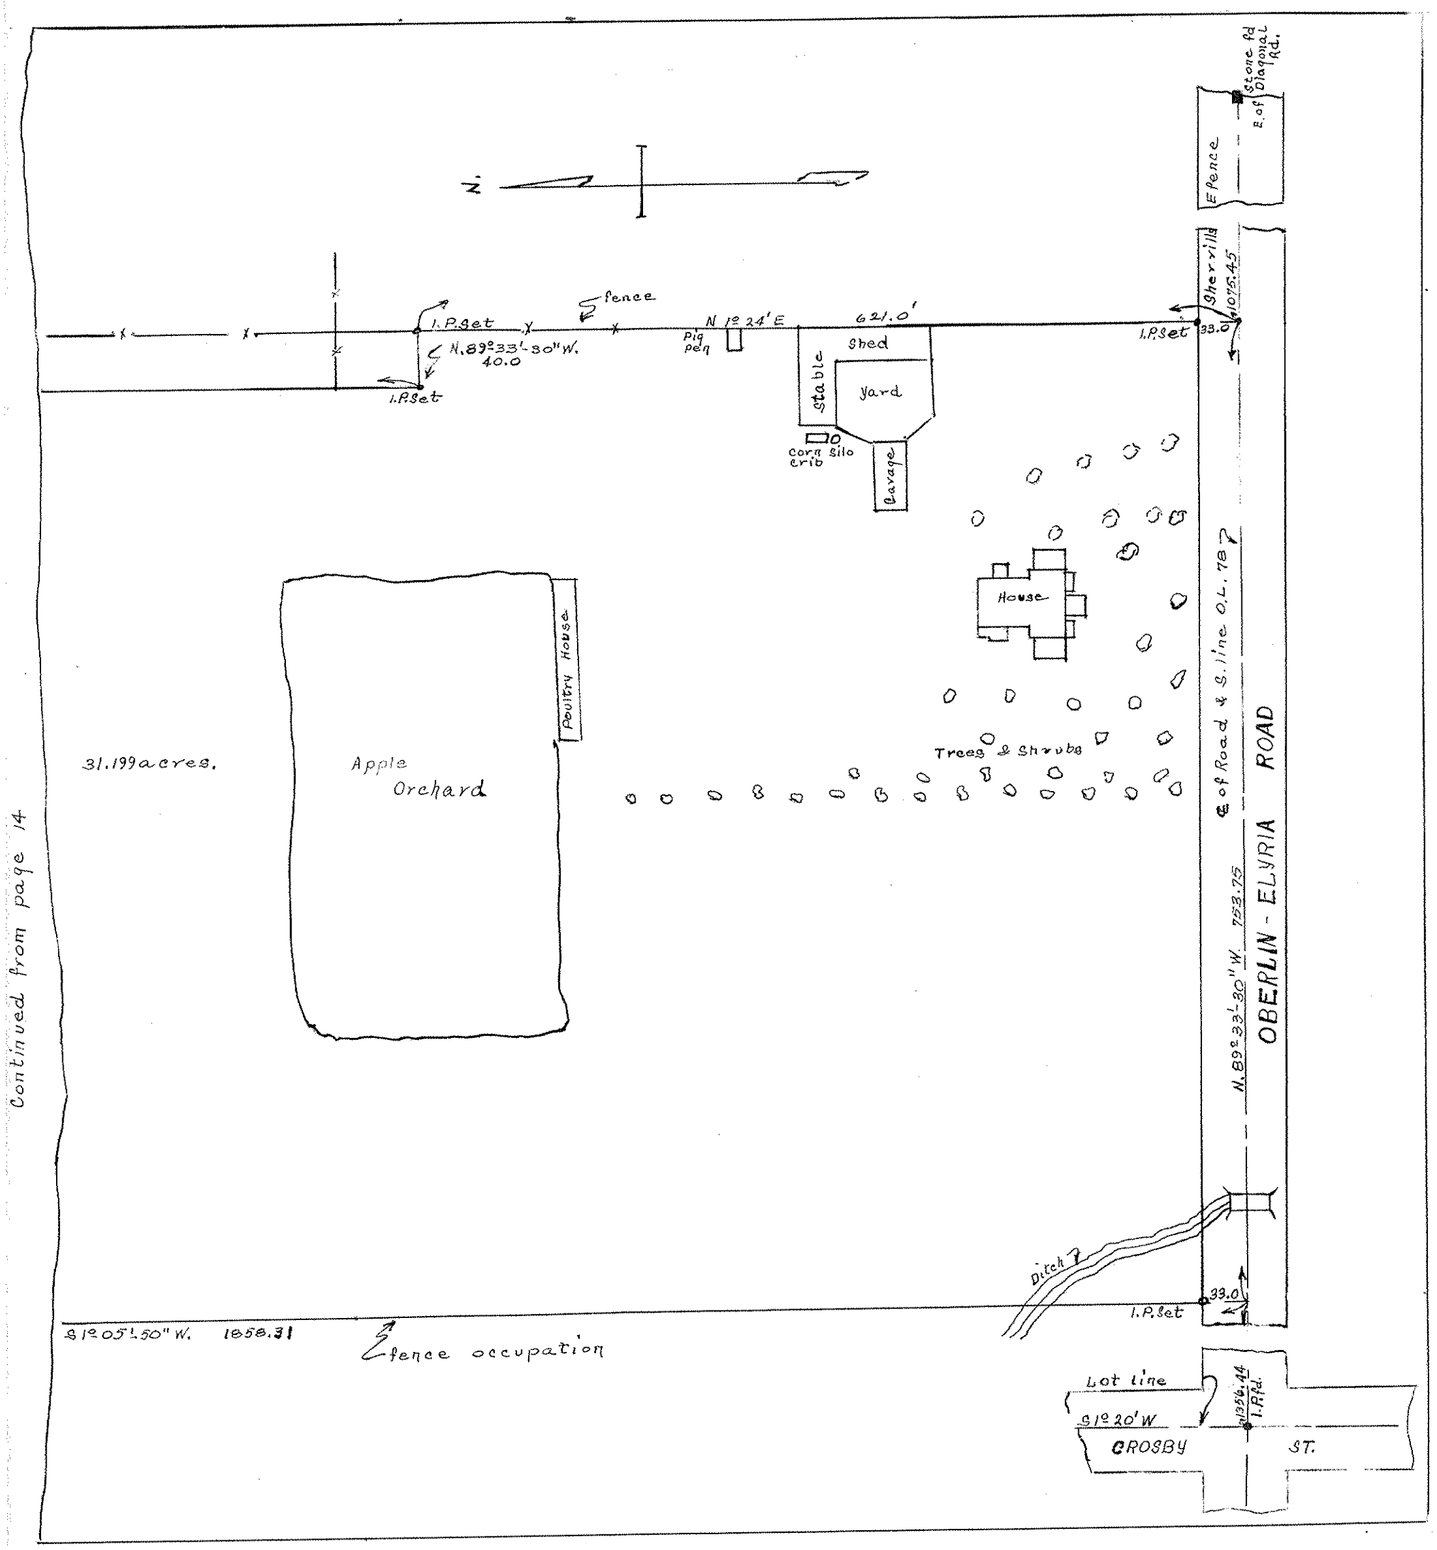

Continued from page 14