Registered Number *Registrant*

Subsequent Owners

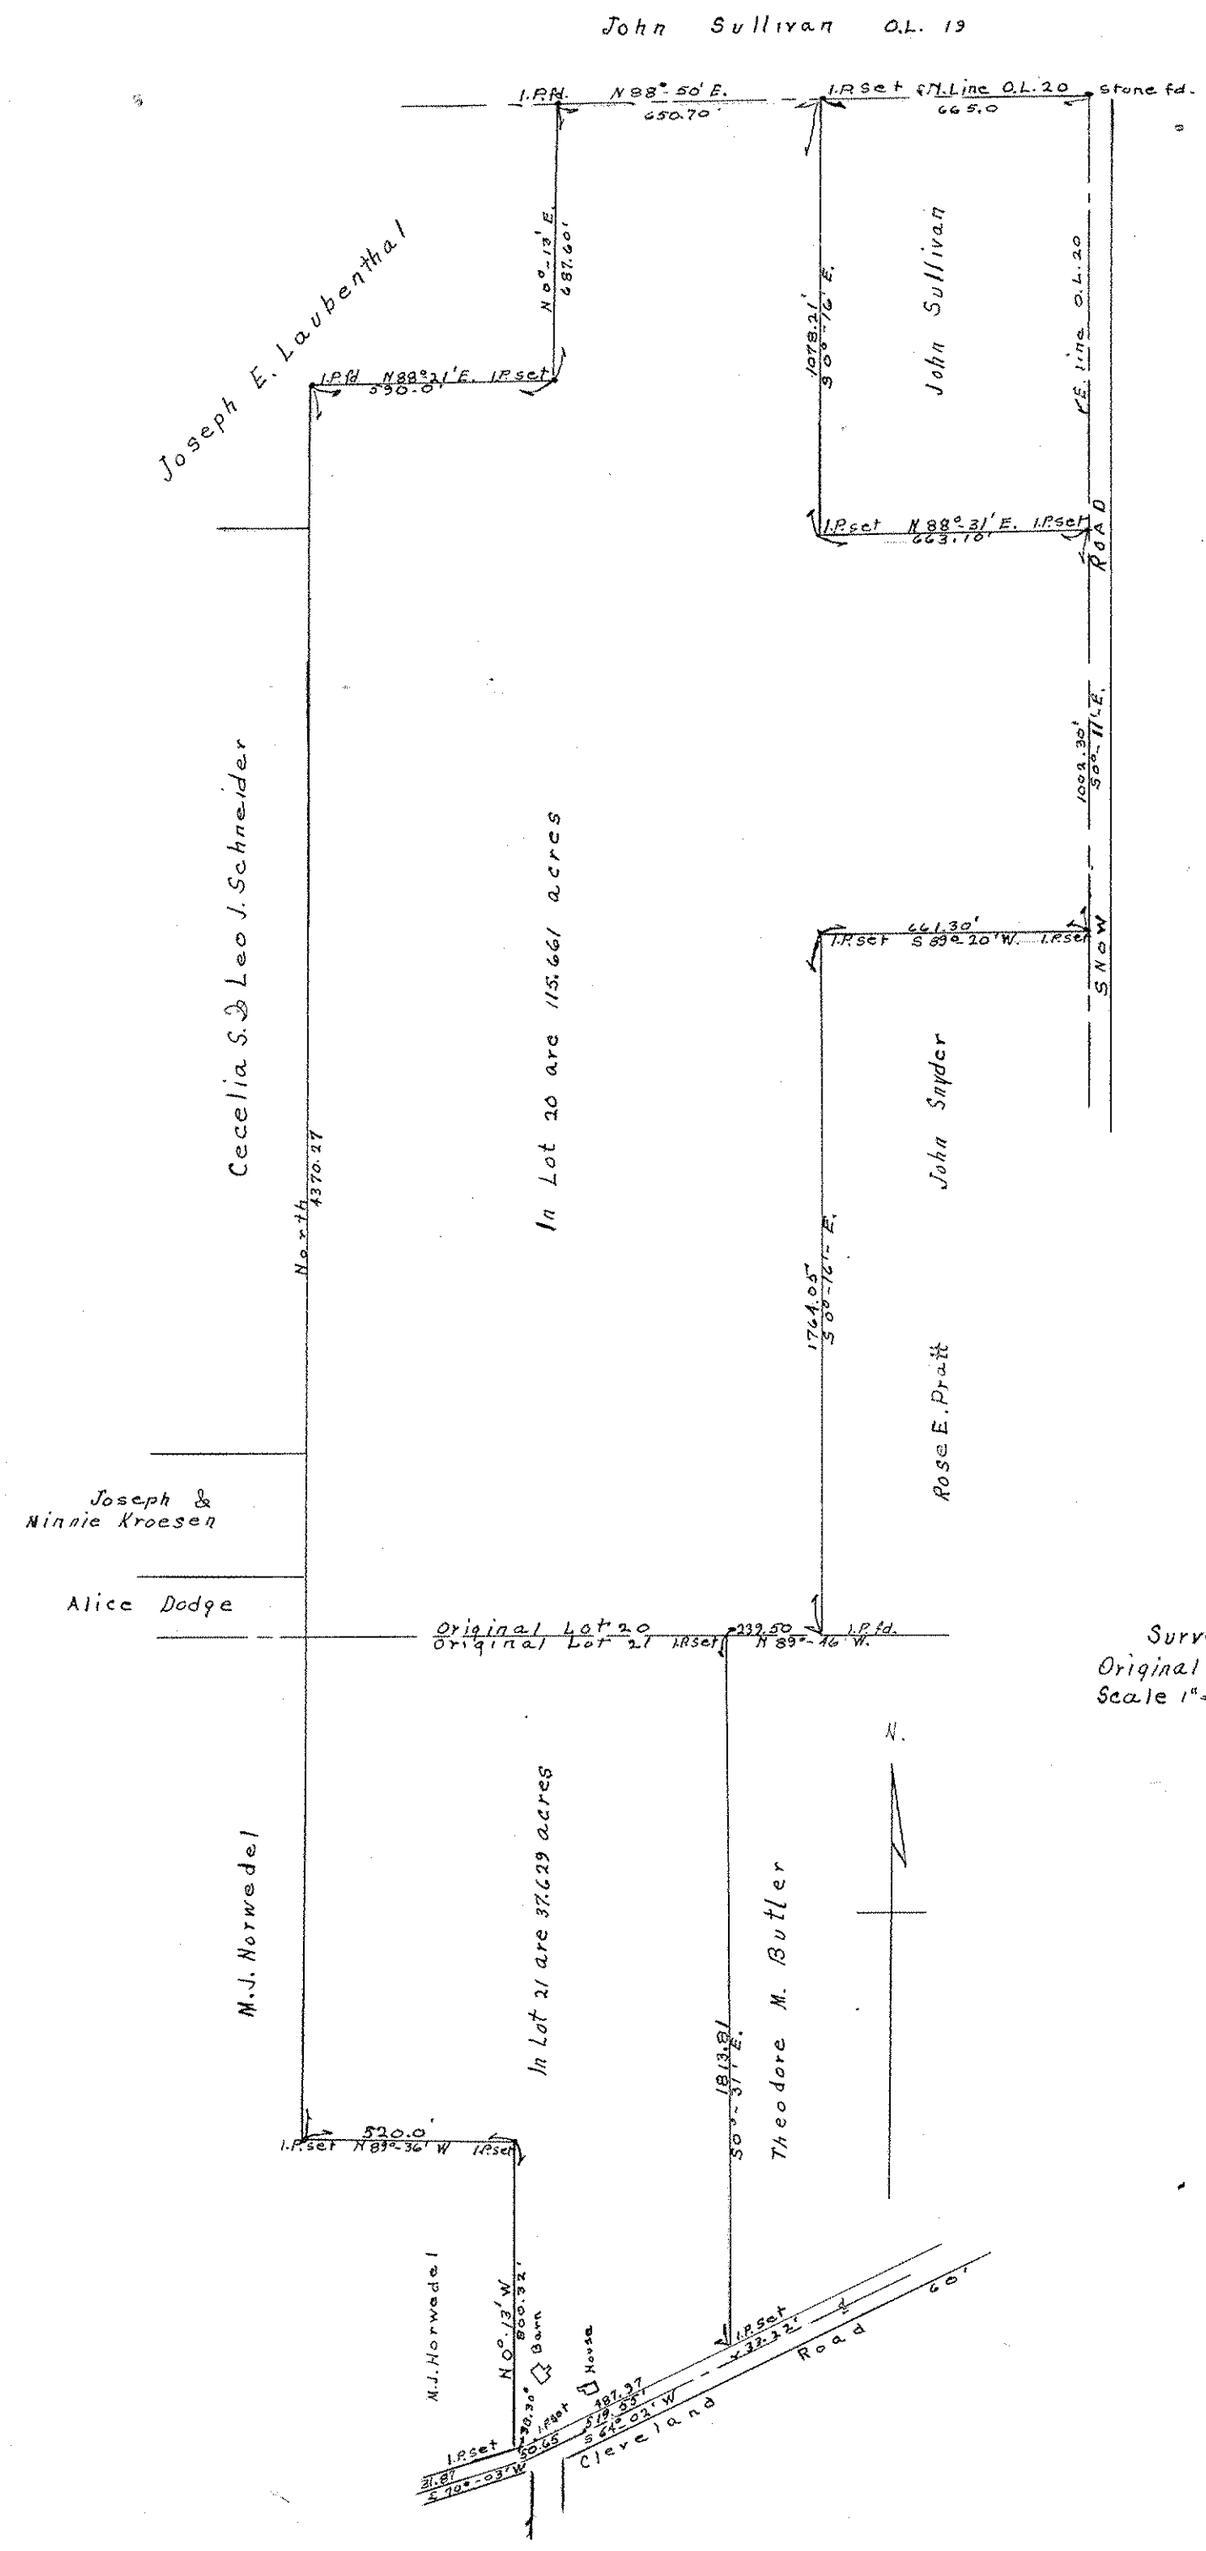

Survey for The Universal Realty Co.
Original Lots #20 & 21, Ridgeville Twp. Lorain Co. Ohio.
Scale 1" = 400' November, 1, 1920.
Warden & Laundon, Civil Engineers.
by J. W. Warden.