Registered Number

Subsequent Owners

Registrant

Survey of Land owned by Charles Lanaghan Estate Out Lot #3 Between the branches of Black River , City of Elyria, Lorain Co. Ohio. October 30, 1914.

Henry Cole, Helper.

J.W.Warden Deputy County Surveyor
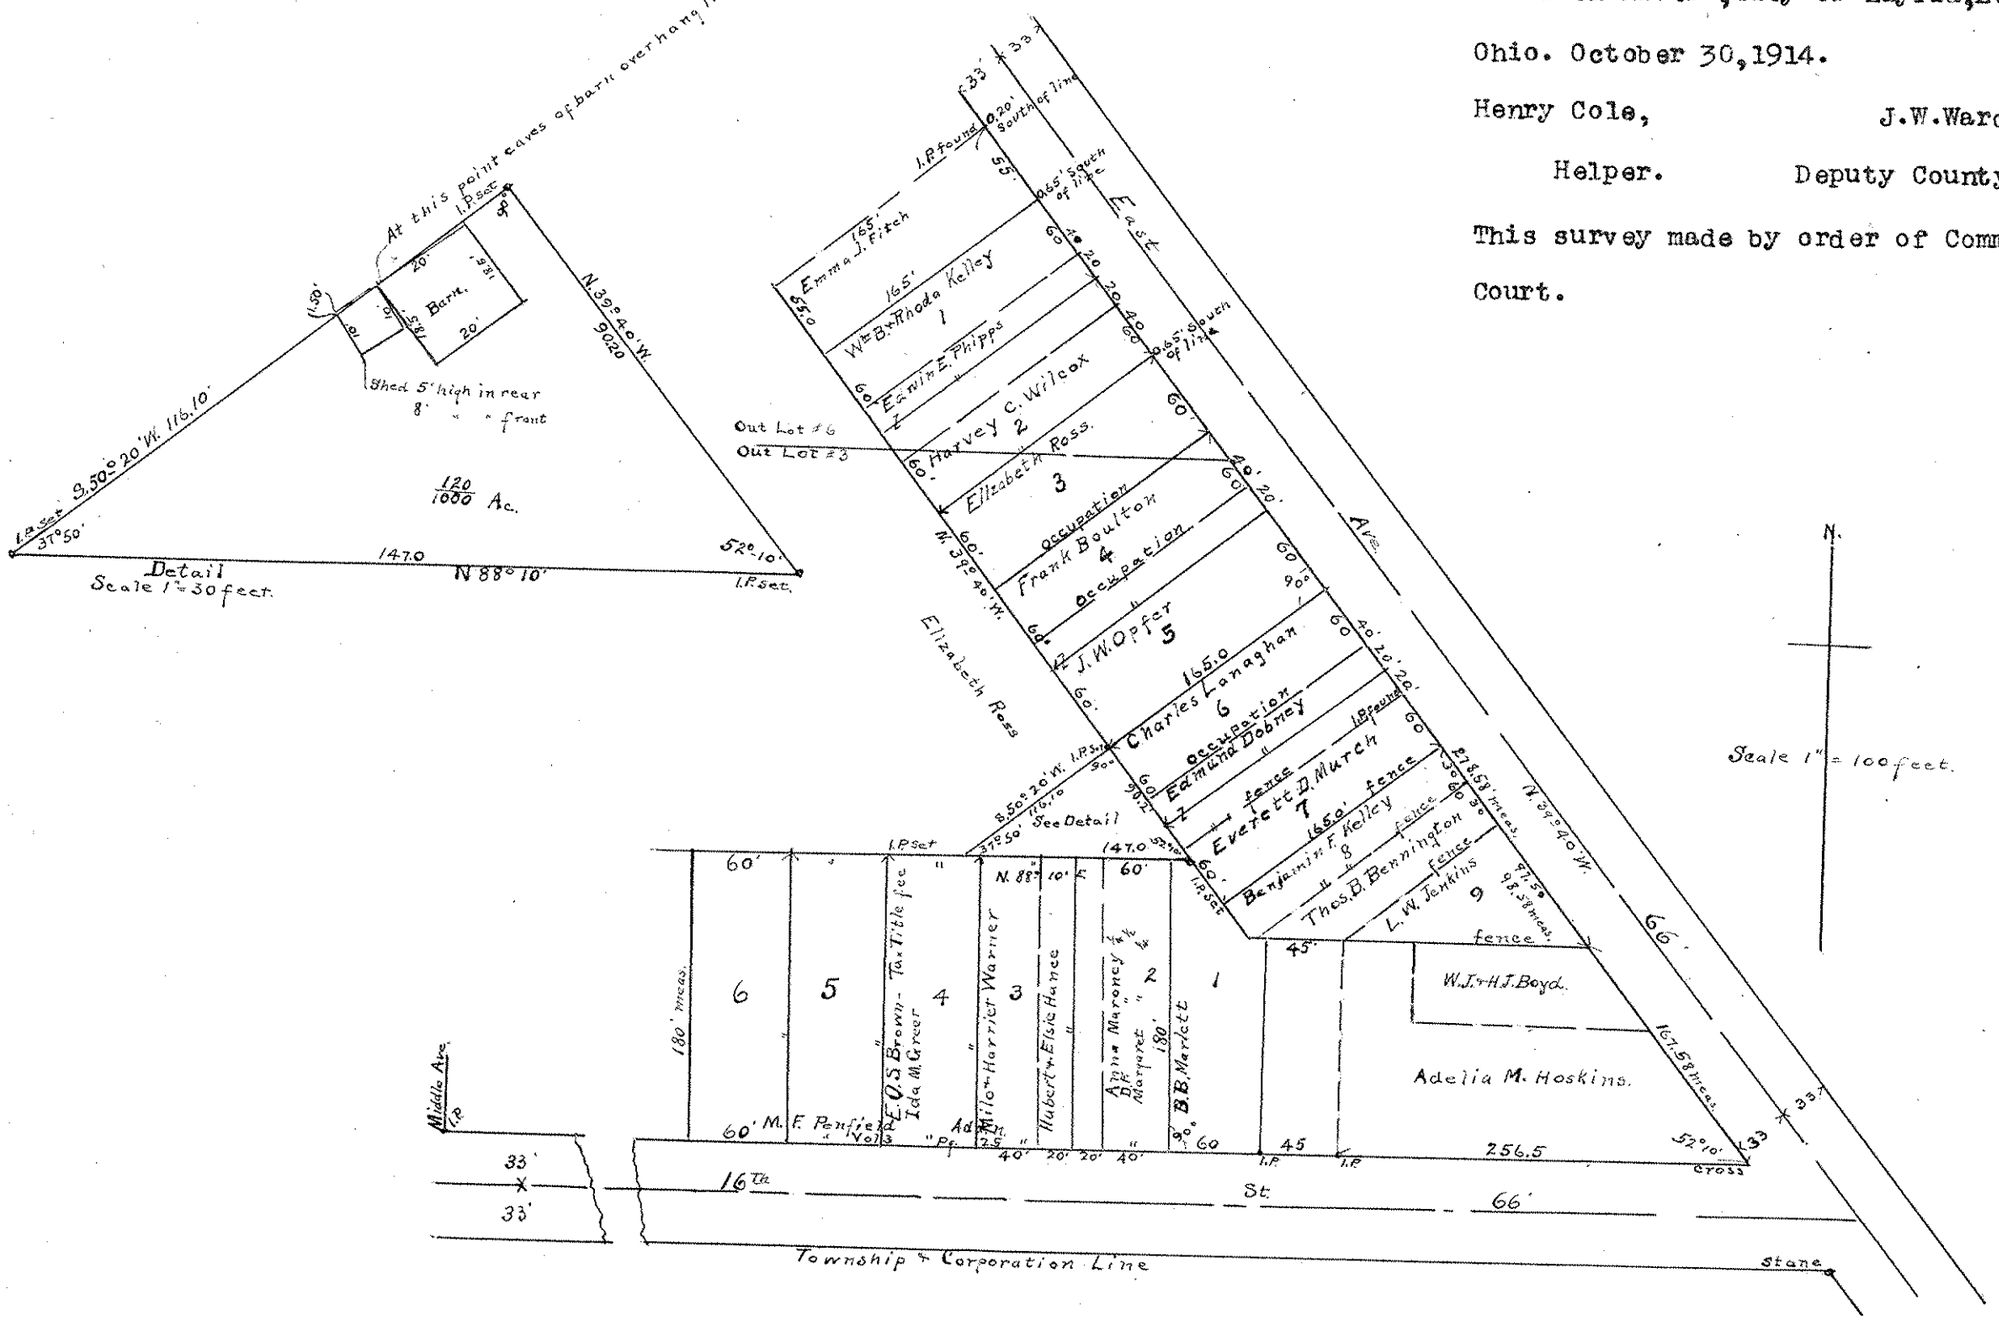
This survey made by order of Common Pleas Court.