Registered Number 2. *Registrant*

Subsequent Owners

,

,

,

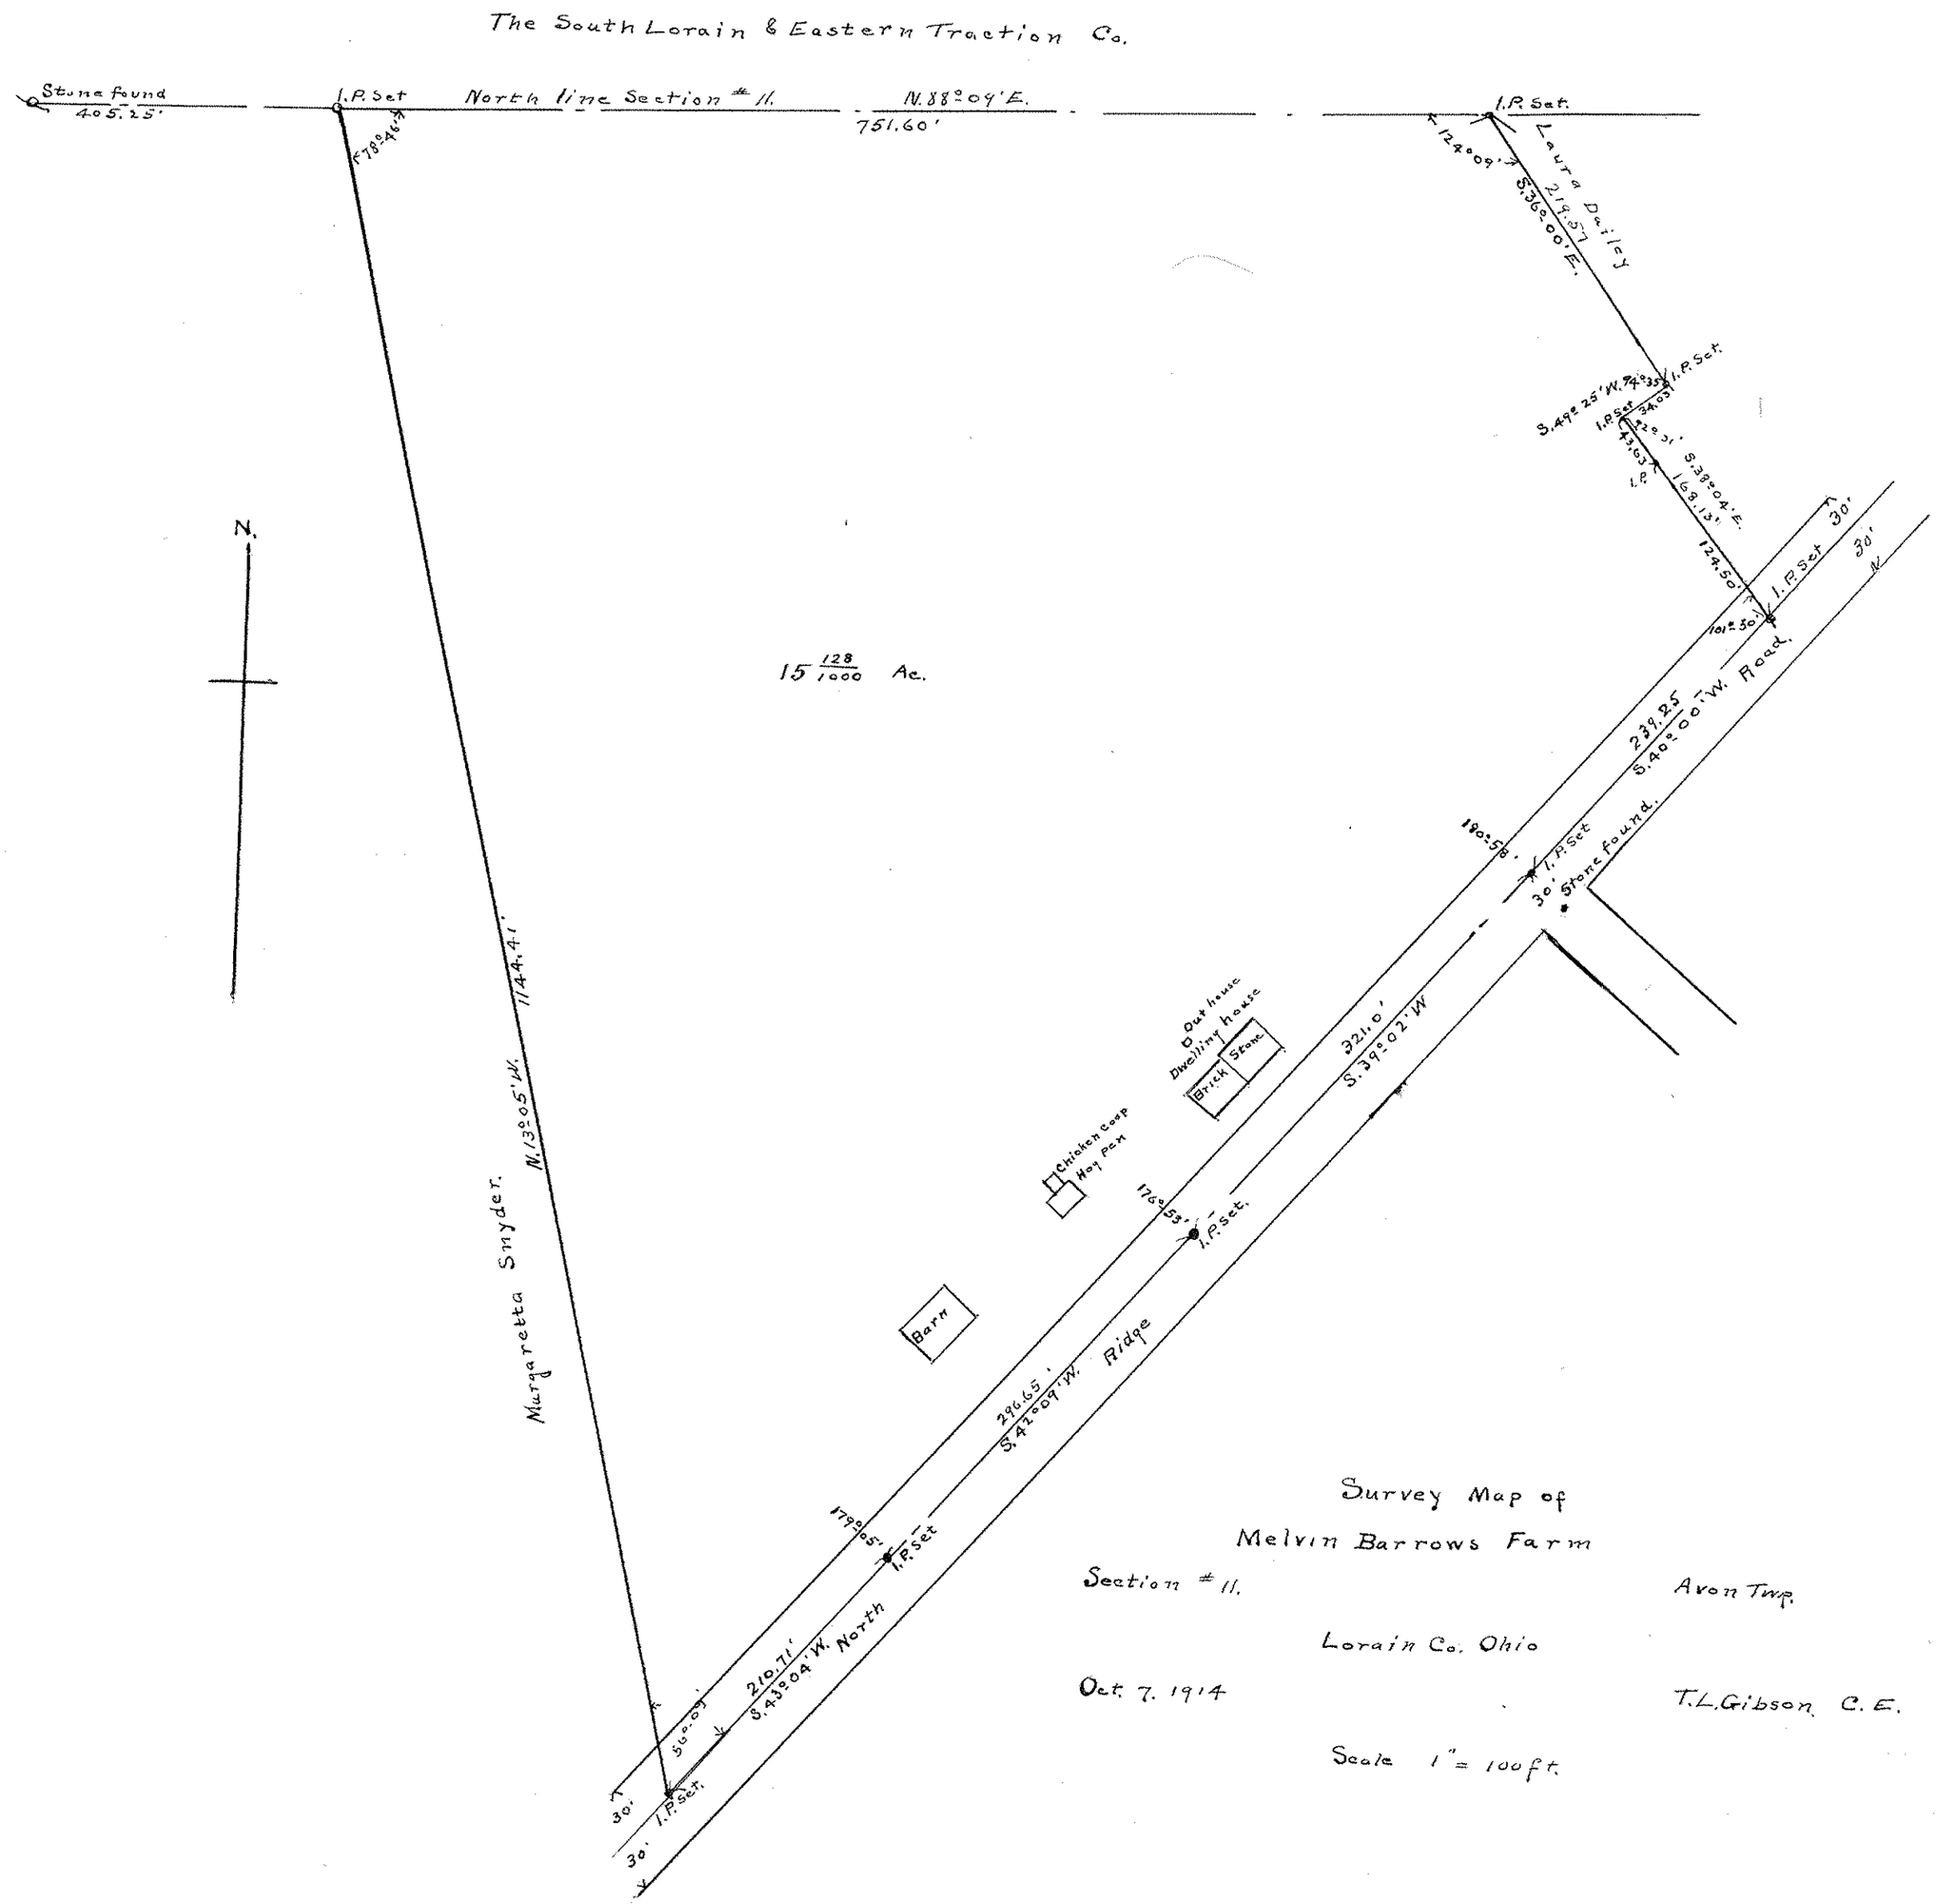

Survey Map of
Melvin Barrows Farm
Section # 11. Avon Twp.
Lorain Co. Ohio
Oct. 7. 1914 T.L. Gibson C.E.
Scale 1" = 100 ft.