


Being known as Part of Garfield Township Original Lot 13 and known as Lucas County Parcel Number 05-00-013-101-005, County of Lucas and the State of Ohio.

Note: Bearings and Coordinates shown are based on the Ohio State Plane (Quad West). They are used to describe angles only.

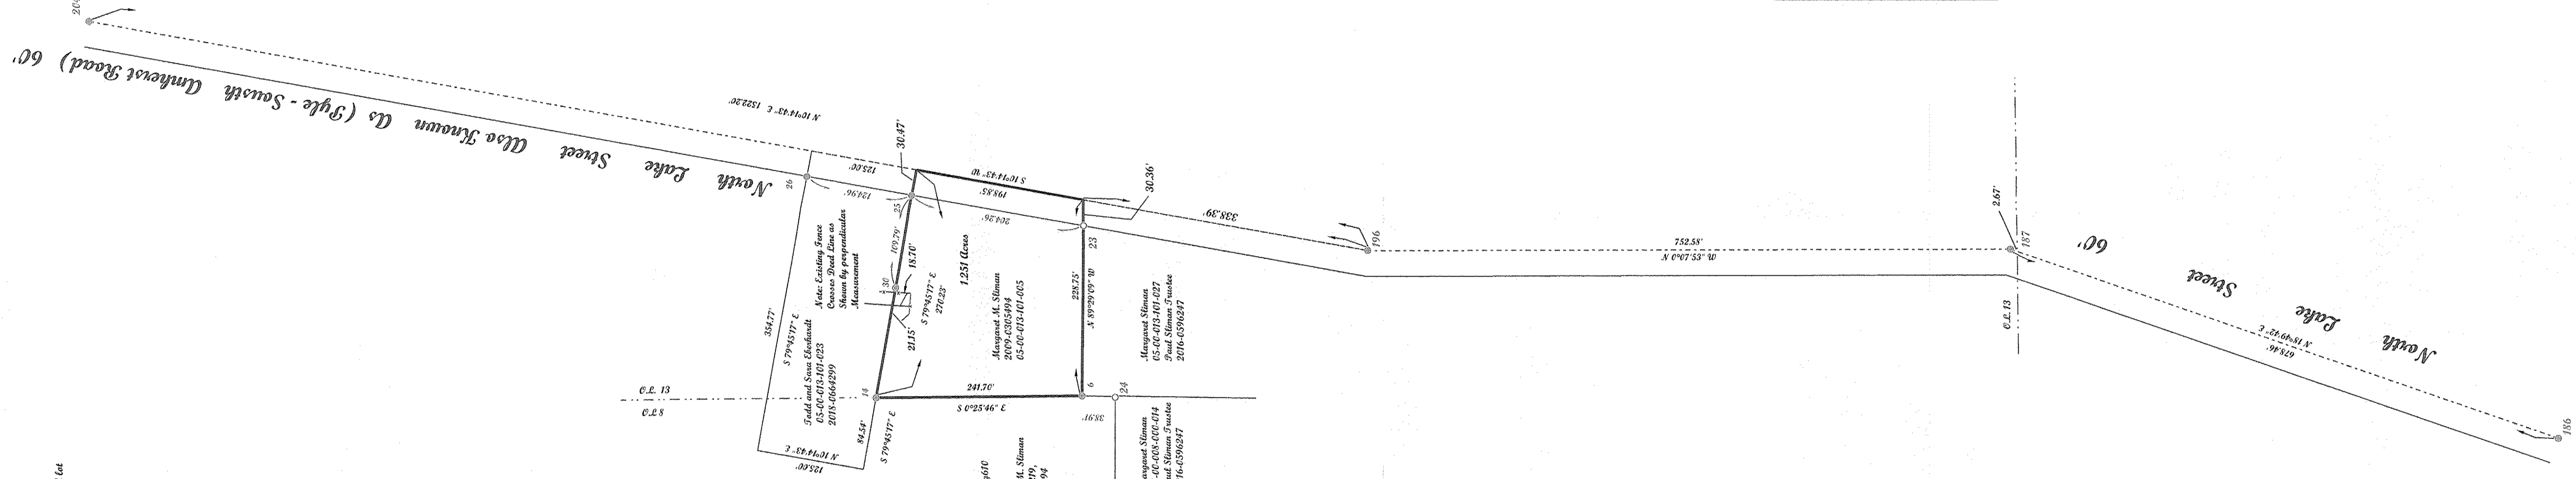

Elmhart Subdivision
 Lucas County
 Added to Tax Database
 June 25, 2005
 2010 64 Page 164, Vol. A Page 610

Also included in Deed to Margaret M. Sloman
 by deed recorded in Vol 024, Page 271,
 and Instrument number 2009-0305994

Margaret Sloman





Point Table


APPROVED
 LORAIN CO.
 MAP DEPT
 DATE 3-20-20
 PAGES 00 013
 BY B. MAINES
 #20-04203-A

05-00-013-101-005

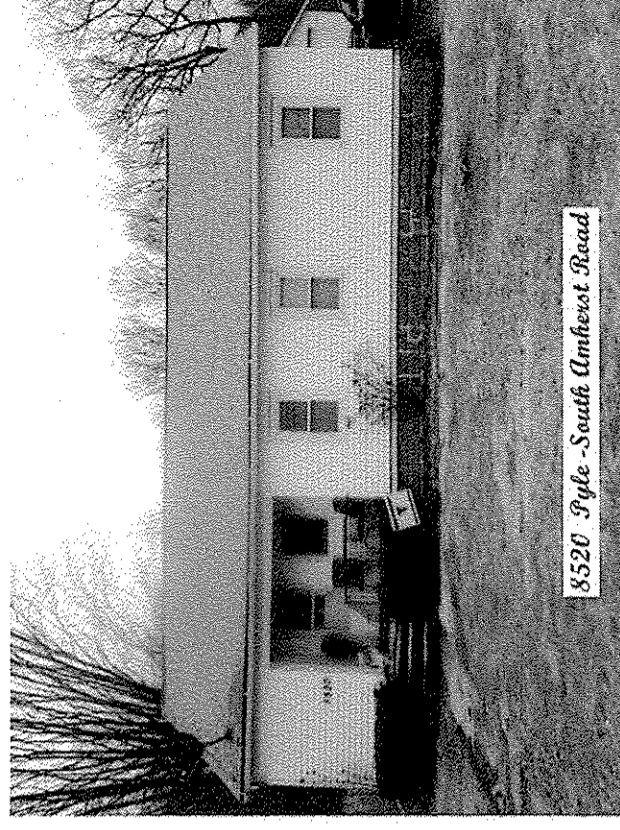


Prepared exclusively for the
 Estate of Margaret Sloman, Trust Sloman Trustee
 for the property at
 Lucas County, Ohio. This plat is a true and correct
 copy of the work made on 4/1/2020.


McGannon Surveying, LLC
Boundary Survey
Patrick A. McGannon
 Registered Professional Surveyor
 179 Gettysburg Drive, Lucas, Ohio 44653 (440) 282-2712
 www.mcgannosurveying.com

Note: Only copies signed with
 Seal and Stamp shall be considered valid.

Patrick A. McGannon
 Patrick A. McGannon, P.S. 7154

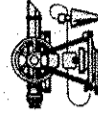

P.A.S.C.
 Member, Number 2433

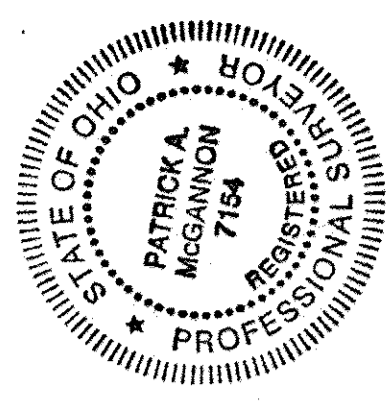

Note: Dimensions shown in Blue are noted
 on the plat and those shown in Red are field observed
 dimensions.
