


Note: Bearings and coordinates shown are based on the Ohio State Plane but are shown to describe angles only.

Being known as part of Original lot 60 of Amherst, Township, in the County of Lorain and the State of Ohio. And being known as Lorain County Parcel number 05-00-060-105-039




POINTS	NORTH	SOUTH	DESCRIPTION
13	637007.46	2653517.52	IRON PIN FOUND IN A MONUMENT BOX
14	636789.47	265351.01	IRON PIN FOUND
15	636721.24	2653192.46	IRON PIN FOUND IN A MONUMENT BOX
16	636658.66	2653191.54	IRON PIN FOUND
17	636658.10	2653191.92	IRON PIN FOUND
18	636535.37	2653244.96	IRON PIN FOUND sticking up high not level
34	636753.69	2653213.17	REBAR FOUND under
35	636739.47	2653251.11	IRON PIN FOUND
42	636311.51	2653332.70	REBAR FOUND under
43	636311.87	2653443.23	REBAR FOUND under
44	636399.96	2653543.73	IRON PIN FOUND 1.5 inch
45	636350.06	2653411.89	IRON PIN FOUND pipe
49	636666.52	2653345.44	REBAR SET
50	636609.43	2653461.27	REBAR SET
97	636146.52	2652987.75	IRON PIN FOUND bent
100	636669.74	2653357.02	REBAR SET
114	636473.00	2653410.80	REBAR SET
122	636503.71	2653515.05	REBAR SET
124	636010.04	2653557.20	IRON PIN FOUND bent
125	636105.08	2653529.08	fence post in coffee can
126	636051.57	2653550.92	IRON PIN FOUND
131	636050.49	2653323.61	fence post stone
300	636721.24	2653192.46	IRON PIN FOUND IN A MONUMENT
301	636303.82	2652663.09	IRON PIN FOUND IN A MONUMENT
303	636739.47	2653251.00	IRON PIN FOUND EBE: 14
304	636658.66	2653191.54	IRON PIN FOUND EBE: 16
305	636658.10	2653191.92	IRON PIN FOUND EBE: 17
307	636311.51	2653322.64	IRON PIN FOUND bent
308	636577.63	2653050.75	IRON PIN FOUND EBE: 38
309	636293.76	2653201.42	pipe found plumbing above on top EBE: 47
310	636311.13	2653237.35	IRON PIN FOUND bent EBE: 48
311	636311.41	2653262.59	IRON PIN FOUND bent EBE: 50
320	636311.36	2653237.65	REBAR SET EBE: 54
321	636639.65	2653129.21	REBAR SET EBE: 55
322	636571.66	2653055.39	REBAR SET EBE: 59
323	636264.43	2653143.74	fence post

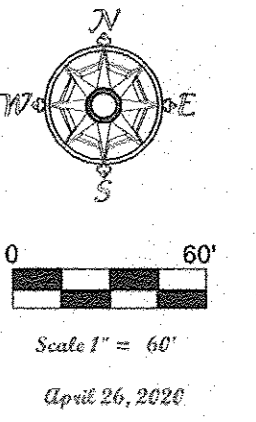

APPROVED
 LORAIN CO.
 MAP DEPT
 DATE 5-6-20
 PAGE 5-00-060
 BY R. MAINES
 #20-04325A
 05-00-060-105-039

McGannon Surveying, LLC
 Boundary Survey
 Patrick A. McGannon
 Registered Professional Surveyor
 1731 Gettysburg Drive, Lorain, Ohio 44053 (440) 282-2712
 www.mcgannonsurveying.com

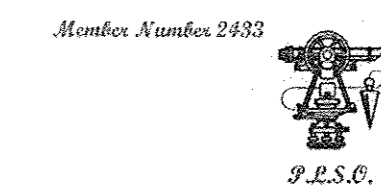

Note: Dimensions shown in blue are record values and those shown in red are field observed values.

