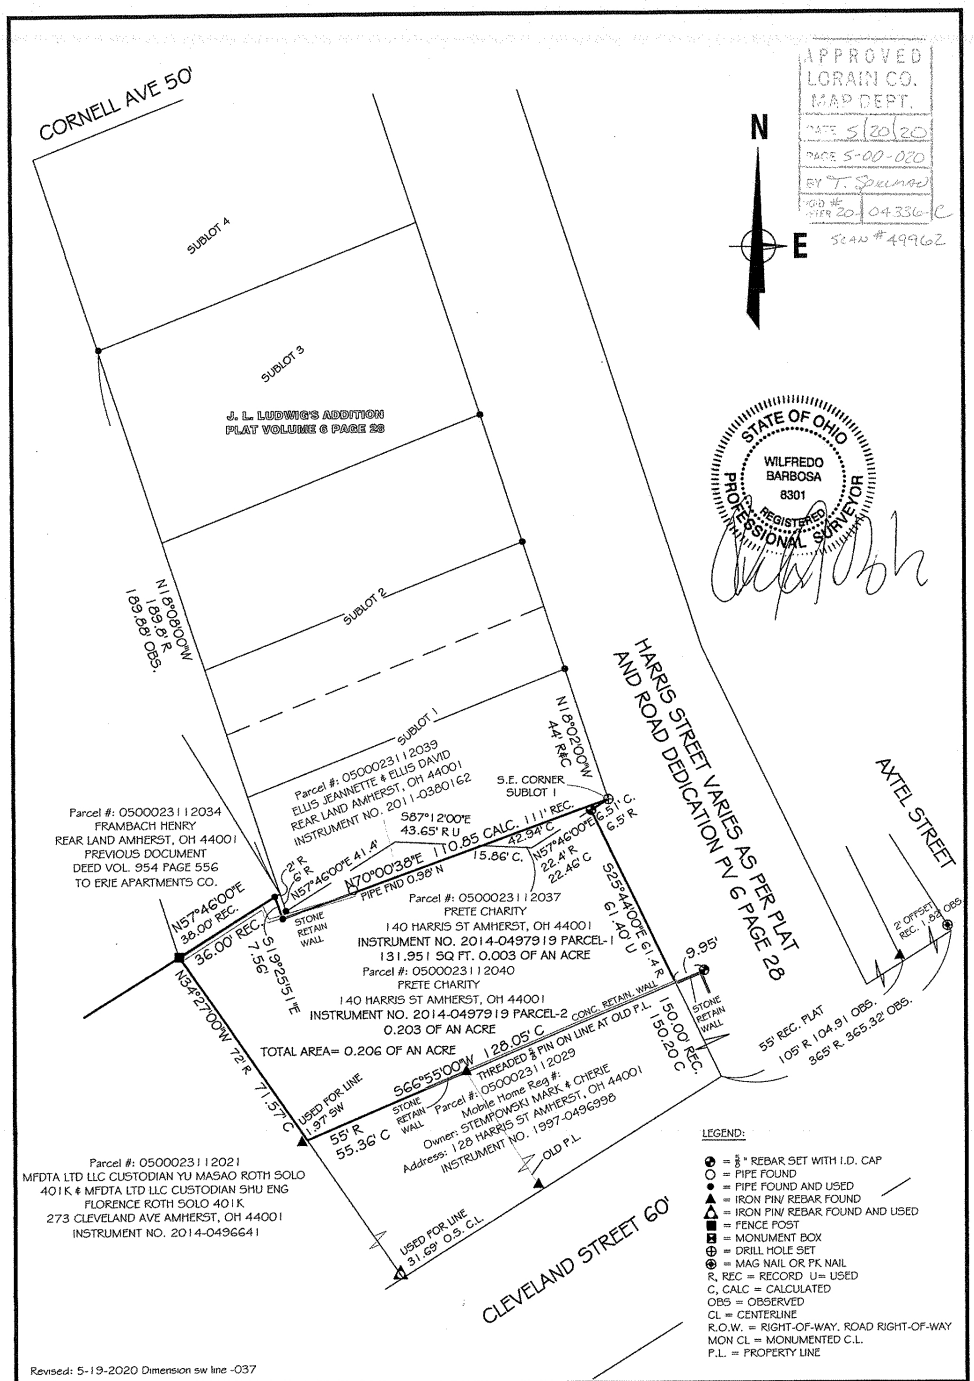

Revised: 5-19-2020 Dimension sw line -037

PROPERTY ADDRESS: **140 HARRIS STREET AMHERST OHIO 44001**	**BARBOSA AND ASSOCIATES LLC** 5604 CASE ROAD NORTH RIDGEVILLE, OH 44039 440 327-4776	GRAPHIC SCALE 0 30 15 (IN FEET) 60
PREPARED AT THE REQUEST OF: CHARITY THOMAS	5/13/2020	SCALE: 1" = 30'
	JOB No: 2020-5-1 SHEET 1 of 1	