

APPROVED
LORAIN CO.
MAP DEPT
DATE 7-17-20
PAGE 7-00-020
BY B. MAINES
20-04151




Parcel # 0700020101103
KOTAS FRANK W & CHARLENE A
5791 AVON BELDEN RD
NORTH RIDGEVILLE, OH 44039 INST. NO.
2000-0694244

Parcel # 0700020101042
BALDAUF MARCELLA TRUSTEE
5725 AVON BELDEN RD
NORTH RIDGEVILLE, OH 44039
INST. NO. 1994-0304901
ORV 951 PG 723

Parcel # 0700020101005
HOOVER JESSE & AVALOS OLIVIA R
5805 AVON BELDEN RD
NORTH RIDGEVILLE, OH 44039
INST. NO. 2019-0738600

Parcel # 0700020101006
SHAFFER ERIC T
5845 AVON BELDEN RD
NORTH RIDGEVILLE, OH 44039
INST. NO. 2012-0441552

Parcel # 0700020101115
PINCOMBE DONALD F
5927 RHONDA DR
NORTH RIDGEVILLE, OH 44039
INST. NO. 2019-0704717

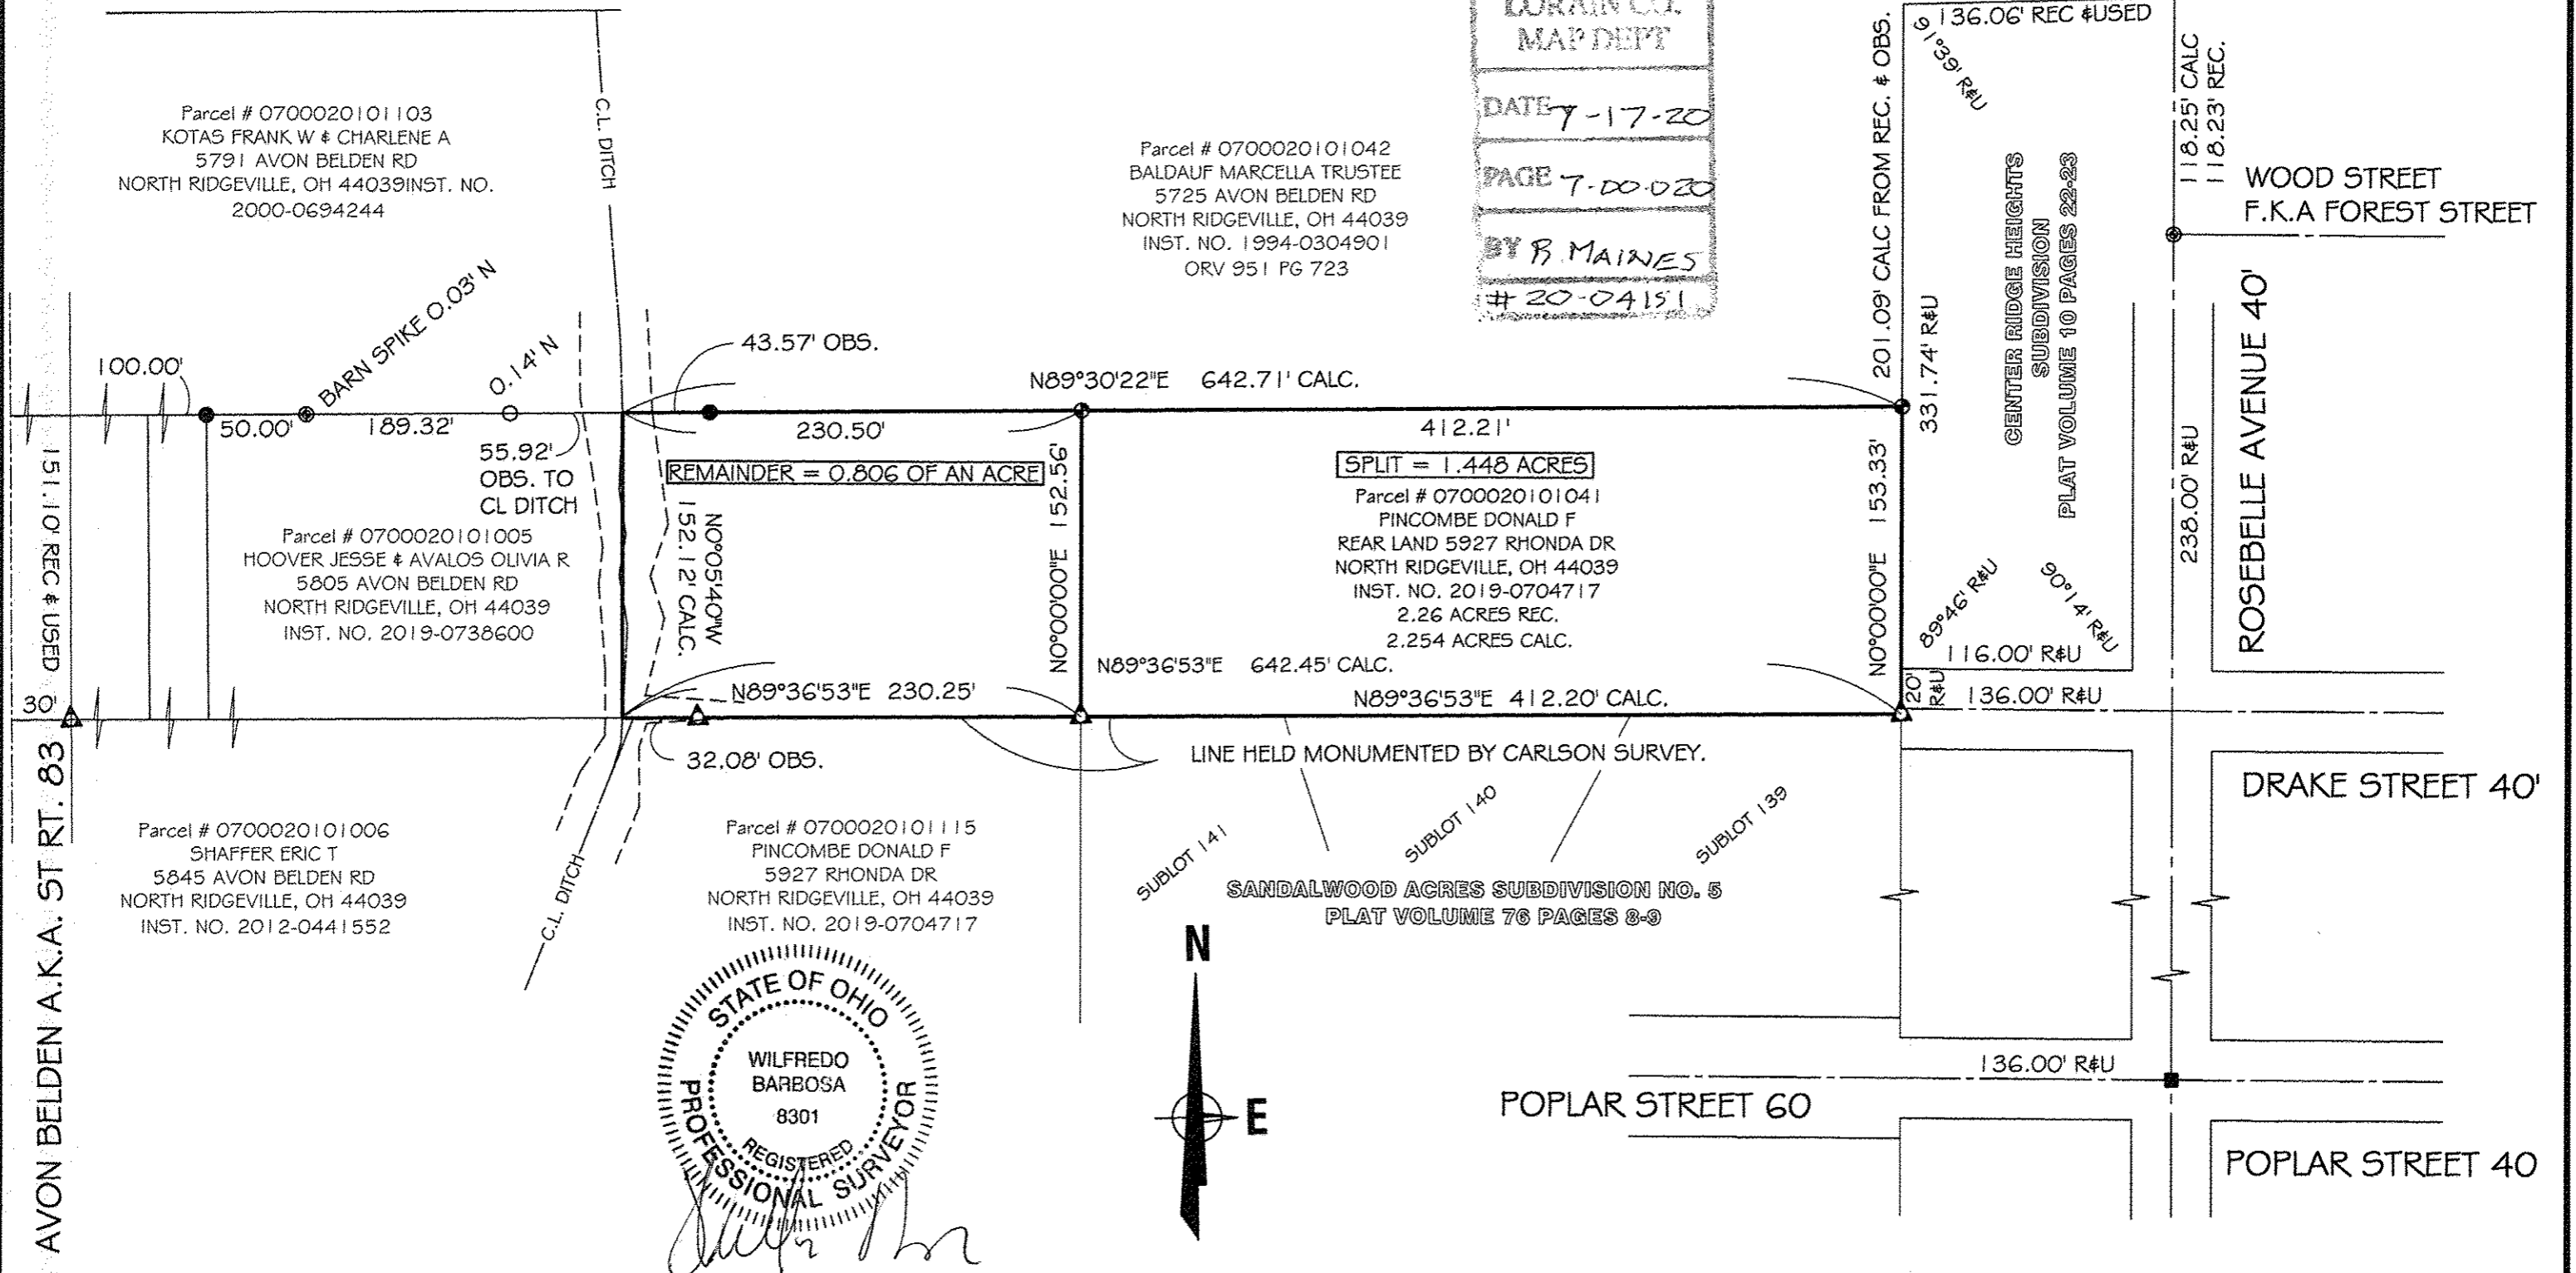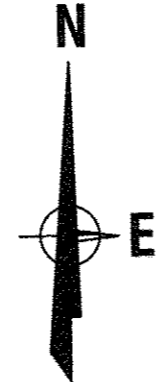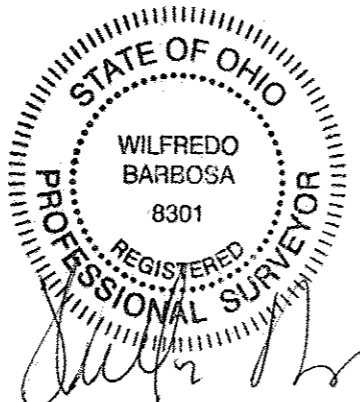

PROPERTY ADDRESS:
REAR LAND 5927 RHONDA DRIVE
NORTH RIDGEVILLE, OHIO 44039


PREPARED AT THE REQUEST OF:
DONALD PINCOMBE

BARBOSA AND ASSOCIATES LLC
5604 CASE ROAD
NORTH RIDGEVILLE, OH 44039
440 327-4776

6/15/2020

JOB No: 2020-5-3

SHEET 1 of 1

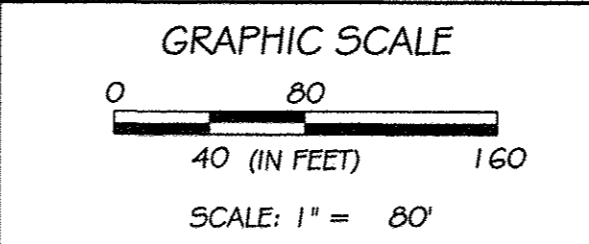

SURVEY

OF PART OF ORIGINAL RIDGEVILLE TWP LOT 20
CITY OF NORTH RIDGEVILLE COUNTY OF LORAIN
STATE OF OHIO

- LEGEND:
- ⊙ = 3/8" REBAR SET WITH I.D. CAP
 - ⊕ = NAIL SET OR FOUND
 - ⊖ = DRILL HOLE SET
 - = PIPE FOUND
 - = PIPE USED
 - ▲ = IRON PIN/ REBAR FOUND
 - ▲ = IRON PIN/ REBAR FOUND AND USED
 - = MONUMENT BOX
 - R, REC = RECORD U= USED
 - C, CALC = CALCULATED T.M. = TAX MAP
 - OBS = OBSERVED CL = CENTERLINE