



DIMENSIONS SHOWN ON THIS PLAT ARE EXPRESSED IN FEET AND DECIMAL PARTS THEREOF, ALL BEARINGS ARE TO AN ASSUMED MERIDIAN AND ARE USED TO INDICATE ANGLES ONLY. PERMANENT MONUMENTS WERE FOUND OR SET AT ALL POINTS INDICATED HEREON, ALL OF WHICH I CERTIFY TO BE CORRECT.

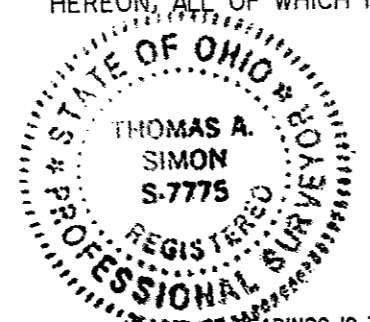

*Thomas A. Simon*  
 THOMAS A. SIMON  
 REG. PROFESSIONAL SURVEYOR  
 NO. S-7775

BASE OF BEARINGS IS THE CENTERLINE OF WHEELER ROAD (NORTH 00°26'48" WEST). IRON PINS SET ARE 5/8" DIAMETER, 30" LONG WITH PLASTIC CAPS "T. SIMON, S-7775".

**THOMAS SIMON & ASSOCIATES, INC.**  
 PROFESSIONAL LAND SURVEYORS  
 150 SOUTH OLIVE STREET  
 ELYRIA, OHIO 44035  
 (440) 327-2925  
 FAX 327-2964

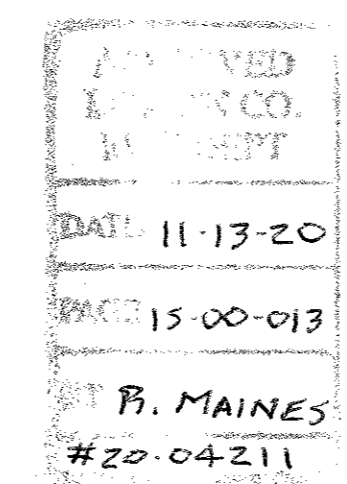

15-00-013-000-028  
 -029  
 -030

PLAT OF BOUNDARY SURVEY AND SPLIT FOR TRENA L. ALBRECHT, TR.

BEING KNOWN AS PART OF ORIGINAL LAGRANGE TOWNSHIP LOT NO. 13  
 COUNTY OF LORAIN STATE OF OHIO  
 AUGUST, 2020 SCALE: 1" = 200'