


SURVEY OF 10.9997 ACRES
 OF PART OF ORIGINAL AVON TWP. SEC. NO. 29
 NOW IN THE CITY OF AVON LAKE, LORAIN COUNTY, OH
 FOR
UNITED MODEL HOMES, LLC
 BY
 THE HENRY G. REITZ ENGINEERING COMPANY
 4214 ROCKY RIVER DRIVE, CLEVELAND, OH. 44135
 PHONE: (216) 251-3033 reitz@reitzeng.com

BY *[Signature]* 12/21/2020 VICE PRES.
 JAMES T. SAYLER REG. SURVEYOR # S-7425
 SCALE: 1"=60' SEPTEMBER, 2020

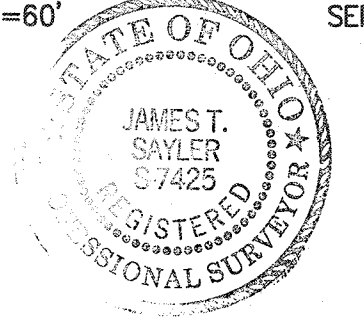


Approved By The City of Avon Lake
NO PLAT REQUIRED

[Signature] 12/21/2020
 Gary Tipping, P.E., City Engineer

LEGEND:

- DENOTES 5/8" CAPPED (REITZ ENG) IRON PINS SET.
- DENOTES 5/8" CAPPED (REITZ ENG) IRON PIN FOUND & USED UNLESS OTHERWISE NOTED

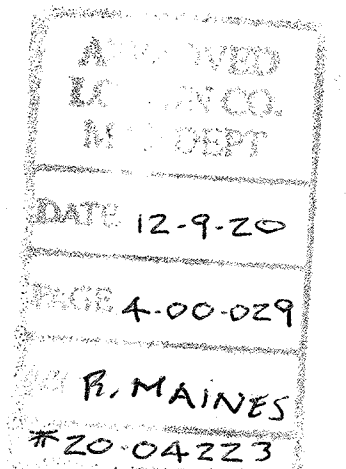

04-00-029-116-109
 - 110

