


DIMENSIONS SHOWN ON THIS PLAT ARE EXPRESSED IN FEET AND DECIMAL PARTS THEREOF, ALL BEARINGS ARE TO AN ASSUMED MERIDIAN AND ARE USED TO INDICATE ANGLES ONLY. PERMANENT MONUMENTS WERE FOUND OR SET AT ALL POINTS INDICATED HEREON, ALL OF WHICH I CERTIFY TO BE CORRECT.

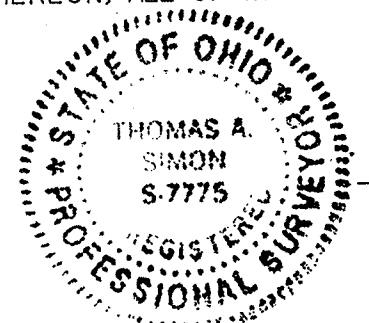


*Thomas A. Simon*  
THOMAS A. SIMON  
REG. PROFESSIONAL SURVEYOR  
NO. S-7775

BASIS OF BEARINGS IS THE CENTERLINE OF SOUTH CENTER STREET (NORTH 01°55'59" EAST). IRON PINS SET ARE 5/8" DIAMETER, 30" LONG WITH PLASTIC CAPS "T. SIMON, S-7775".

I. PIN FD.  
30.74' C/L

I. PIN FD.  
30.10' C/L

I. PIN FD.  
& USED  
30.00' C/L  
"KELSER"

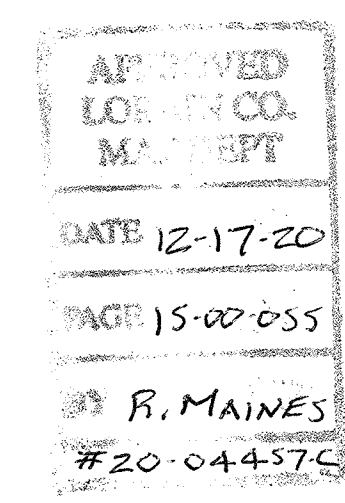

PLAT OF BOUNDARY SURVEY  
FOR  
DEAN E. & CHRYSTAL POLING

BEING KNOWN AS PART OF LOT NO. 93 OF THE PLAT OF THE VILLAGE OF LAGRANGE AS RECORDED IN PLAT VOLUME 1 PAGE 4 AND PARTS OF SUBLOTS 3,4,5 AND 9 OF THE PLAT OF THE VILLAGE OF LAGRANGE (RE-RECORDED) IN PLAT VOLUME 2 PAGE 24 BOTH OF LORAIN COUNTY MAP RECORDS AND PART OF ORIGINAL LAGRANGE TOWNSHIP LOT NO. 55

VILLAGE OF LAGRANGE COUNTY OF LORAIN  
STATE OF OHIO

DECEMBER, 2016 SCALE: 1" = 60'  
DECEMBER, 2020

THOMAS SIMON & ASSOCIATES, INC.  
PROFESSIONAL LAND SURVEYORS

150 SOUTH OLIVE STREET  
ELYRIA, OHIO 44035

(440) 327-2925  
FAX 327-2964

15-00-055-102-002