MAP OF SURVEY

PREPARED FOR

WILSON

Situated in the Avon Lake, County of Lorain and State of Ohio and known as being part of Original Avon Township Section No. 6

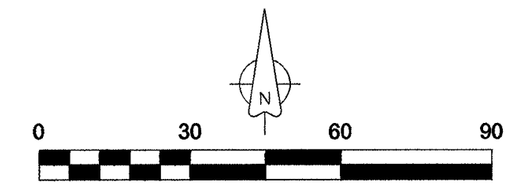

Scale: 1" = 30'

September, 2020

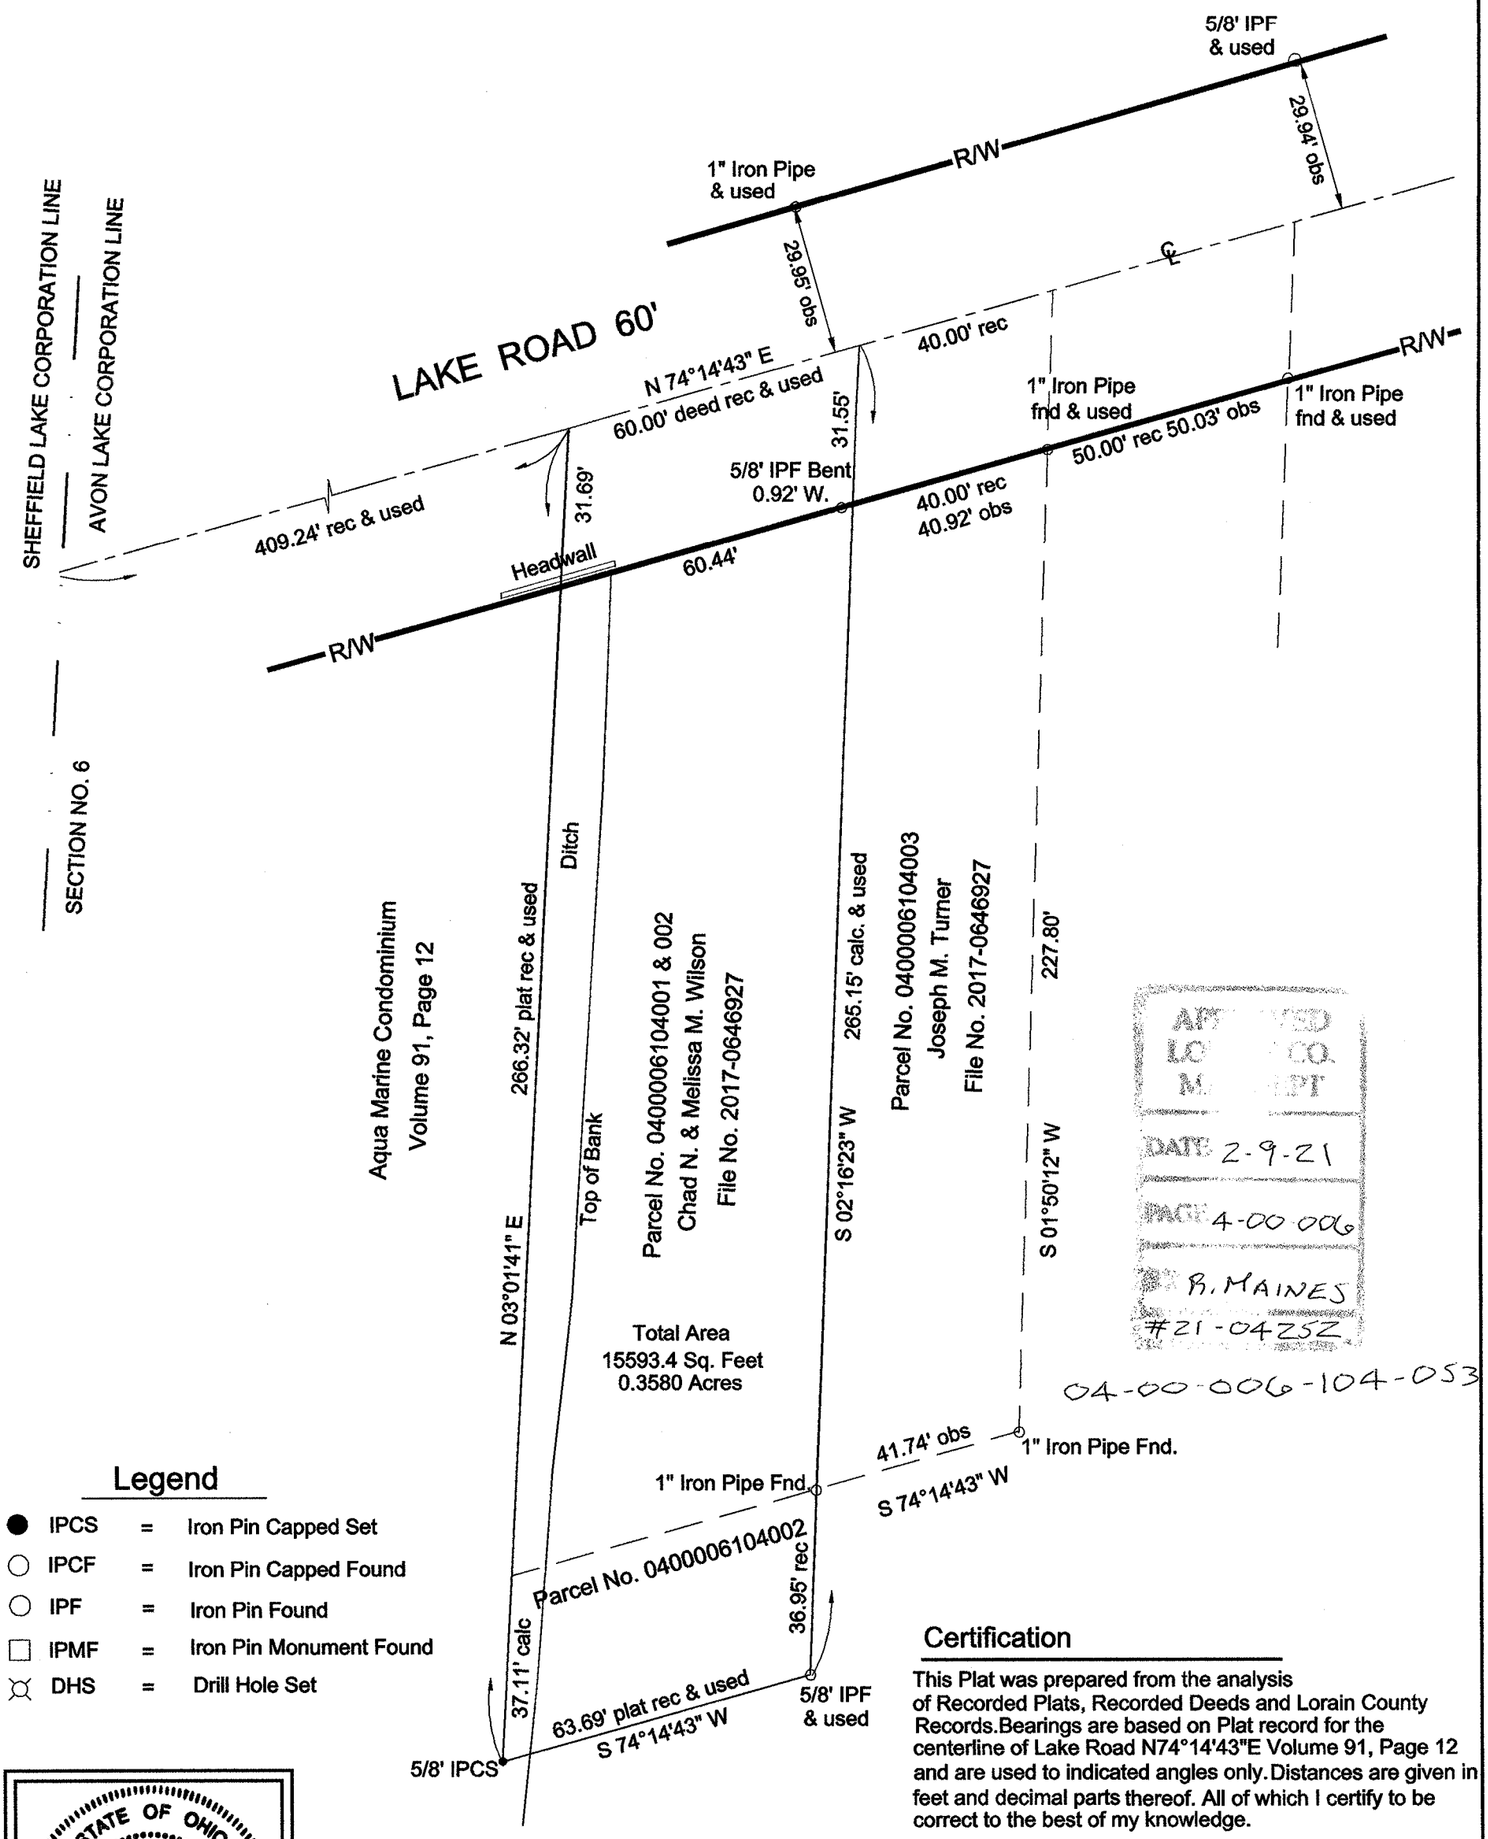

AP WSD
LC CO.
M. PT
DATE: 2-9-21
PAGE 4-00 006
B. MAINES
#21-0425Z

04-00-006-104-053

Legend

●	IPCS	= Iron Pin Capped Set
○	IPCF	= Iron Pin Capped Found
○	IPF	= Iron Pin Found
□	IPMF	= Iron Pin Monument Found
⊠	DHS	= Drill Hole Set

STATE OF OHIO
SEAN A. BOLAND
7699
REGISTERED
PROFESSIONAL SURVEYOR

Certification

This Plat was prepared from the analysis of Recorded Plats, Recorded Deeds and Lorain County Records.Bearings are based on Plat record for the centerline of Lake Road N74°14'43"E Volume 91, Page 12 and are used to indicated angles only. Distances are given in feet and decimal parts thereof. All of which I certify to be correct to the best of my knowledge.

S A Boland 10/9/20

Sean A. Boland, P.S.
Registered Ohio Professional
Surveyor 7699
440 785-2943
bolandsurveying@gmail.com