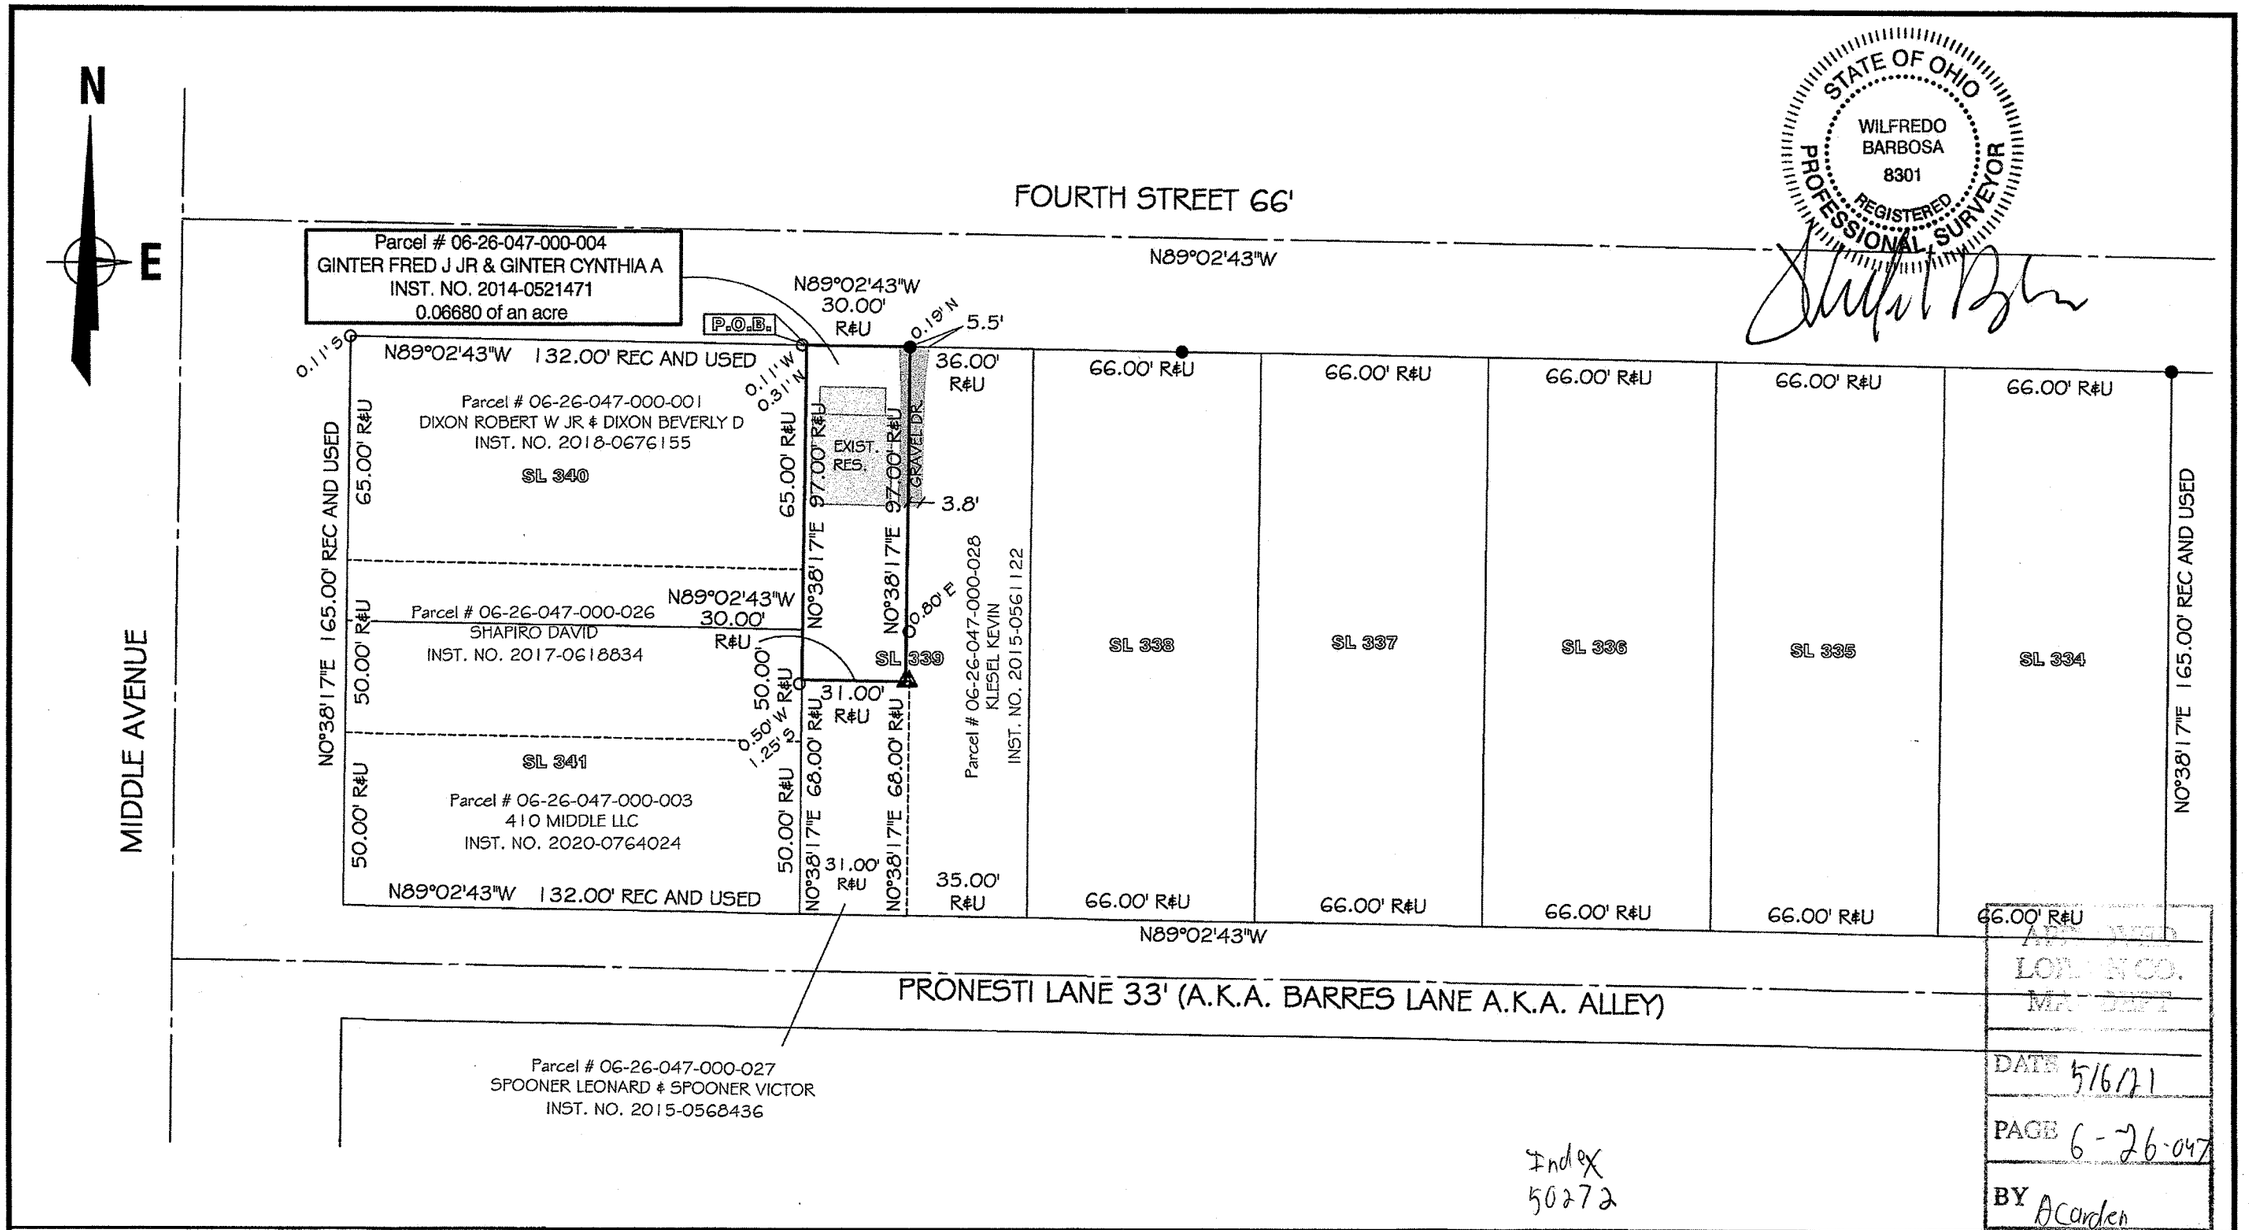

Index
50272

APPROVED
LORAIN CO.
MAP DEPT

DATE 5/6/21

PAGE 6-26-047

BY ACarden

21-04543-D

PROPERTY ADDRESS: **252 4th Street** **Elyria, Ohio 44035**	**BARBOSA AND ASSOCIATES LLC** 5604 CASE ROAD NORTH RIDGEVILLE, OH 44039 440 327-4776	GRAPHIC SCALE 0 40 20 (IN FEET) 80 SCALE: 1" = 40'	SURVEY PART OF SUBLOT 339 HEMAN ELY'S ORIGINAL TOWN PLAT OF ELYRIA PLAT VOLUME 3 PAGE 14 ELYRIA TOWNSHIP 47 BETWEEN THE BRANCHES OF THE BLACK RIVER CITY OF ELYRIA COUNTY OF LORAIN STATE OF OHIO
PREPARED AT THE REQUEST OF: Cynthia Ginter	5/5/2021 JOB No: 2021-4-3		

LEGEND:
- ⊕ = 5/8" REBAR SET WITH I.D. CAP
- ○ = PIPE FOUND ● = PIPE FOUND & USED
- ▲ = IRON PIN/ REBAR FOUND
- △ = IRON PIN/ REBAR FOUND AND USED
- ■ = MONUMENT BOX Ⓢ = SPIKE
- R, REC = RECORD U= USED
- C, CALC = CALCULATED T.M. = TAX MAP
- OBS = OBSERVED CL = CENTERLINE