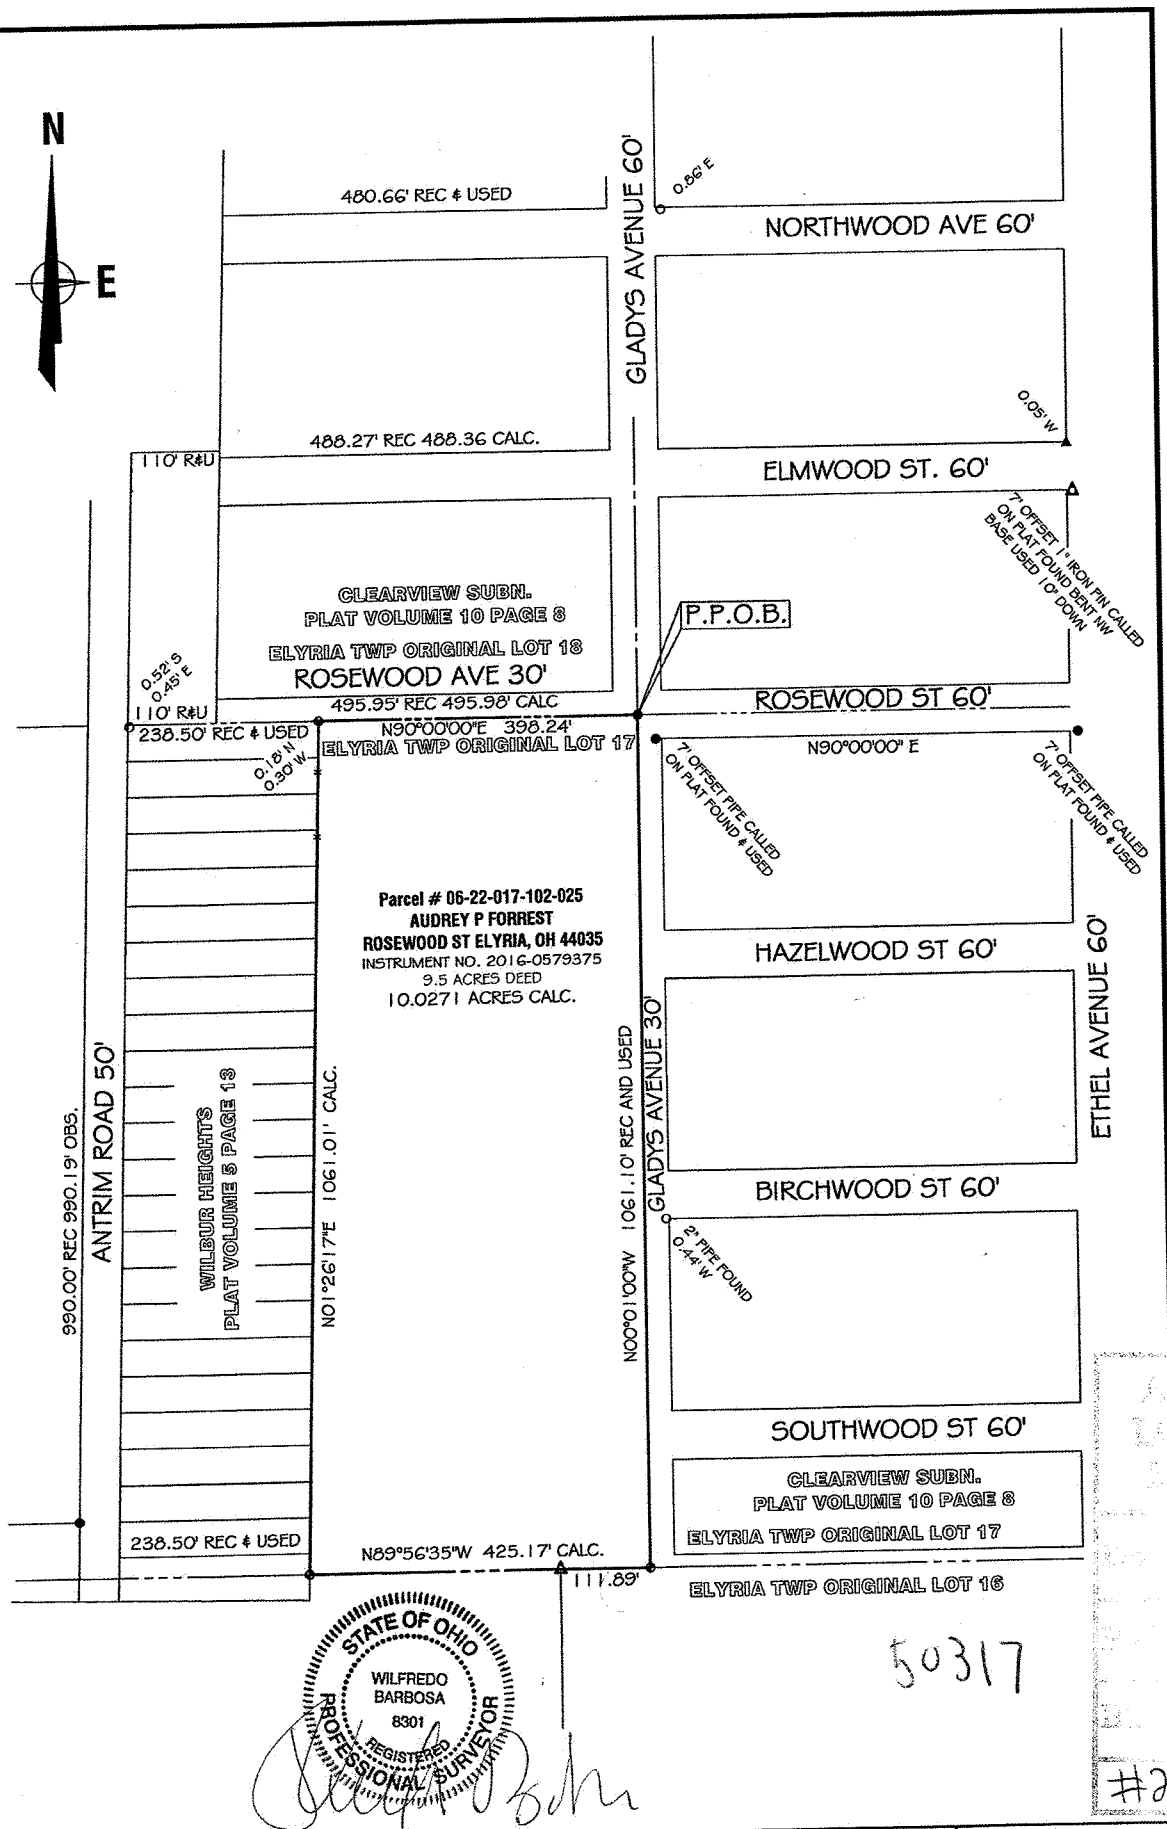

50317

7/1/21

06-7

A Carden

#21-04594-C

BARBOSA AND ASSOCIATES LLC 5604 CASE ROAD NORTH RIDGEVILLE, OH 44039 440 327-4776 PREPARED AT THE REQUEST OF: Audrey and Dave Forrest	GRAPHIC SCALE 0 150 75 300 SCALE: 1" = 150'	BOUNDARY RETRACEMENT PARCEL 06-22-017-102-025 ORIGINAL ELYRIA TWP LOT NO. 17 TOWNSHIP OF ELYRIA COUNTY OF LORAIN STATE OF OHIO June 30, 2021 JOB No: 2021-6-8	LEGEND: ⊕ = STEEL POST / FENCE POST ● = ¾" REBAR SET WITH I.D. CAP ○ = PIPE FOUND ● = PIPE USED ▲ = IRON PIN/ REBAR FOUND △ = IRON PIN/ REBAR FOUND AND USED ■ = MONUMENT BOX R, REC = RECORD U= USED C, CALC = CALCULATED T.M. = TAX MAP OBS = OBSERVED CL = CENTERLINE