

DATE: Augustn16, 2021

BOUNDARY SURVEY  
FOR

**ERIC J. SPIETH**

SITUATED IN THE CITY OF OBERLIN, COUNTY OF LORAIN  
AND STATE OF OHIO, AND KNOWN AS BEING PARTS OF VILLAGE  
LOTS NOS. 41 AND 104 OF THE ORIGINAL TOWN PLAT OF OBERLIN VILLAGE  
VOL. No. 5 PG. 30 OF LORAIN COUNTY MAP RECORDS

H.N. 227 NORTH MAIN STREET  
P.P.N. 09-00-076-101-059

LOT 41  
LOT 104

OBERLIN BOARD OF EDUCATION  
INS. 1990-086200

NO1'00'00"W

6' Chain Link Fence 82.50'

6' Wire Fence  
3/4" I.Pipe Fd.  
1.33'N & 1.55'W

THOMAS G. RANKIN  
INS: 2003-0907389  
09-00-076-101-017  
N89°00'00"E 198.00'

09-00-076-101-059

Extg.  
Gar.

3' Wood  
Picket Fnc

N89°00'00"E 198.00'

1/2" Capped  
I.Pin Set

6' Wire Fence

VILLAGE OF OBERLIN  
VOL. 190, PG. 168  
09-00-076-101-020

132.00

589°00'00"W

25.00'

1/2" I.Pin  
Fd. & Used

66.00'

521.73' Obs

42.37'

488.75' Obs

1/2" I.Pin Fd. Bent  
1.06'N & 0.16'W

09-00-076-101-010  
09-00-076-101-011  
3/4" I.Pipe  
Fd. & Used


NO1'00'00"W

NORTH MAIN ST. 66FT.

WALNUT ST. 50FT.

50374

APPROVED LORAIN CO. MAYOR	DATE 9/3/21	PAGE 09-00-076	BY A.Carden	#21-04657-A
---------------------------------	-------------	----------------	-------------	-------------

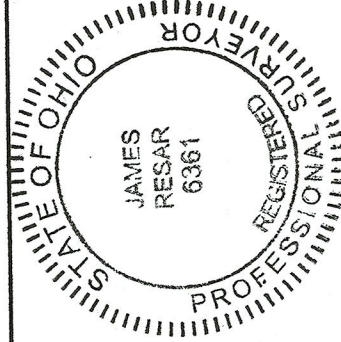

**J.A.R. Engineering  
& Surveying, Inc.**

24629 DETROIT ROAD WESTLAKE, OHIO 44145  
Phone: (440)-871-8345

*James A. Resar P.E., P.S.*