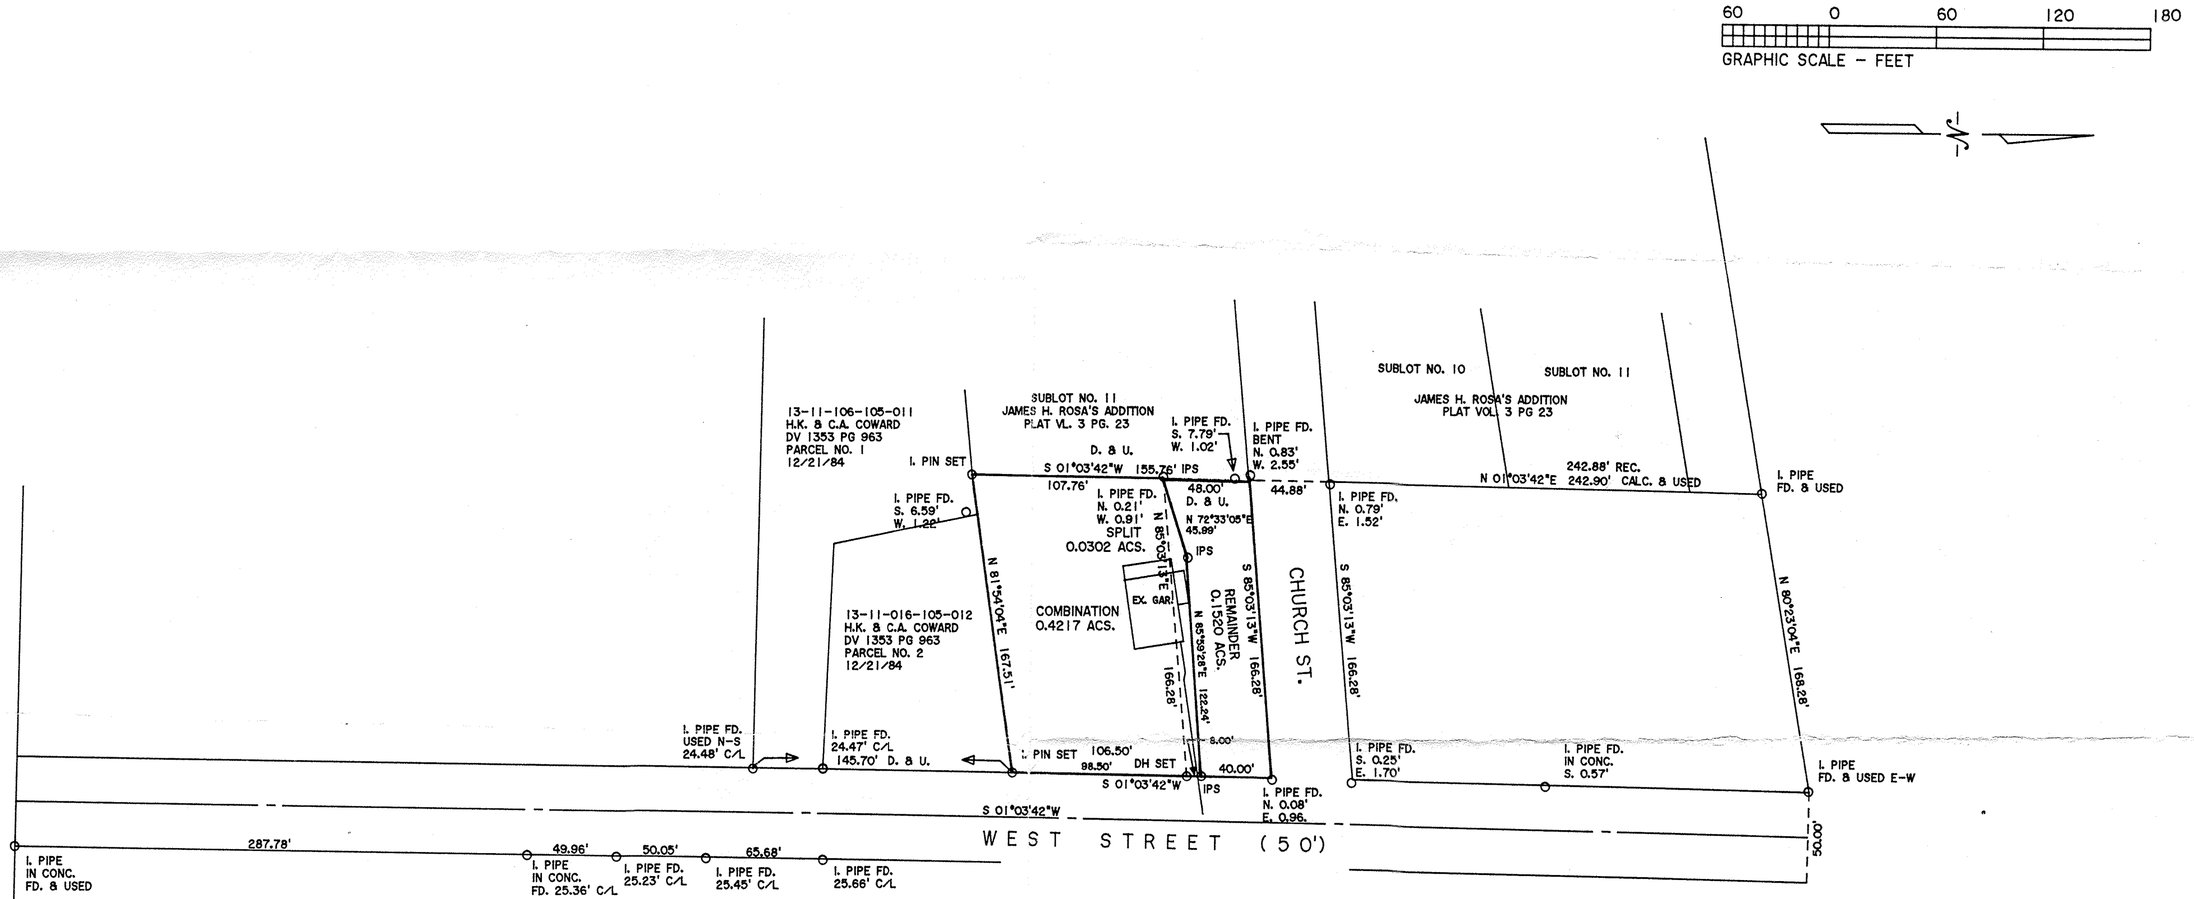

APPROVED
T. ORAS CO.
MAP DEPT
1/3/22
13-11-016
WRZ
22-04426
50485

DIMENSIONS SHOWN ON THIS PLAT ARE EXPRESSED IN FEET AND DECIMAL PARTS THEREOF, ALL BEARINGS ARE TO AN ASSUMED MERIDIAN AND ARE USED TO INDICATE ANGLES ONLY. PERMANENT MONUMENTS WERE FOUND OR SET AT ALL POINTS INDICATED HEREON, ALL OF WHICH I CERTIFY TO BE CORRECT.

STATE OF OHIO THOMAS A. SIMON S-7 REGISTERED PROFESSIONAL SURVEYOR

THOMAS A. SIMON
REG. PROFESSIONAL SURVEYOR
NO. S-7775

BASIS OF BEARINGS IS THE CENTERLINE OF WEST STREET (NORTH 01°03'42" EAST). IRON PINS SET ARE 5/8" DIAMETER, 30" LONG WITH PLASTIC CAPS "T. SIMON, S-7775".

THOMAS SIMON & ASSOCIATES, INC.
PROFESSIONAL LAND SURVEYORS

150 SOUTH OLIVE STREET
ELYRIA, OHIO 44035

(440) 327-2925
FAX 327-2964

PLAT OF BOUNDARY SURVEY
SPLIT & COMBINATION
FOR
TIMMY LEE BAKER
GLENDOLA ZICKEFOOSE

BEING KNOWN AS PART OF
ORIGINAL CAMDEN TOWNSHIP LOT NO. 16
TRACT II

VILLAGE OF KIPTON COUNTY OF LORAIN
STATE OF OHIO

OCTOBER, 2021 SCALE: 1" = 60'

JOB NO. 2021-080

CORRECTION