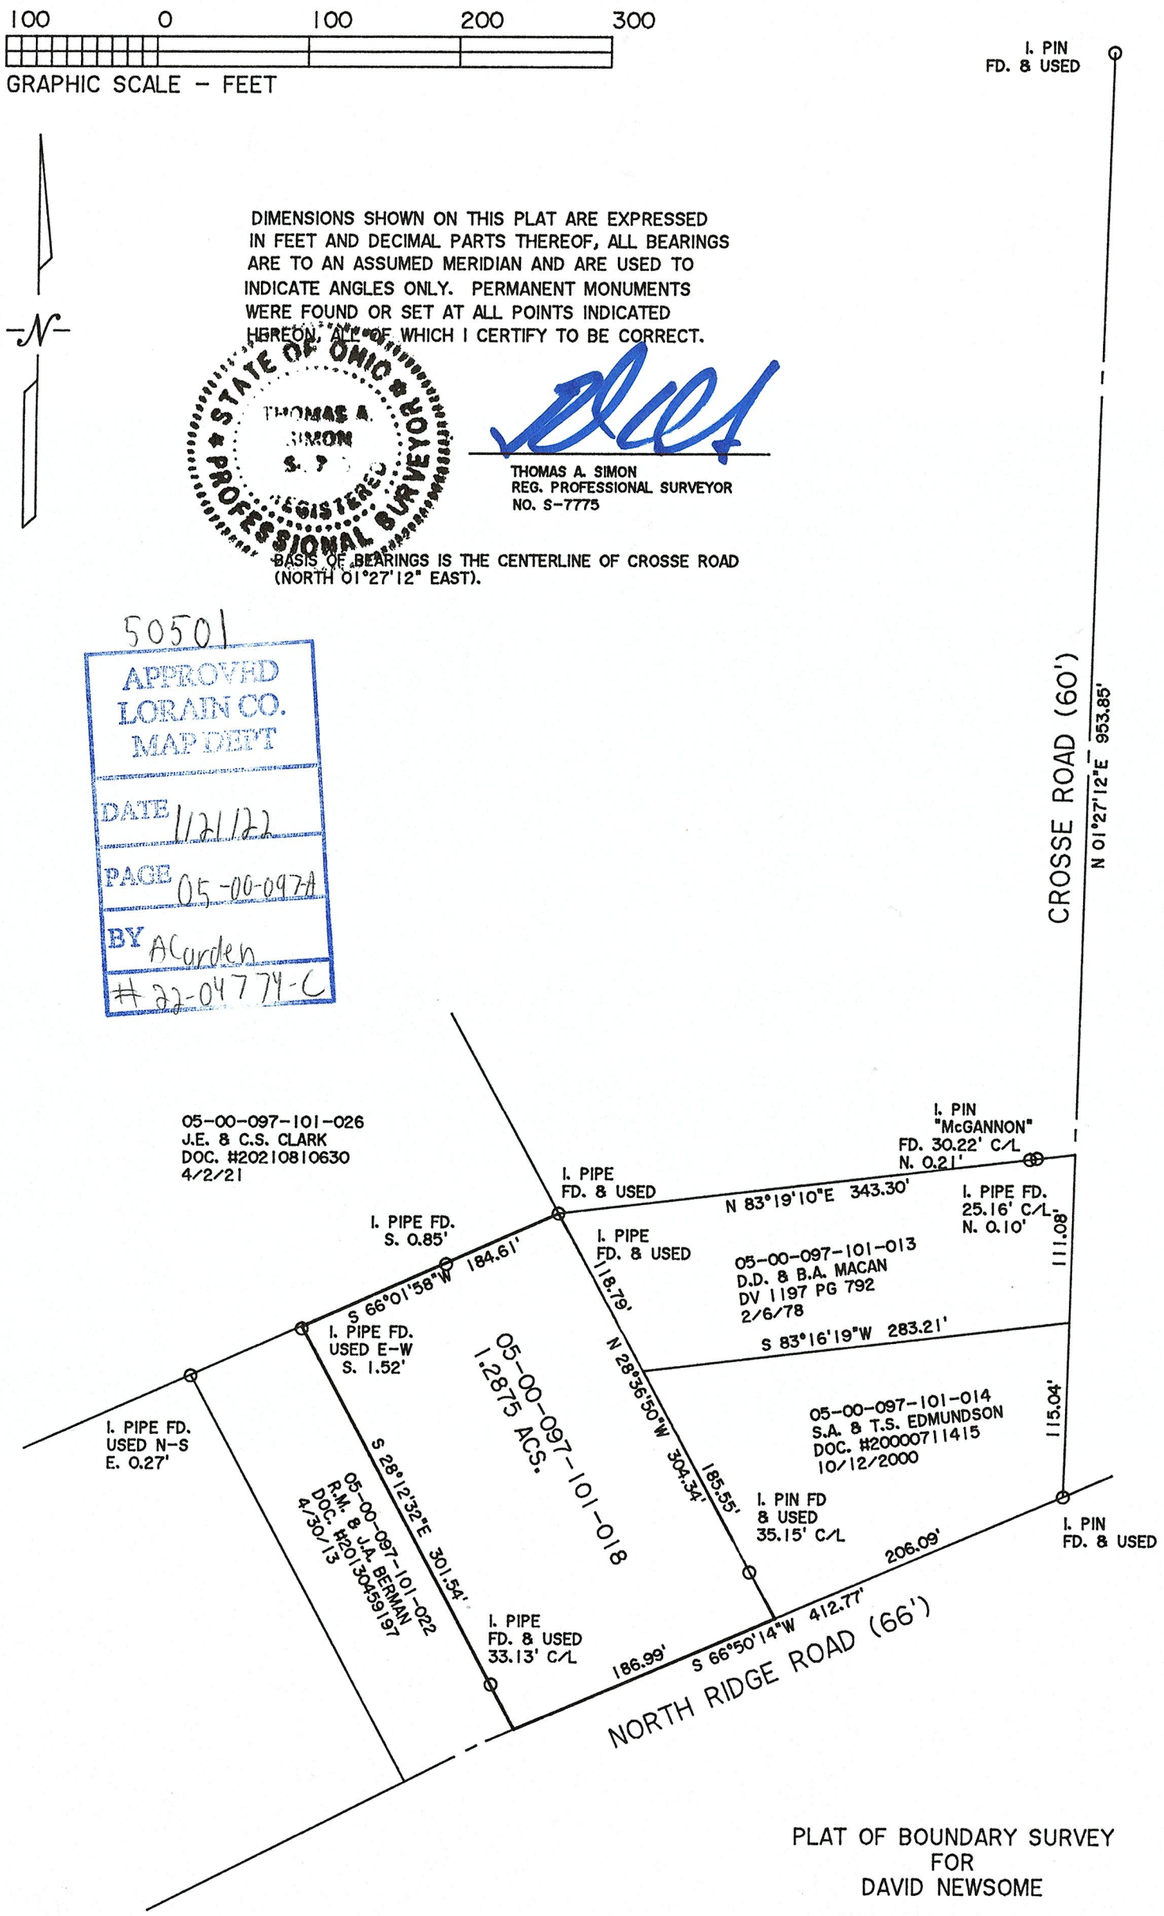

PLAT OF BOUNDARY SURVEY
FOR
DAVID NEWSOME

BEING KNOWN AS PART OF
ORIGINAL AMHERST TOWNSHIP
LOT NO. 97

CITY OF AMHERST COUNTY OF LORAIN
STATE OF OHIO

JANUARY, 2022 SCALE: 1" = 100'

THOMAS SIMON & ASSOCIATES, INC.
PROFESSIONAL LAND SURVEYORS

150 SOUTH OLIVE STREET
ELYRIA, OHIO 44035

(440) 327-2925
FAX 327-2964

JOB NO. 2022-001