



MAYFIELD AVENUE 50' (PLAT)

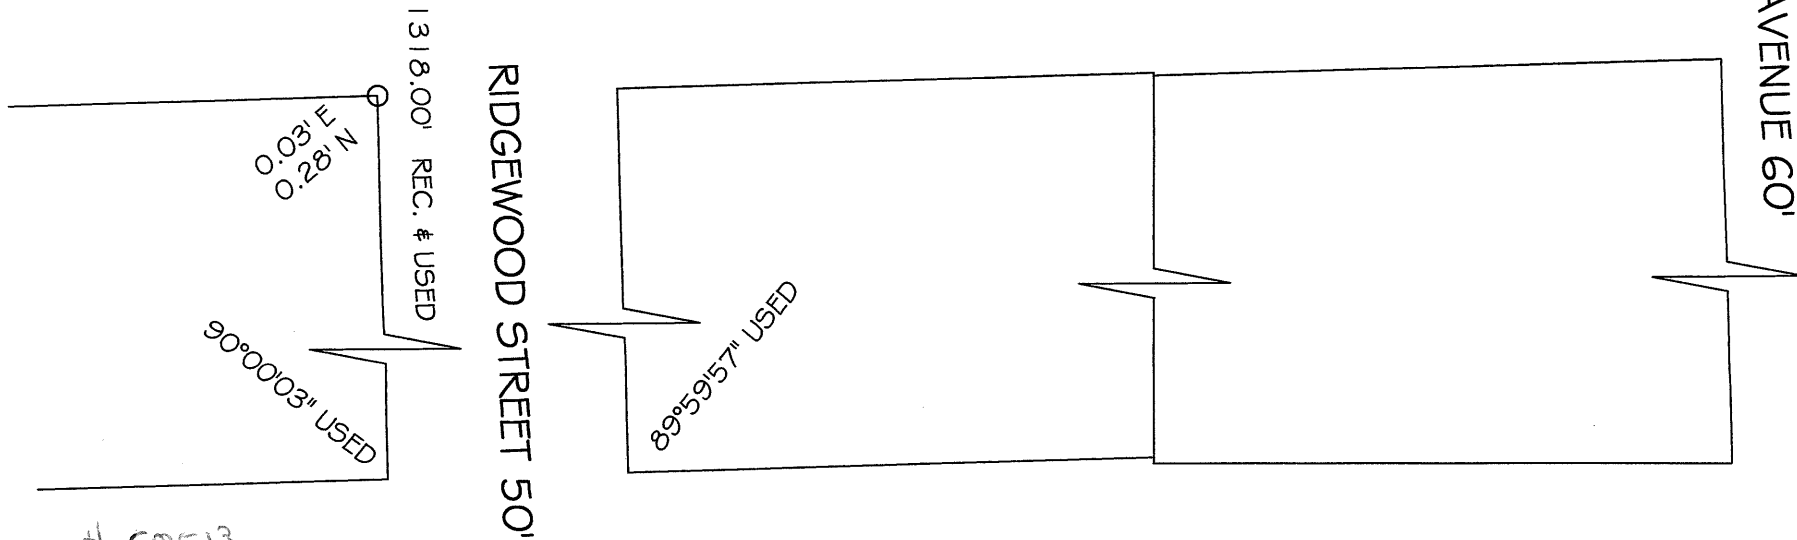

WILSON AVENUE 50' (PLAT)

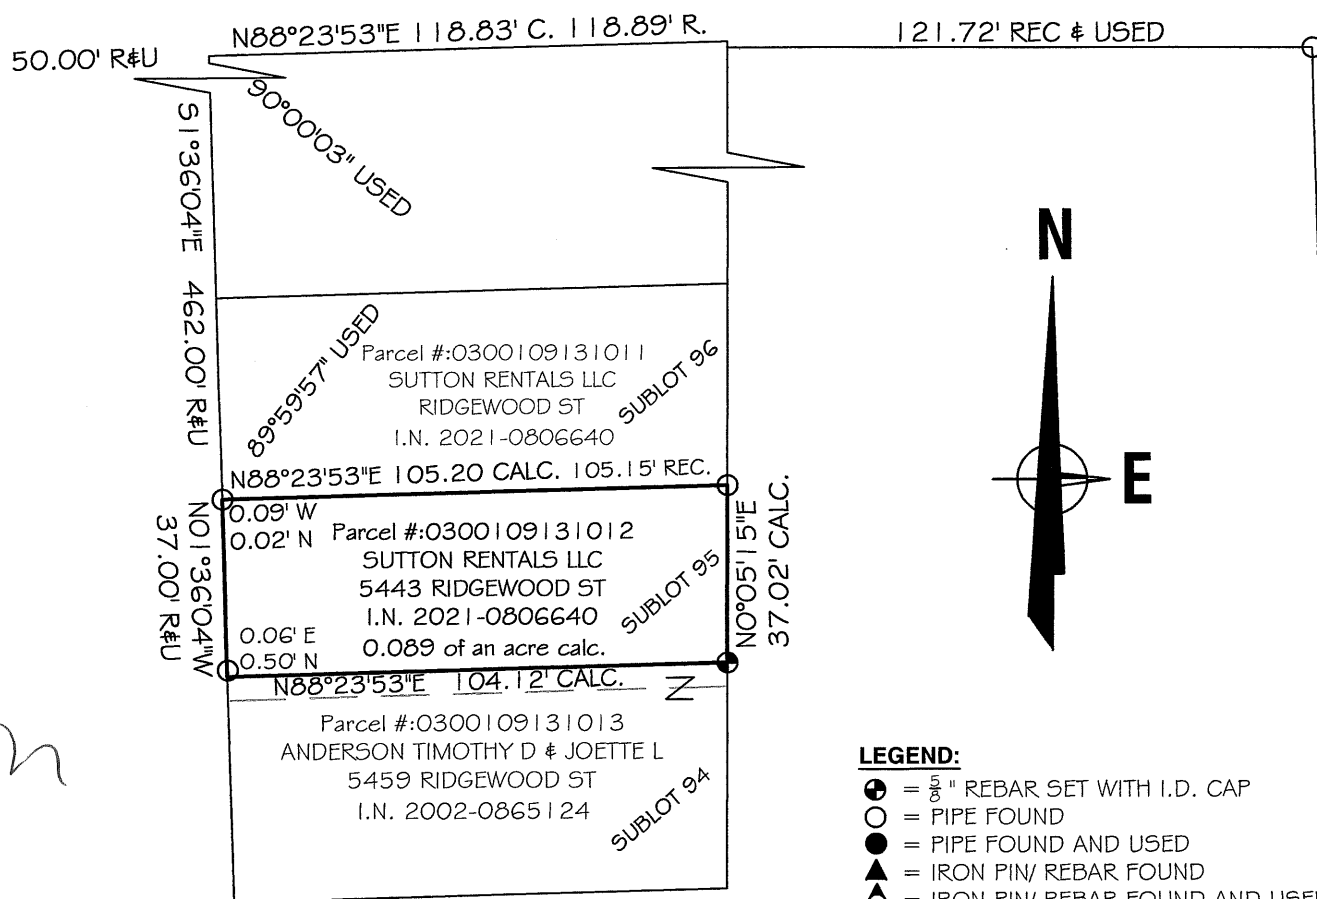


- LEGEND:**
- ⊙ = 5/8" REBAR SET WITH I.D. CAP
 - = PIPE FOUND
 - = PIPE FOUND AND USED
 - ▲ = IRON PIN/ REBAR FOUND
 - ▲ = IRON PIN/ REBAR FOUND AND USED
 - = MONUMENT BOX

Survey # 50513

APPROVED
LORAIN CO.
MAP DEPT

DATE 2-10-22
PAGE 03-00-109
BY O. Adelsberg

03-00-109-131-012

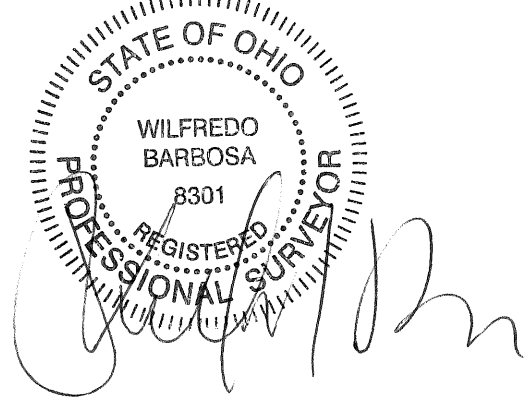

SCALE: 1" = 40'

PREPARED AT THE REQUEST OF:
SUTTON RENTALS, LLC
42857 NORTH RIDGE ROAD
ELYRIA, OHIO 44035

Survey
PARCELS 03-00-109-131-012
PART OF SUBLOT 95
COULTER AND SANFORD'S RIDGEWOOD ALLOTMENT
Plat Volume: 07 Page: 05
PART OF SHEFFIELD TWP ORIGINAL LOTS NO. 109
SHEFFIELD TOWNSHIP COUNTY OF LORAIN
STATE OF OHIO

BARBOSA AND ASSOCIATES LLC
5604 CASE ROAD
NORTH RIDGEVILLE, OH 44039
440 327-4776

1/24/2022	CHECKED BY:WB
JOB No: 2021-12-2	SHEET 1 of 1