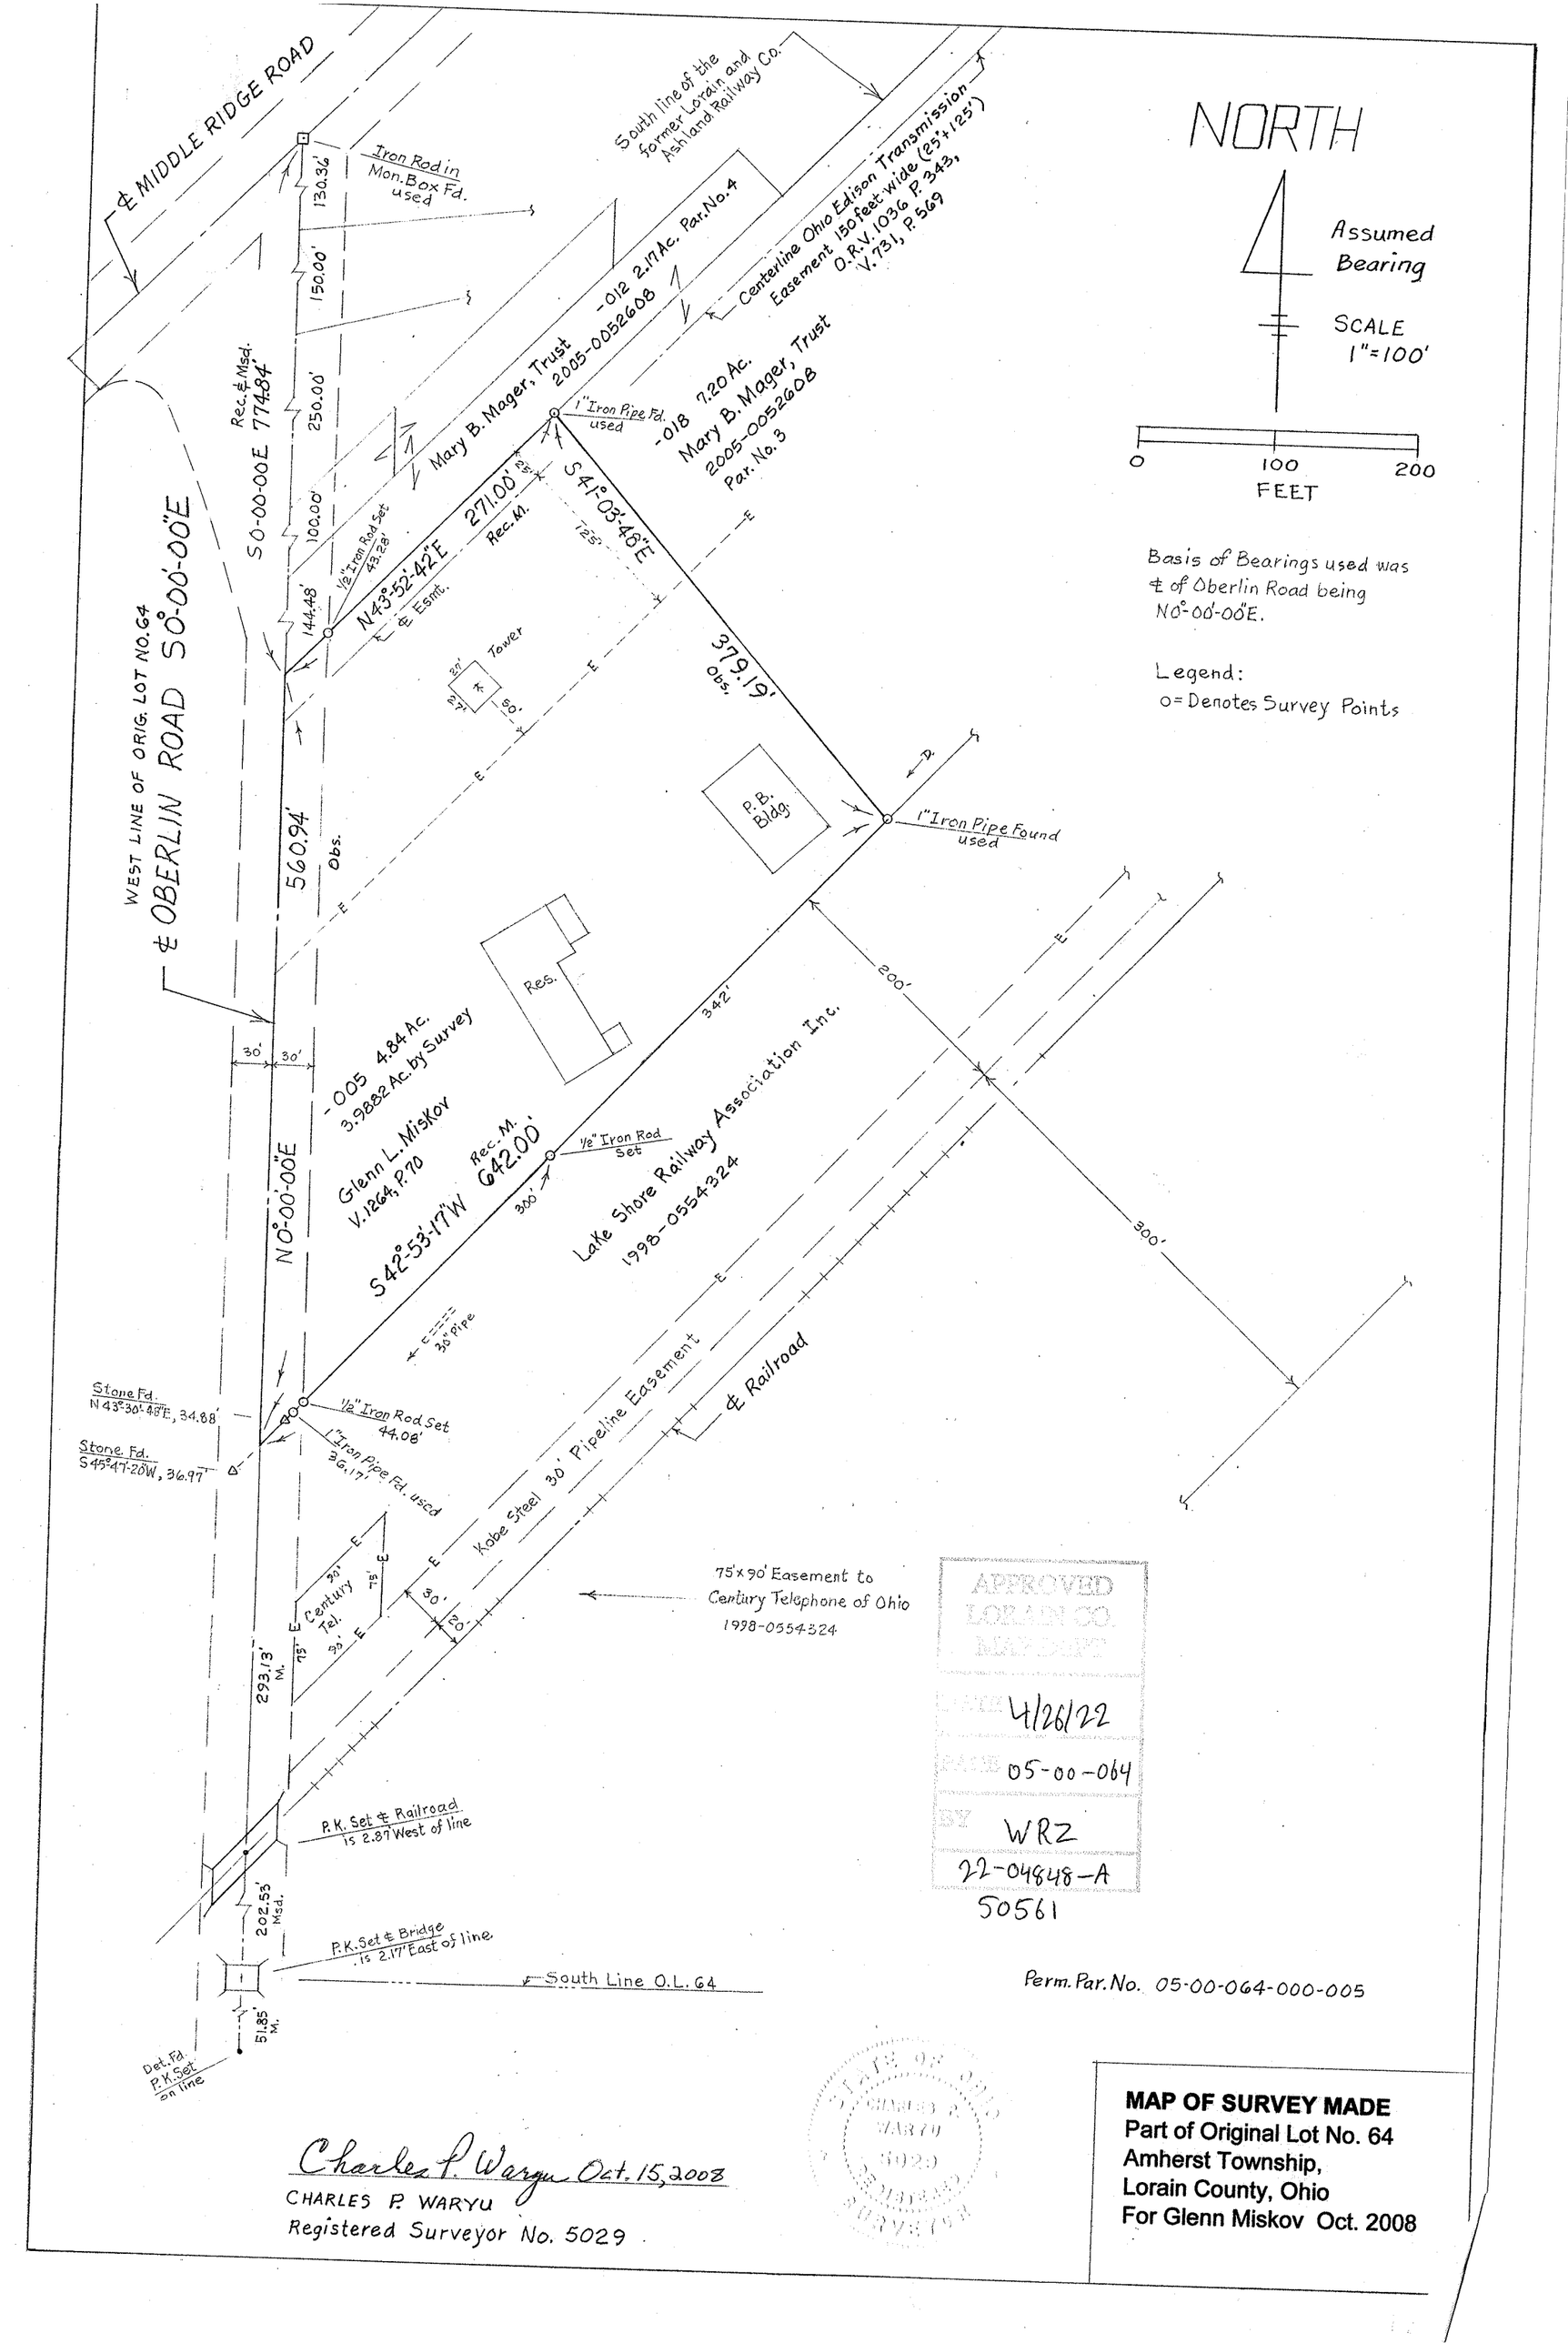

Charles P. Waryu Oct. 15, 2008

CHARLES P. WARYU
Registered Surveyor No. 5029

STATE OF OHIO
CHARLES P. WARYU
5029
REGISTERED SURVEYOR

MAP OF SURVEY MADE
Part of Original Lot No. 64
Amherst Township,
Lorain County, Ohio
For Glenn Miskov Oct. 2008