



Note: Bearings and Coordinates shown are based on the Ohio State Plane (Grid North).  
 Shot are used to describe angles only.


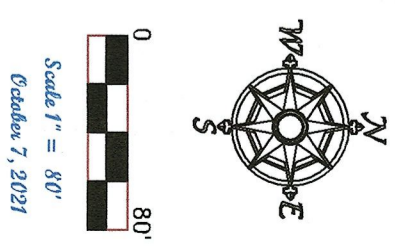

Point	Table
30	DESE
1	TRC N 93 N SWLN'D
25	TRC N 93 N SWLN'D
27	TRC N 93 N SWLN'D bent
28	TRC N 93 N SWLN'D bent
31	TRC N 93 N SWLN'D
33	fence post
35	fence post
37	fence post
38	TRC N 93 N SWLN'D
46	REGRAR
47	REGRAR
48	REGRAR
49	REGRAR
50	REGRAR
51	REGRAR
58	TRC N 93 N SWLN'D
59	TRC N 93 N SWLN'D
66	REGRAR
67	TRC N 93 N SWLN'D
68	REGRAR
87	TRC N 93 N SWLN'D
89	REGRAR SEG
90	REI
91	REI
92	REI
93	REI
94	REI
95	REI
104	REGRAR SEG
105	REGRAR SEG
106	REGRAR SEG

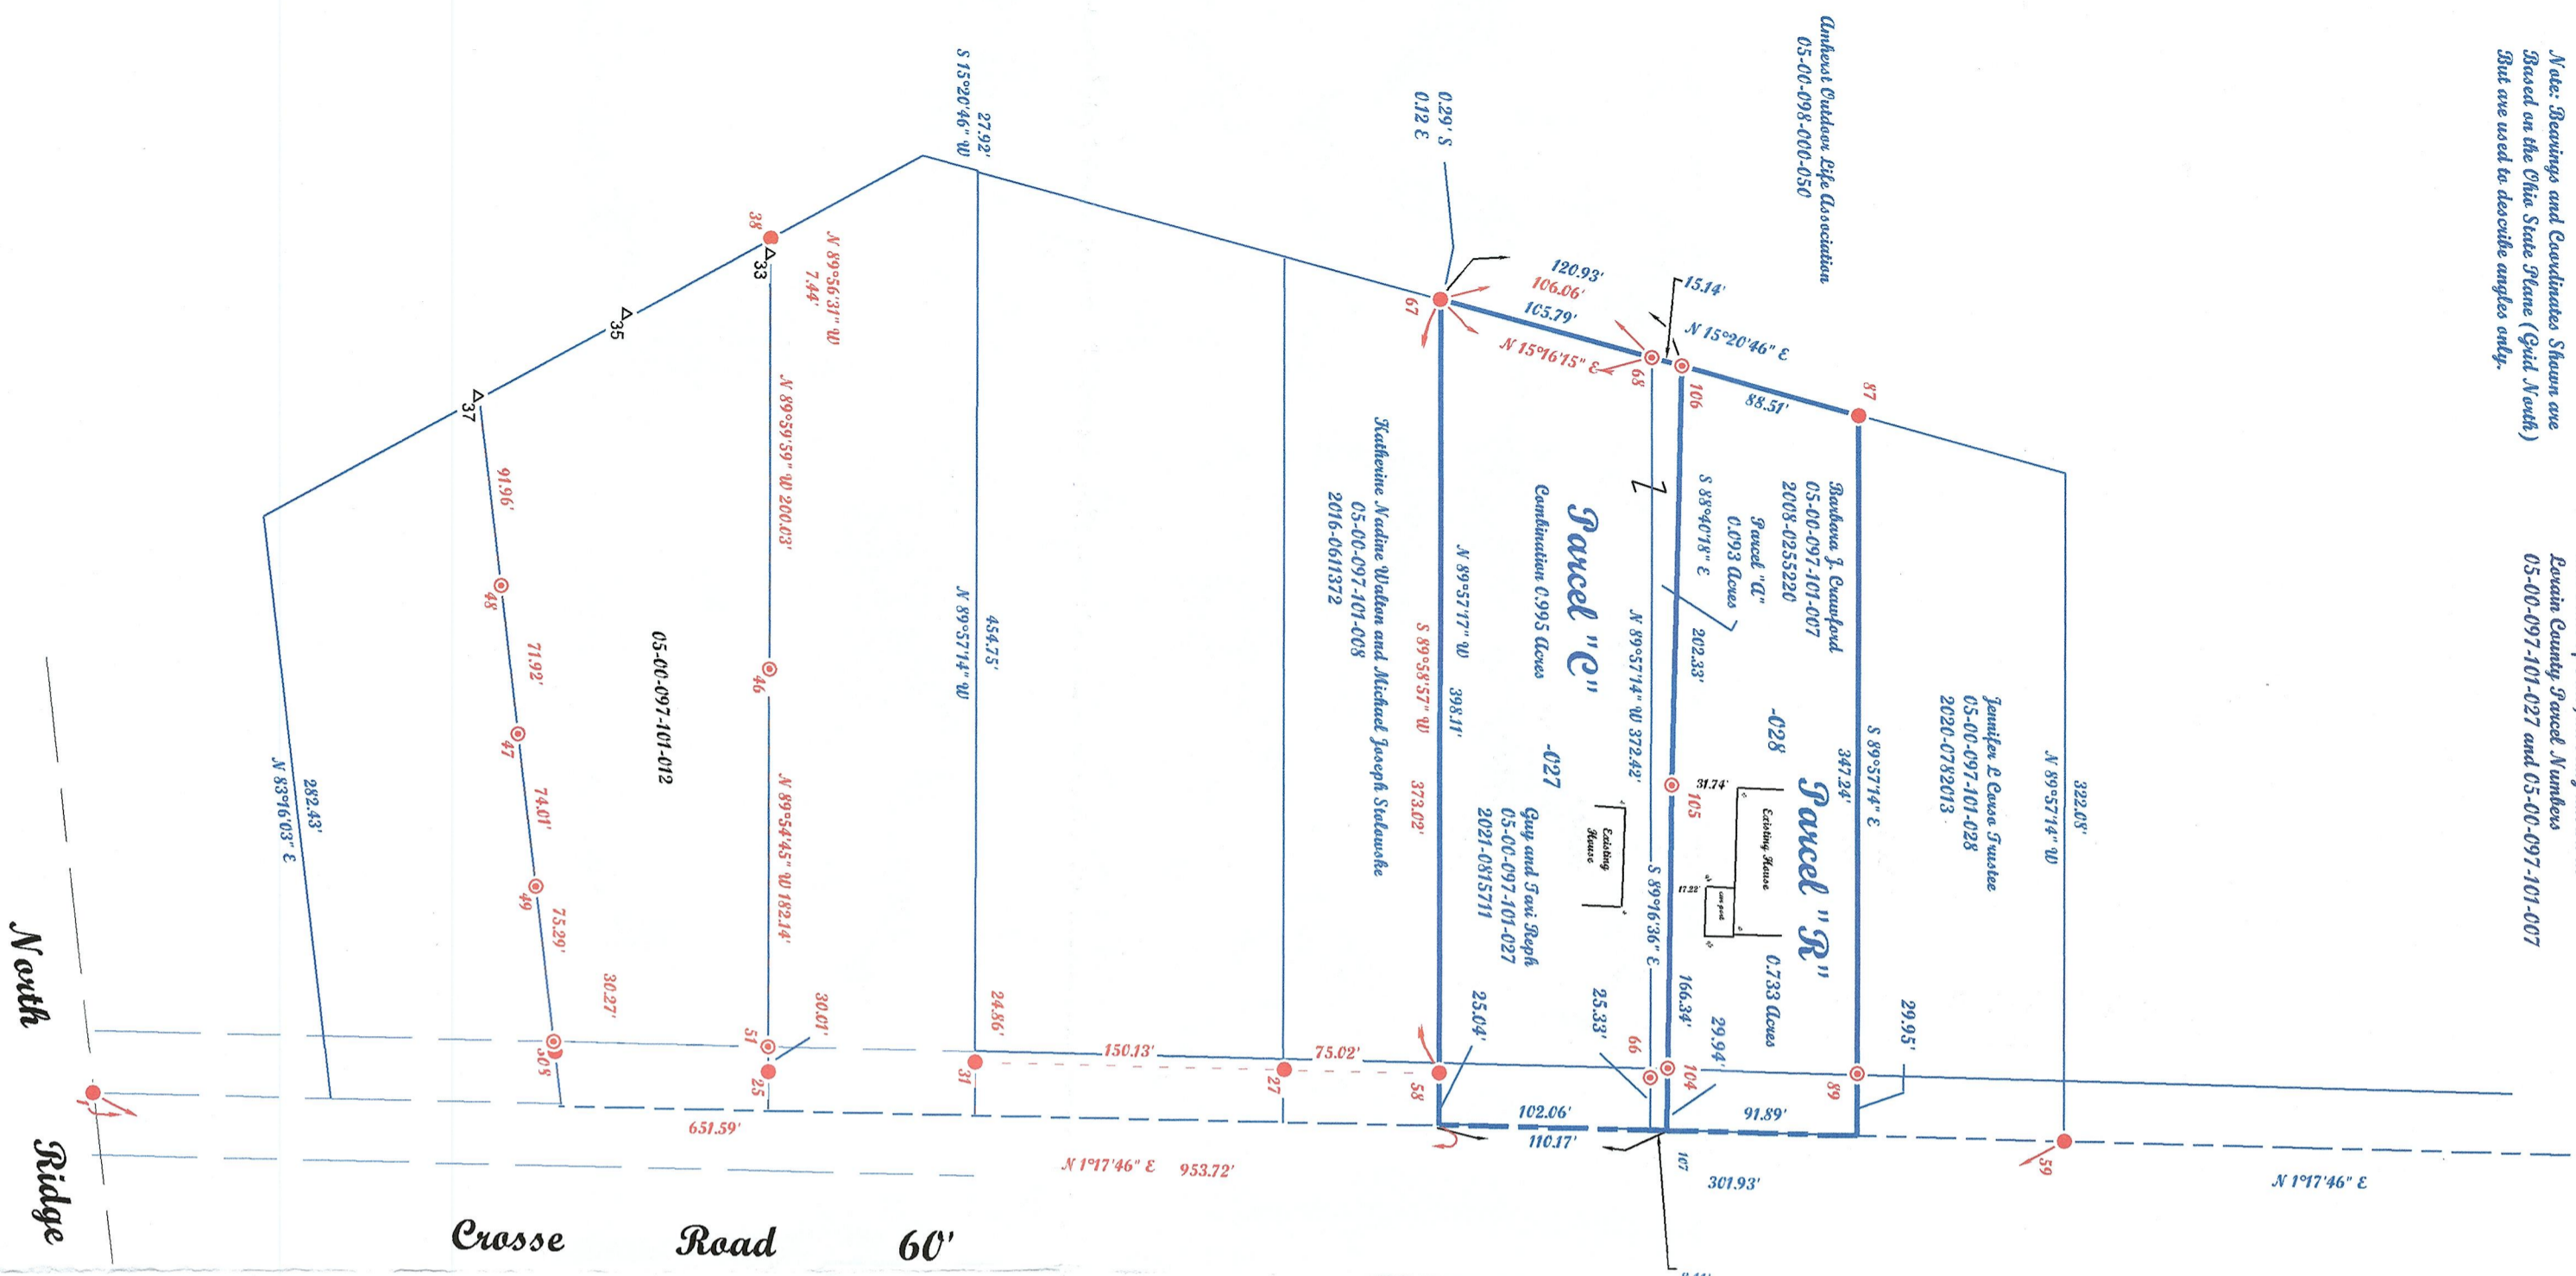

50621  
 APPROVED  
 LORAN CO.  
 MAR 2021  
 DATE 6/29/22  
 PAGE 05-00-097-101-012  
 BY A. Warden  
 22-04515

Note: Only copies signed with Seal info shall be considered Valid.

*Patrick A. McGannan*  
 Patrick A. McGannan, S.S. 7154.

Approved  
 Amherst Planning Commission

*[Signature]*  
 11-10-21  
 Date

Boundary Survey  
 McGannan Surveying, LLC  
 Patrick A. McGannan  
 Registered Professional Surveyor  
 1731 Gethysburg Drive, Leominster, Ohio 44053 (440) 282-2712  
 www.mcannansurveying.com

Prepared for Charles B. Gaultich of 200 Crosse Road, Linbeck, Ohio 44001.

Note: Dimensions shown in blue are record values and those shown in red are field observed.