


# LOT SPLIT & CONSOLIDATION SURVEY

SITUATED IN THE TOWNSHIP OF GRAFTON, COUNTY OF LORAIN, STATE OF OHIO AND  
 KNOWN AS BEING PART OF ORIGINAL GRAFTON TOWNSHIP LOT 94

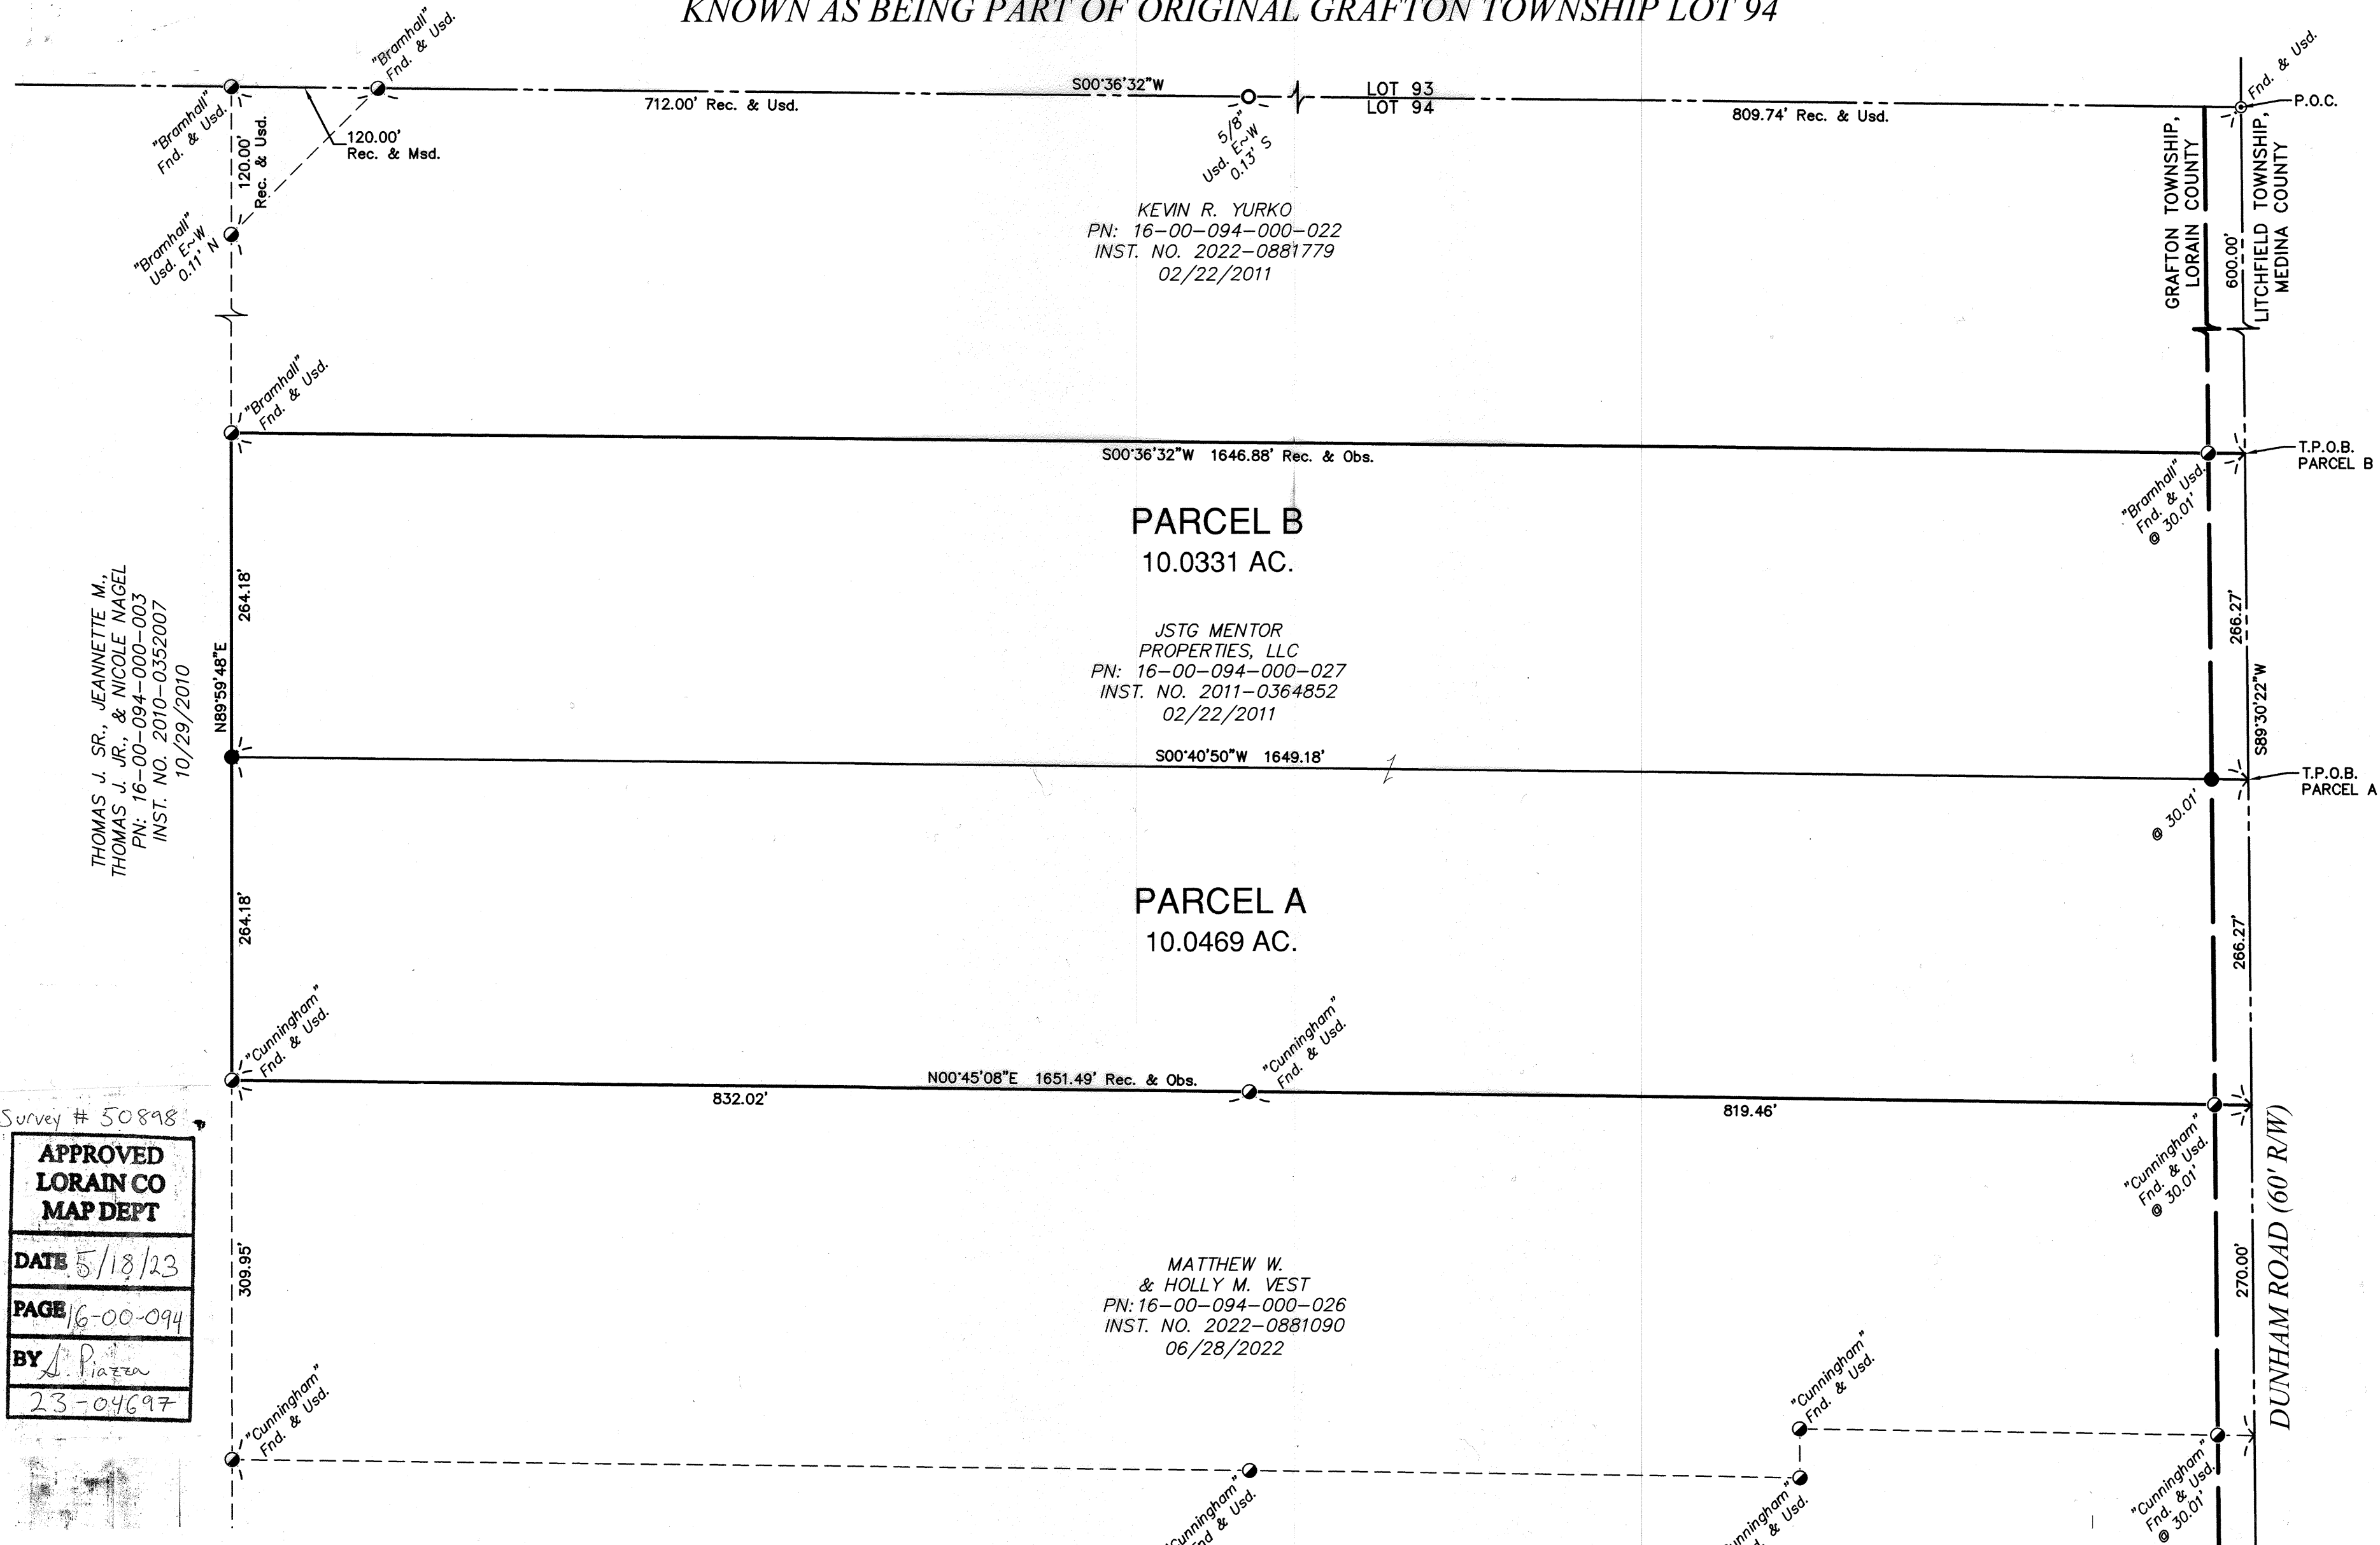

LOT SPLIT & CONSOLIDATION SURVEY

STATE OF OHIO  
 COUNTY OF LORAIN

CUNNINGHAM & ASSOCIATES, INC.  
 CIVIL ENGINEERING and SURVEYING  
 203 W. LIBERTY ST. MEDINA, OHIO 44256 330-725-5980

CITY: GRAFTON  
 TOWNSHIP: GRAFTON  
 TRACT: 94  
 LOT NUMBER: 94  
 PROP OWNER: JSTG MENTOR PROPERTIES, LLC

DRAWN BY: SG  
 DATE: 03/02/2023  
 CHECKED BY: DSL  
 DATE: 03/03/2023  
 PROJECT No. 23-117

ACAD FILE No. 23-117 Plat 01  
 SCALE: 1"=100'

SHEET NO. 1/1