

WEST 19TH STREET 50'

589°39'00"E

2.74' N
589°39'00"E
50.00' R#U
2.63' N

0.32' W
0.22' N

25.00' R#U

48.92' R#U

25.00' R#U

12.5' c. 37.50' R#U

37.50' R#U

37.50' R#U

37.50' R#U

56.25' R.

Parcel 02-02-024-115-061
SCOTT SANDRA M TRUSTEE
1935 W 19TH ST LORAIN,
OH 44052
2022-0887632

Parcel #:0202024115064
SPENCER ELEANOR
1923 W 19TH ST LORAIN, OH 44052

N00°00'00"E 159.50' R#U

N00°21'00"E 159.50' R#U

N00°21'00"E 159.50' R#U

SUBLOT 30

SUBLOT 29

SUBLOT 28

SUBLOT 27

SUBLOT 26

SUBLOT 25

SUBLOT 24

589°39'00"E
50.00' R#U

0.22' S
0.93' W

0.13' N
0.43' W

N00°00'00"E 159.50' R#U

SUBLOT 31

SUBLOT 32

SUBLOT 33

SUBLOT 34

SUBLOT 35

SUBLOT 36

SUBLOT 37

REEVES AVENUE

33.00'



WEST 20TH STREET 50'

50.00' R#U

7.00' R#U

50940

APPROVED
LORAIN CO
MAP DEPT

DATE 7/12/23

PAGE 02-02-024

BY ACorden




LEGEND:

- = 5/8" REBAR SET WITH I.D. CAP
- = DRILL HOLE FND
- = PIPE FOUND
- ▲ = IRON PIN/ REBAR FOUND
- ▲ = IRON PIN/ REBAR FOUND AND USED
- = MONUMENT BOX

WEST 21ST STREET 66'

SCALE: 1" = 40'

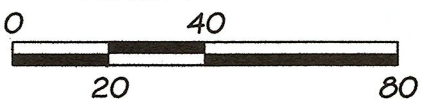

PREPARED AT THE REQUEST OF:
Sandra Scott

3852 Ashland Avenue, Lorain, Ohio 44053

Survey

02-02-024-115-062
SUBLOT 28 & PART OF SUBLOT 29
POLE AND REEVES CITY ACRES ADDITION
BLACK RIVER TOWNSHIP, TRACT 2
PLAT VOL. 12 PAGE 15
CITY OF LORAIN COUNTY OF LORAIN
STATE OF OHIO

BARBOSA AND ASSOCIATES LLC

5604 CASE ROAD
NORTH RIDGEVILLE, OH 44039
440 327-4776

11/28/2022

CHECKED BY:WB

SHEET 1 of 1