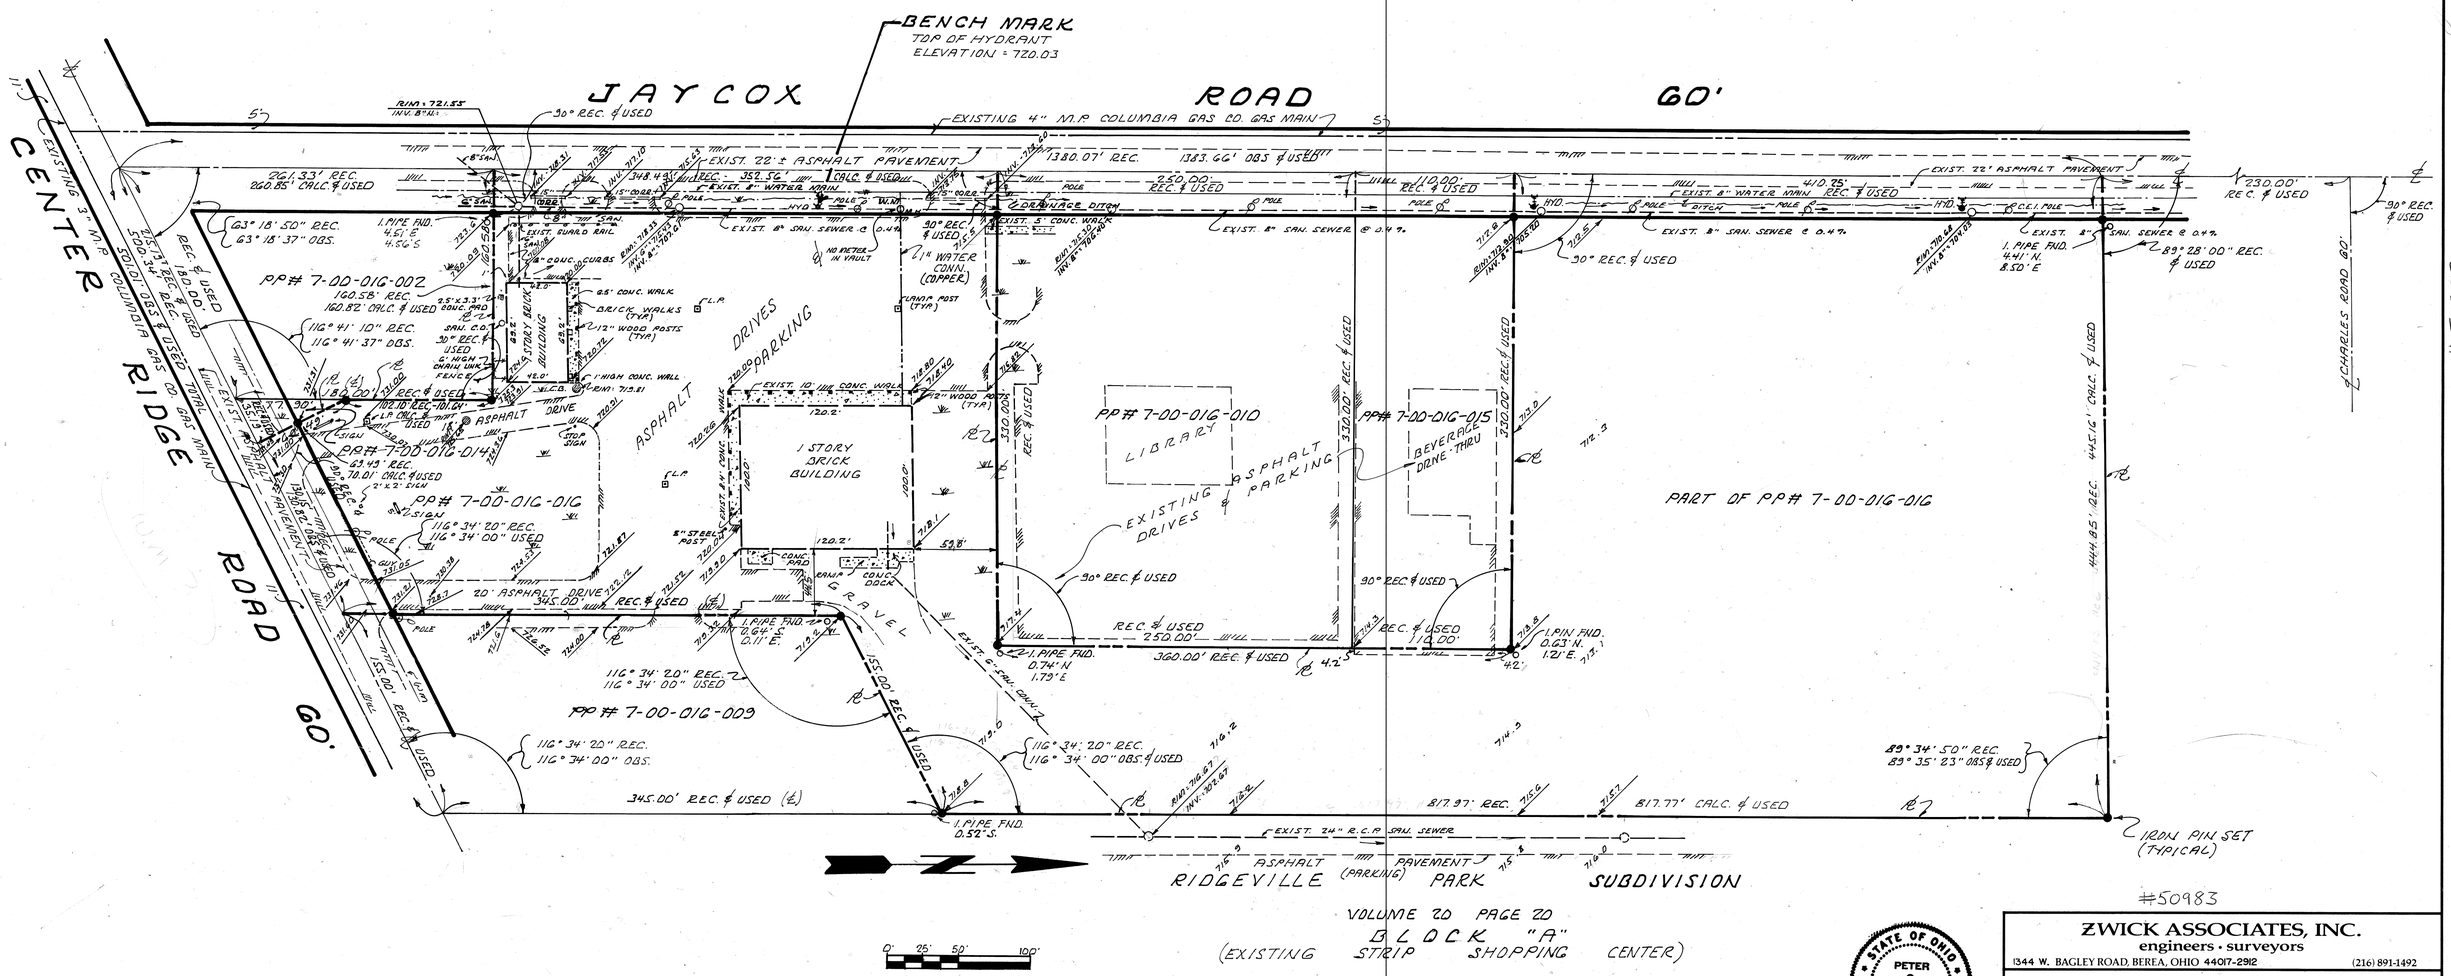


#50983

STATE OF OHIO
PETER C. ZWICK
S-4929
REGISTERED SURVEYOR

**ZWICK ASSOCIATES, INC.**
engineers • surveyors
1344 W. BAGLEY ROAD, BEREA, OHIO 44017-2912 (216) 891-1492

# TOPOGRAPHICAL MAP FOR NORTHVIEW VILLAGE PHASE IN THE CITY OF NORTH RIDGEVILLE, OHIO

| | | | | | |
|---|---|---|---|---|---|
| DESIGNED | P.C.Z. | DRAWN | R.P.P. | CHECKED | P.C.Z. |
| DATE | JULY, 1994 | REVISED | | SCALE | AS NOTED |